


NOTE:
1. FOR NOTES AND LEGEND, SEE SHEET SM-01

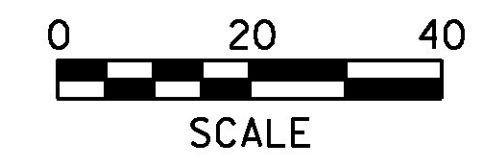

PROJECT NAME:	RUTLAND CITY
PROJECT NUMBER:	STP 019-3(57)
FILE NAME: ...\PlotFiles\rut_s+pvtplan.dgn	PLOT DATE: 7/12/2013
PROJECT LEADER: GAE	DRAWN BY: PZA
DESIGNED BY: TFD	CHECKED BY: GAE
SIGNING & MARKING PLAN SM-08	
SHEET 350 OF 392	