



SEE REVISED SHEET 361A

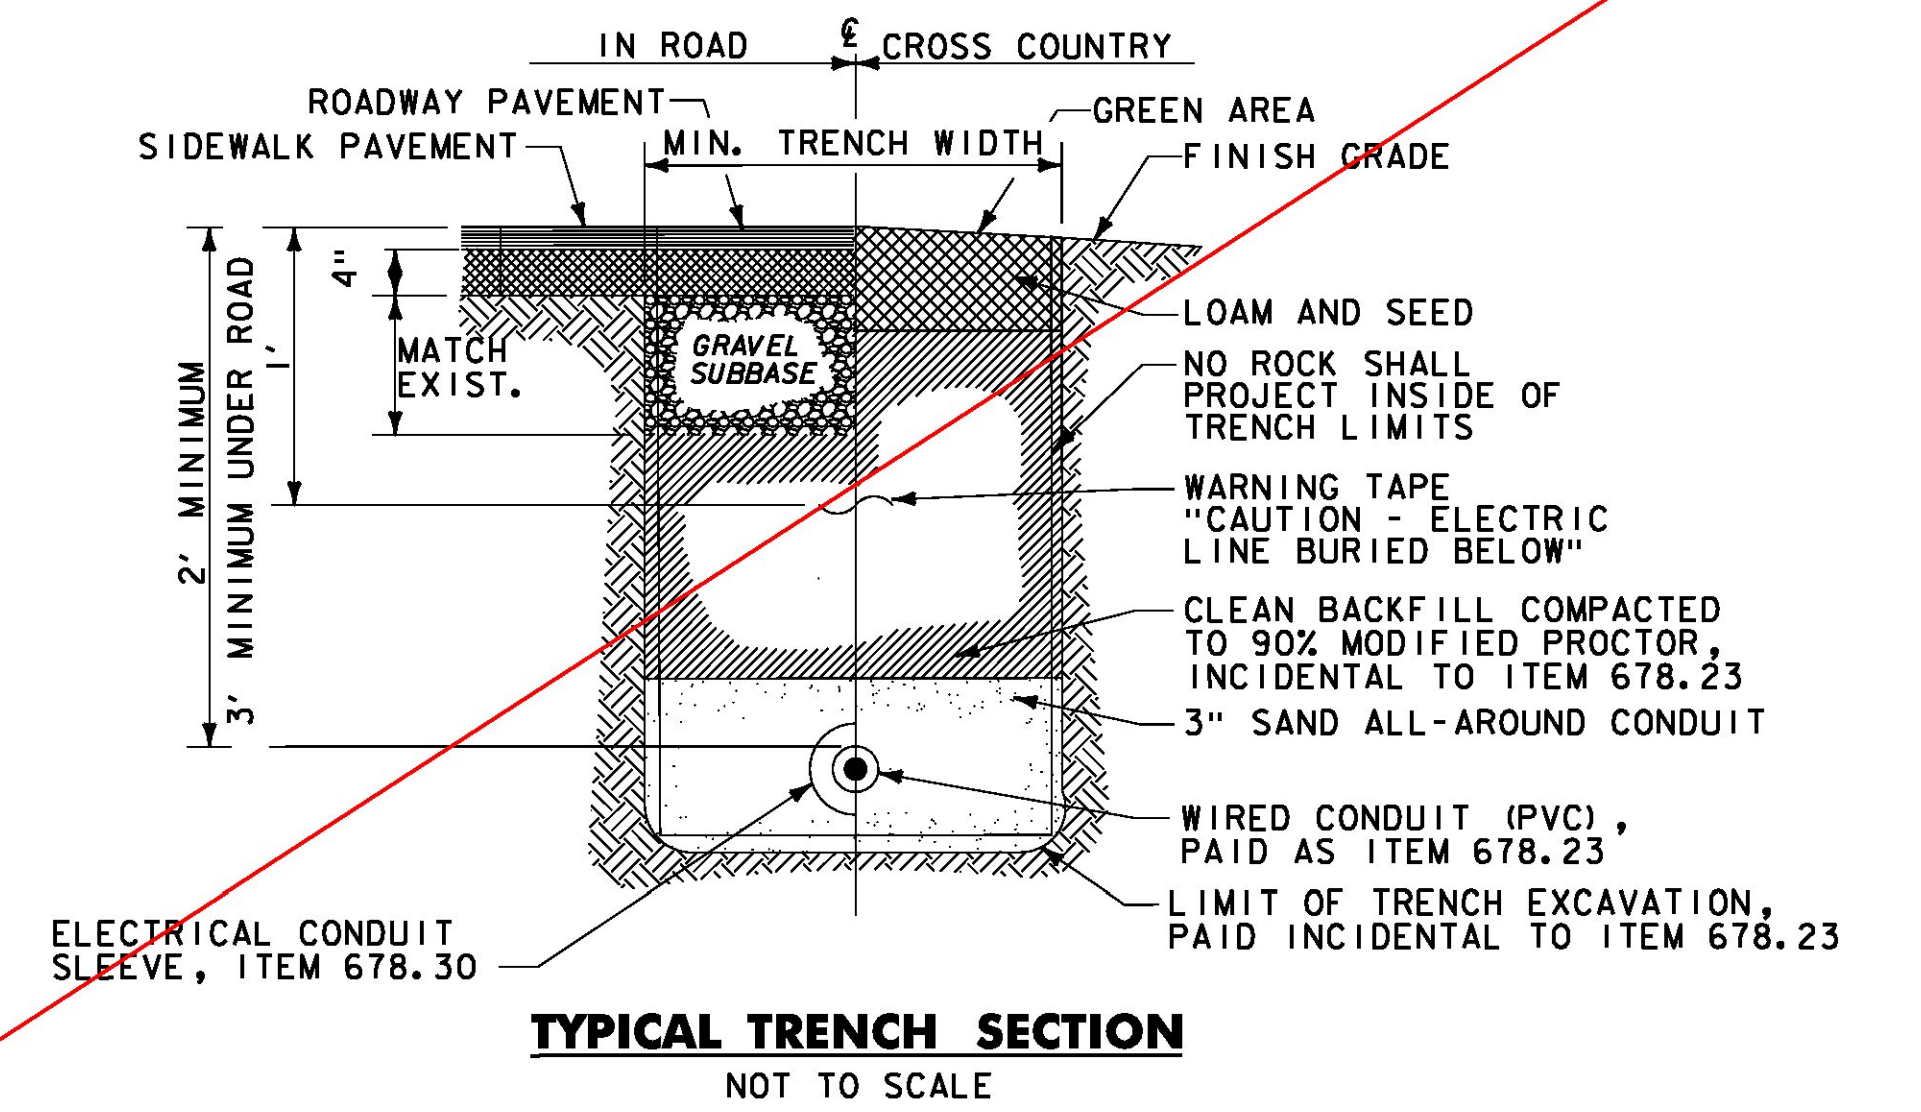


NOTE:


PVC CONDUITS SHALL PASS THROUGH SLEEVES BENEATH ALL PAVED SURFACES. SLEEVES SHALL BE PAID AS ITEM 678.30. PROVIDE 3" CONCRETE ENCASEMENT AROUND SLEEVES TO 5' BEYOND EDGE OF PAVEMENT, TYPICAL. CONCRETE PAID INCIDENTAL TO ITEM 678.30.

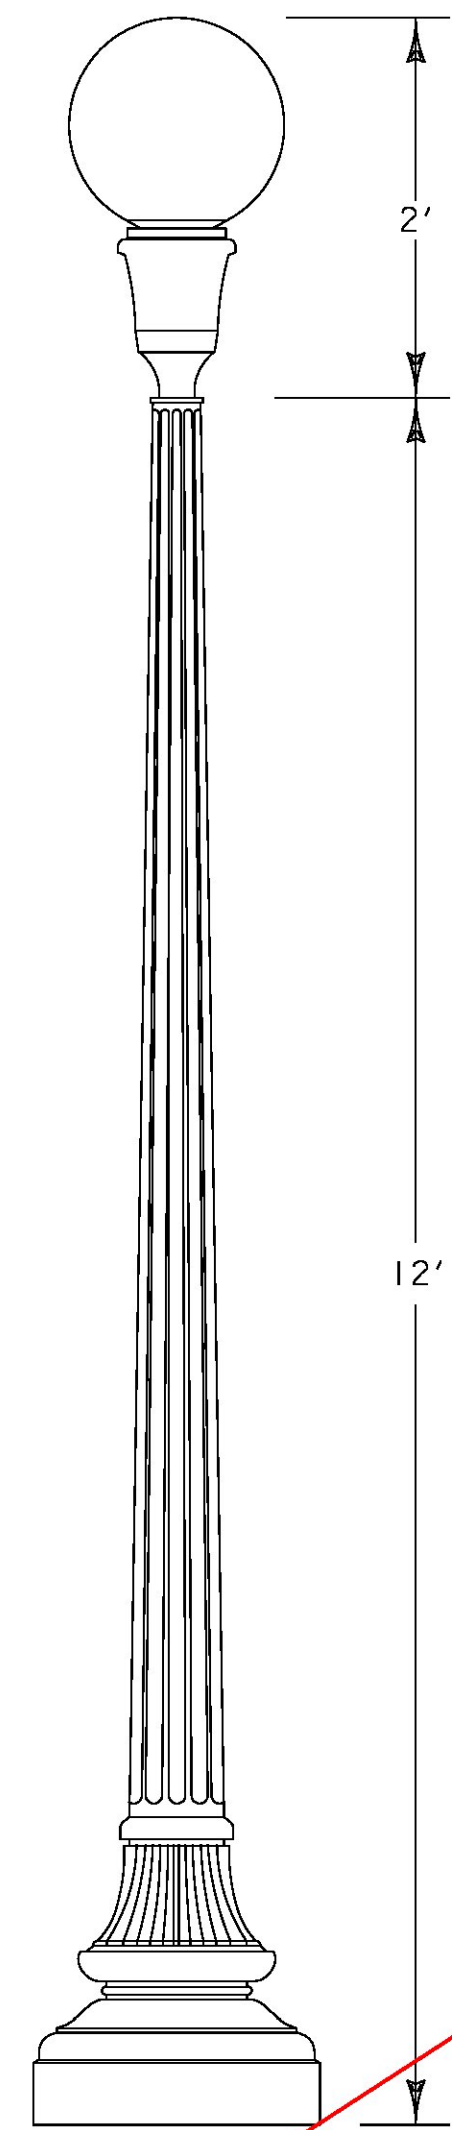


TYPE 'A' STREET LIGHT DETAIL

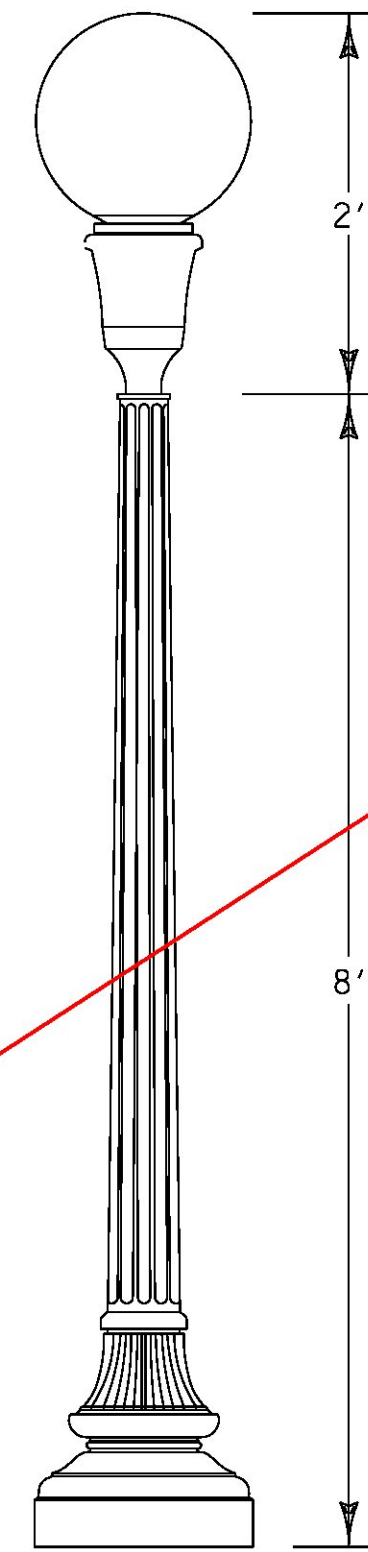

TYPE 'B' STREET LIGHT DETAIL

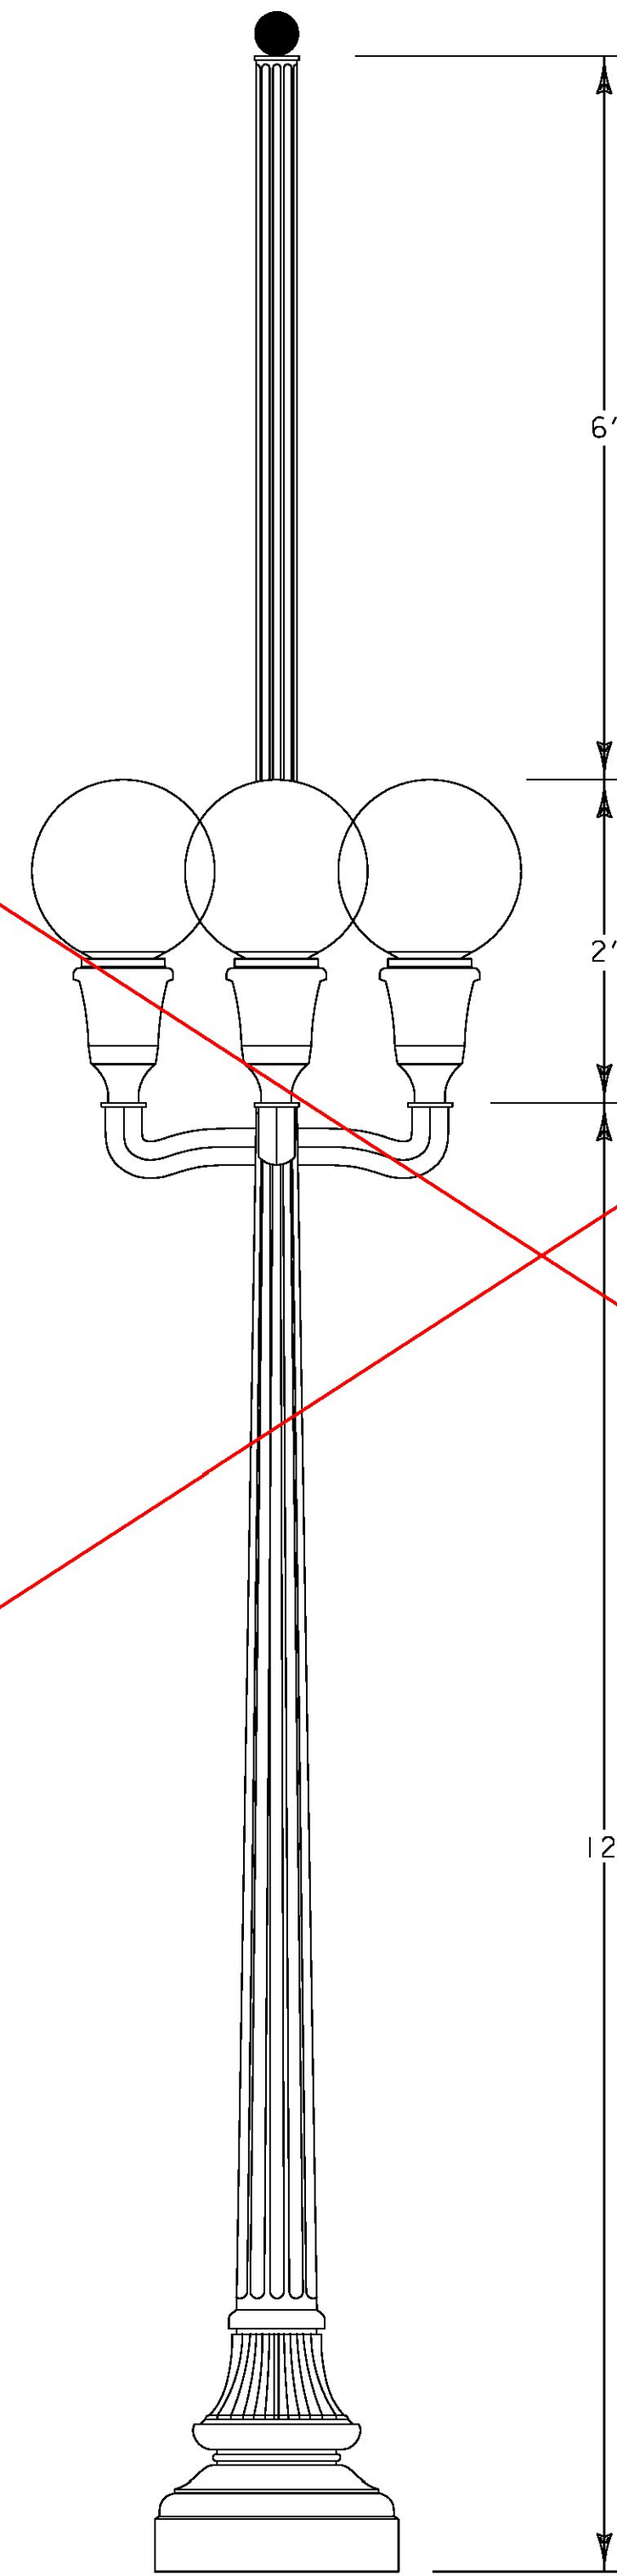

TYPE 'C' STREET LIGHT DETAIL

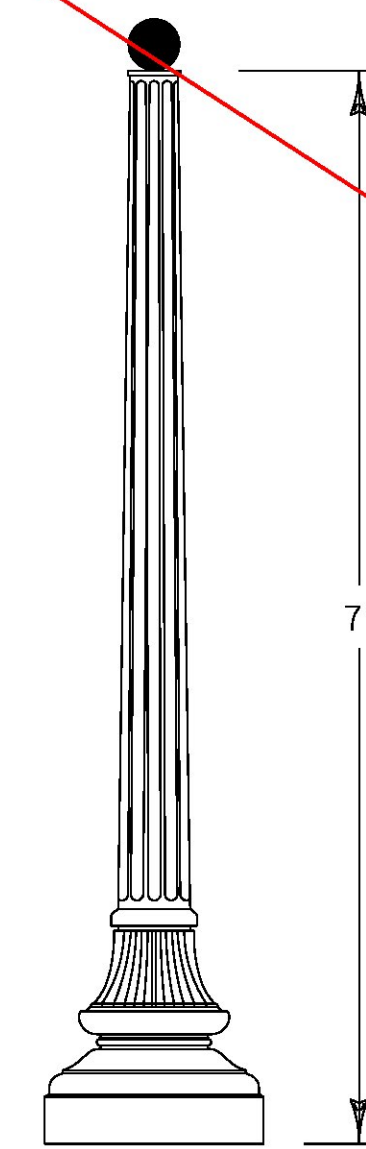

TYPE 'D' POLE DETAIL

LIGHTING GENERAL NOTES:

1. ALL INFORMATION PERTINENT TO THE CONSTRUCTION OF THE LIGHTING SYSTEM CAN BE FOUND IN THE PROJECT SPECIAL PROVISIONS.
2. ACCEPTABLE MANUFACTURERS SHALL INCLUDE, BUT ARE NOT LIMITED TO:
 - HOLOPHANE, PRISMOSPHERE LED
 - BEACON LIGHTING
 - ANP LIGHTING
 - STERNBERG LIGHTING
 - OR APPROVED EQUAL
3. ALL POLES SHALL BE WASHINGTON STYLE IN ANTIQUE BLACK.
4. POLE FOUNDATIONS SHALL BE CONSTRUCTED IN ACCORDANCE WITH VTRANS STANDARD E-180B.

PROJECT NAME: RUTLAND CITY	PLOT DATE: 7/12/2013
PROJECT NUMBER: STP 019-3(57)	DRAWN BY: PZA
FILE NAME: ...\\PlotFiles\\rut_lgt_det.dgn	CHECKED BY: GAE
PROJECT LEADER: GAE	DESIGNED BY: TFD
DESIGNED BY: TFD	CHECKED BY: GAE
LIGHTING DETAIL LGD-01	SHEET 361 OF 392

