


TYPE 'A' STREET LIGHT DETAIL

TYPE 'B' STREET LIGHT DETAIL

TYPE 'C' STREET LIGHT DETAIL

TYPE 'D' POLE DETAIL

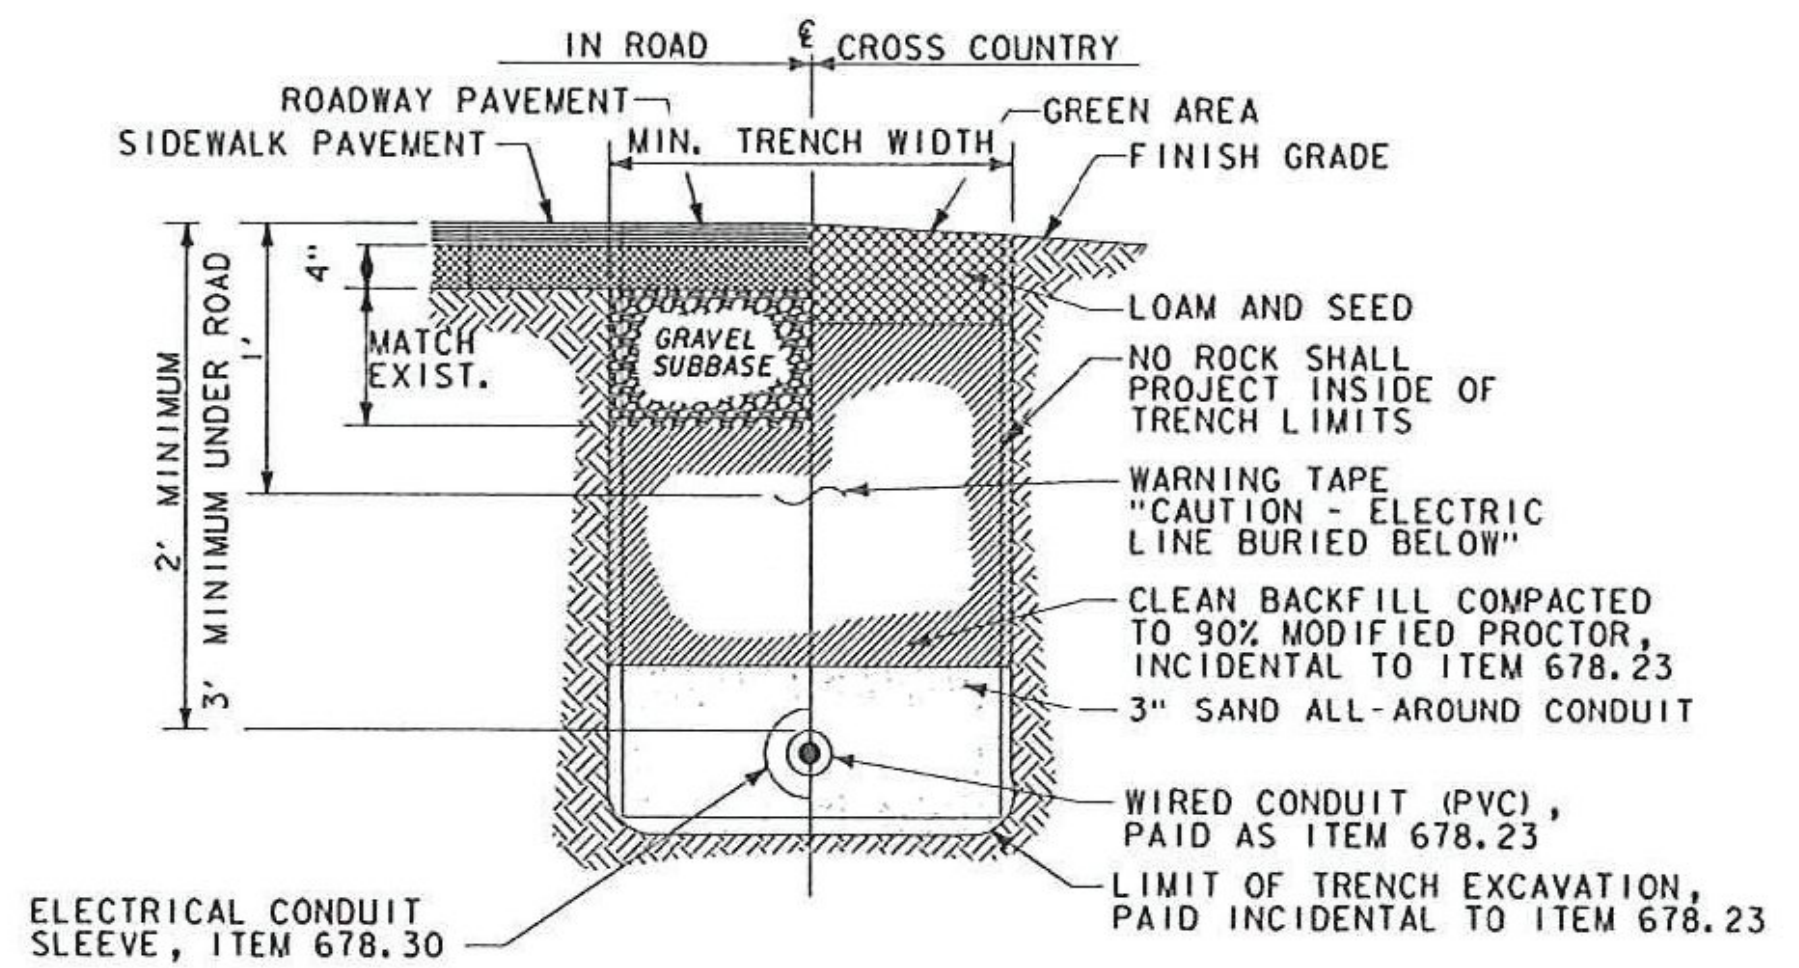

TYPICAL TRENCH SECTION
NOT TO SCALE

NOTE:

PVC CONDUITS SHALL PASS THROUGH SLEEVES BENEATH ALL PAVED SURFACES. SLEEVES SHALL BE PAID AS ITEM 678.30. PROVIDE 3" CONCRETE ENCASEMENT AROUND SLEEVES TO 5" BEYOND EDGE OF PAVEMENT, TYPICAL. CONCRETE PAID INCIDENTAL TO ITEM 678.30.



LIGHTING GENERAL NOTES:

1. ALL INFORMATION PERTINENT TO THE CONSTRUCTION OF THE LIGHTING SYSTEM CAN BE FOUND IN THE PROJECT SPECIAL PROVISIONS.
2. ACCEPTABLE MANUFACTURERS SHALL INCLUDE, BUT ARE NOT LIMITED TO:
 - HOLOPHANE, PRISMASPHERE LED
 - BEACON LIGHTING
 - ANP LIGHTING
 - STERNBERG LIGHTING
 - OR APPROVED EQUAL
3. ALL POLES SHALL BE WASHINGTON STYLE IN ANTIQUE BLACK.
4. POLE FOUNDATIONS SHALL BE CONSTRUCTED IN ACCORDANCE WITH VTRANS STANDARD E-180B.

REVISION	BY	DATE
△ CONDUIT AND LIGHTING REMOVED FROM CONTRACT	TFD	11/05/13



PROJECT NAME: RUTLAND CITY	PLOT DATE: 11/5/2013
PROJECT NUMBER: STP 019-3(57)	DRAWN BY: PZA
FILE NAME: ...rvt.lgt.det.dgn	CHECKED BY: GAE
PROJECT LEADER: GAE	SHEET 36 A OF 392
DESIGNED BY: TFD	
LIGHTING DETAIL LGD-01	