

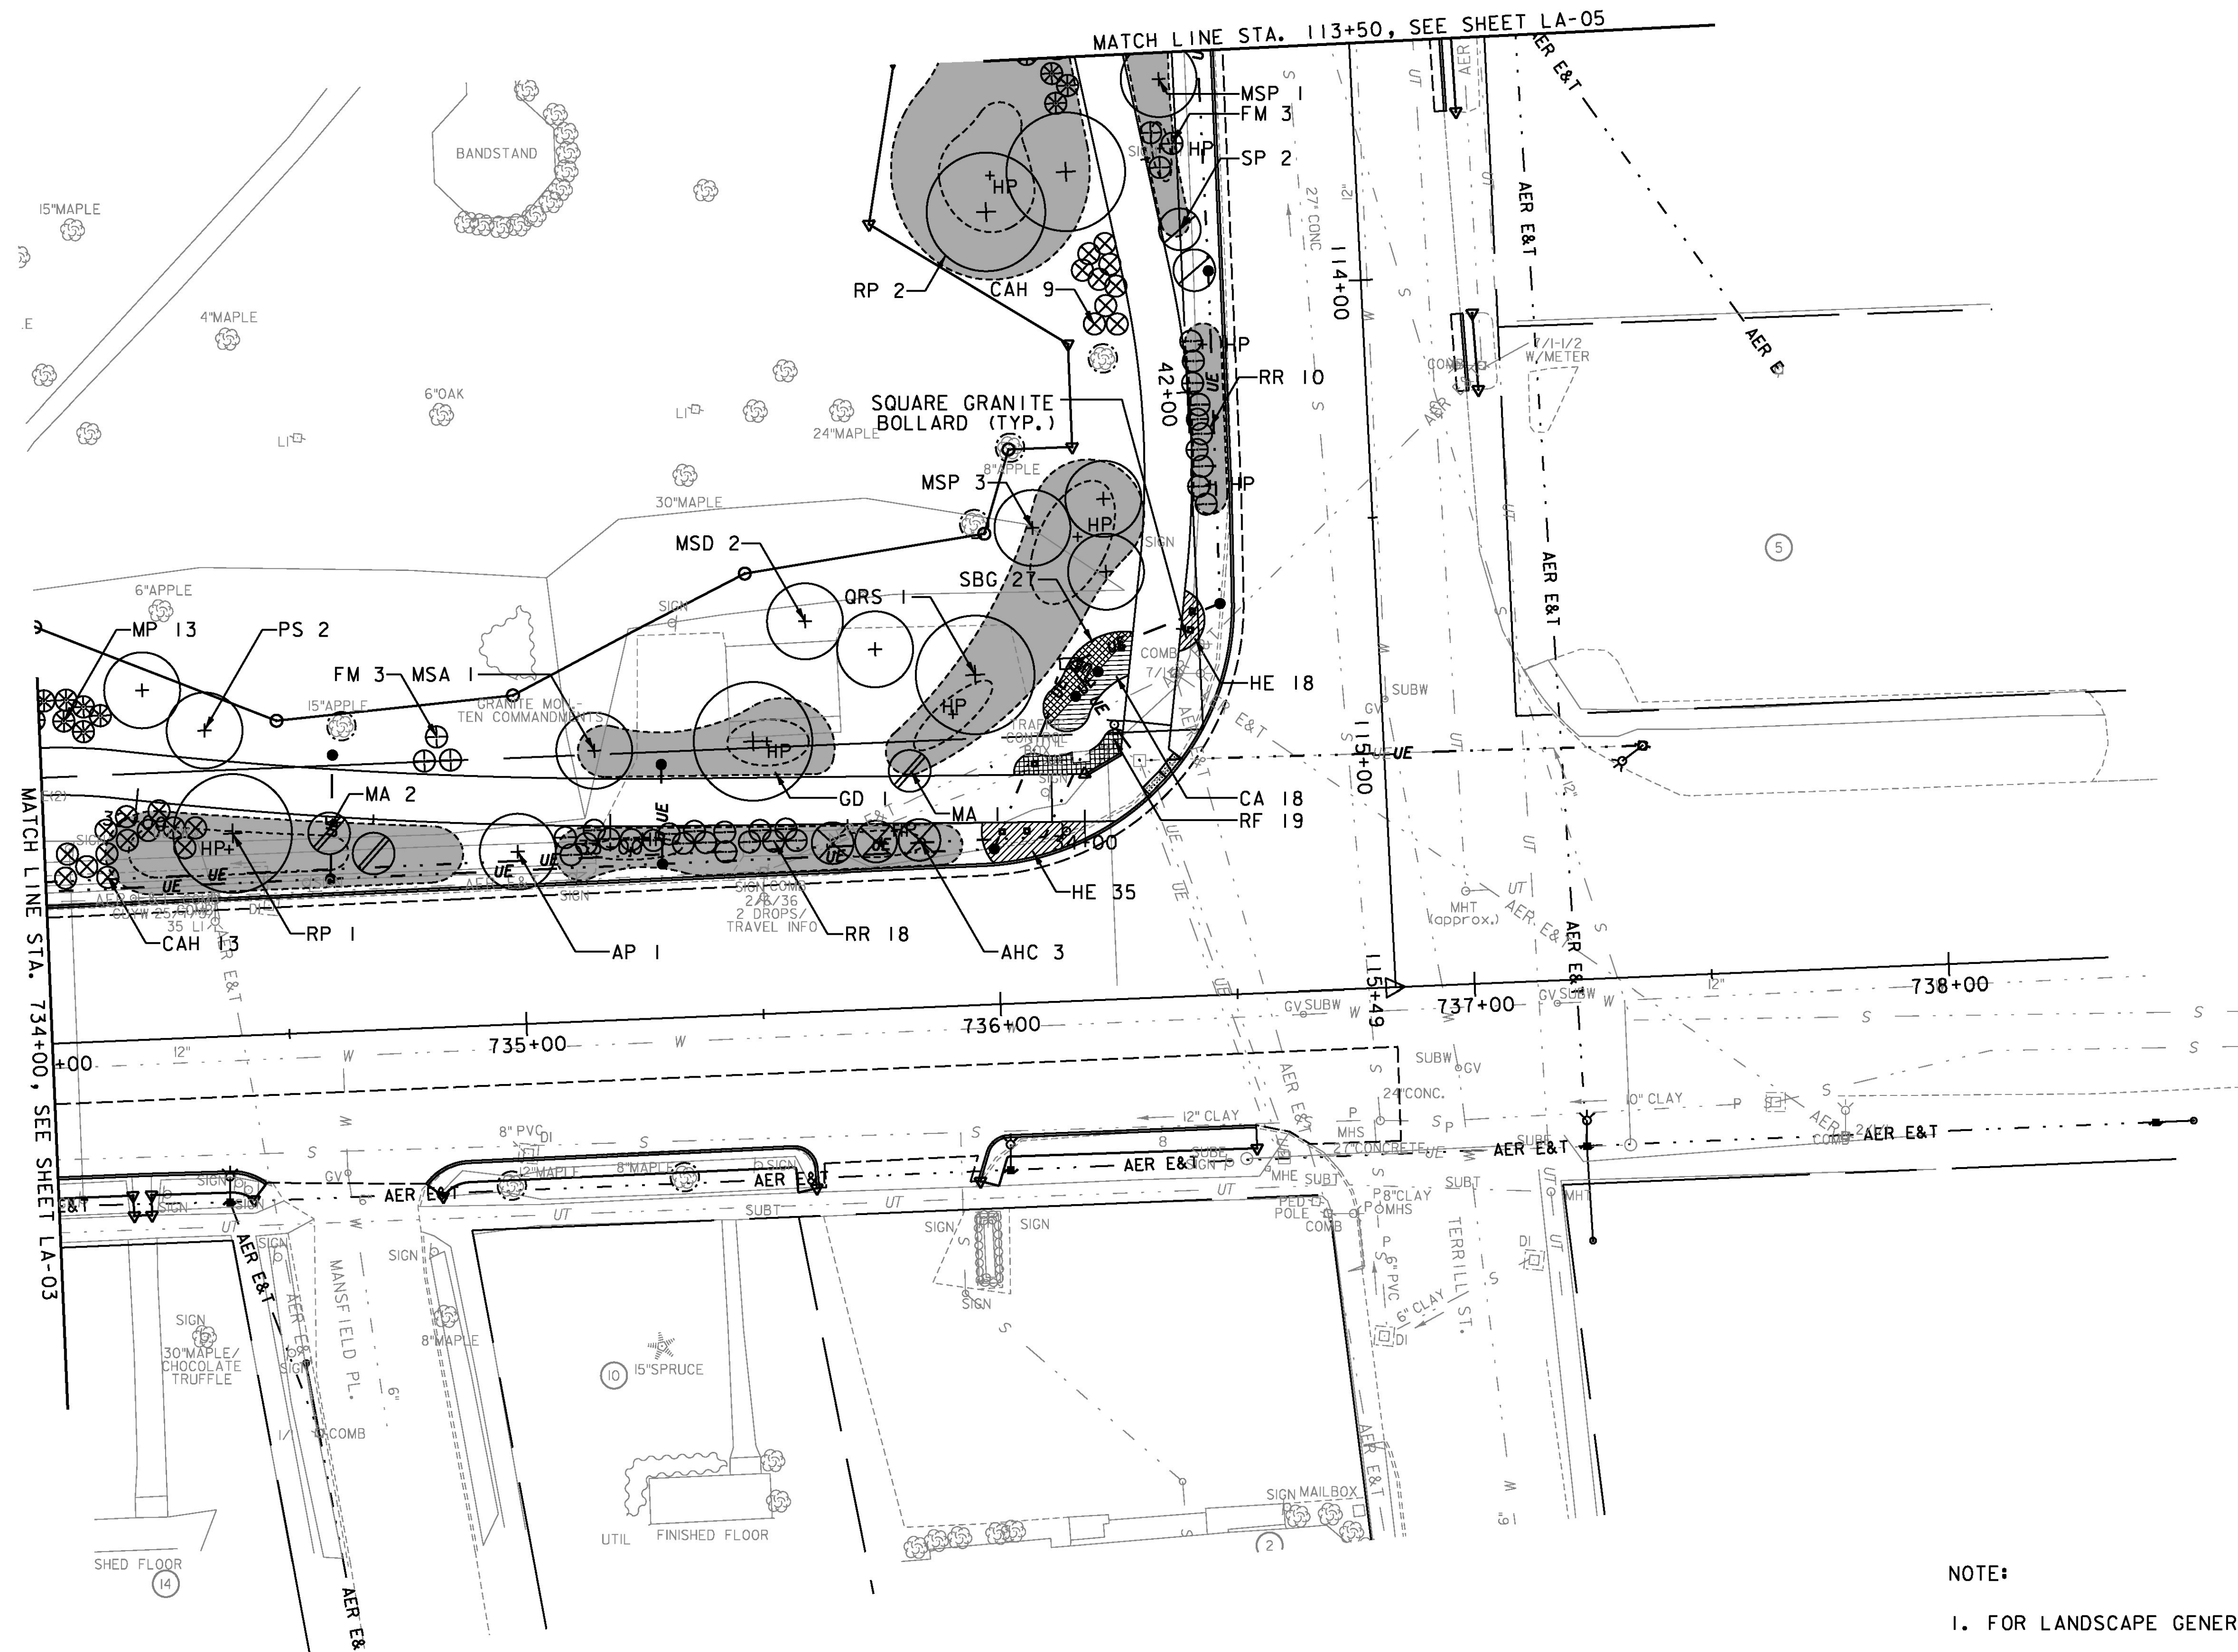


**SPECIAL PROVISION
(SQUARE GRANITE BOLLARD)**

- STA. 736+01, 36' LT.
- STA. 736+07, 36' LT.
- STA. 736+09, 50' LT.
- STA. 114+68, 39' RT.
- STA. 114+72, 40' RT.
- STA. 114+75, 54' RT.

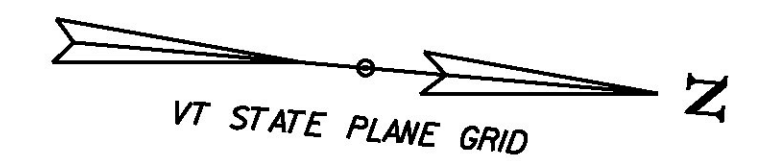

NOTE:
1. FOR LANDSCAPE GENERAL NOTES SEE SHEET LA-01.

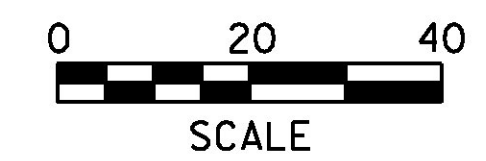

| | |
|-----------------|---------------------------------|
| PROJECT NAME: | RUTLAND CITY |
| PROJECT NUMBER: | STP 019-3(57) |
| FILE NAME: | ...Trans\PlotFiles\rut_land.dgn |
| PLOT DATE: | 7/12/2013 |
| PROJECT LEADER: | GAE |
| DRAWN BY: | PZA |
| DESIGNED BY: | TFD |
| CHECKED BY: | GAE |
| LANDSCAPE PLAN | LA-04 |
| | SHEET 369 OF 392 |