

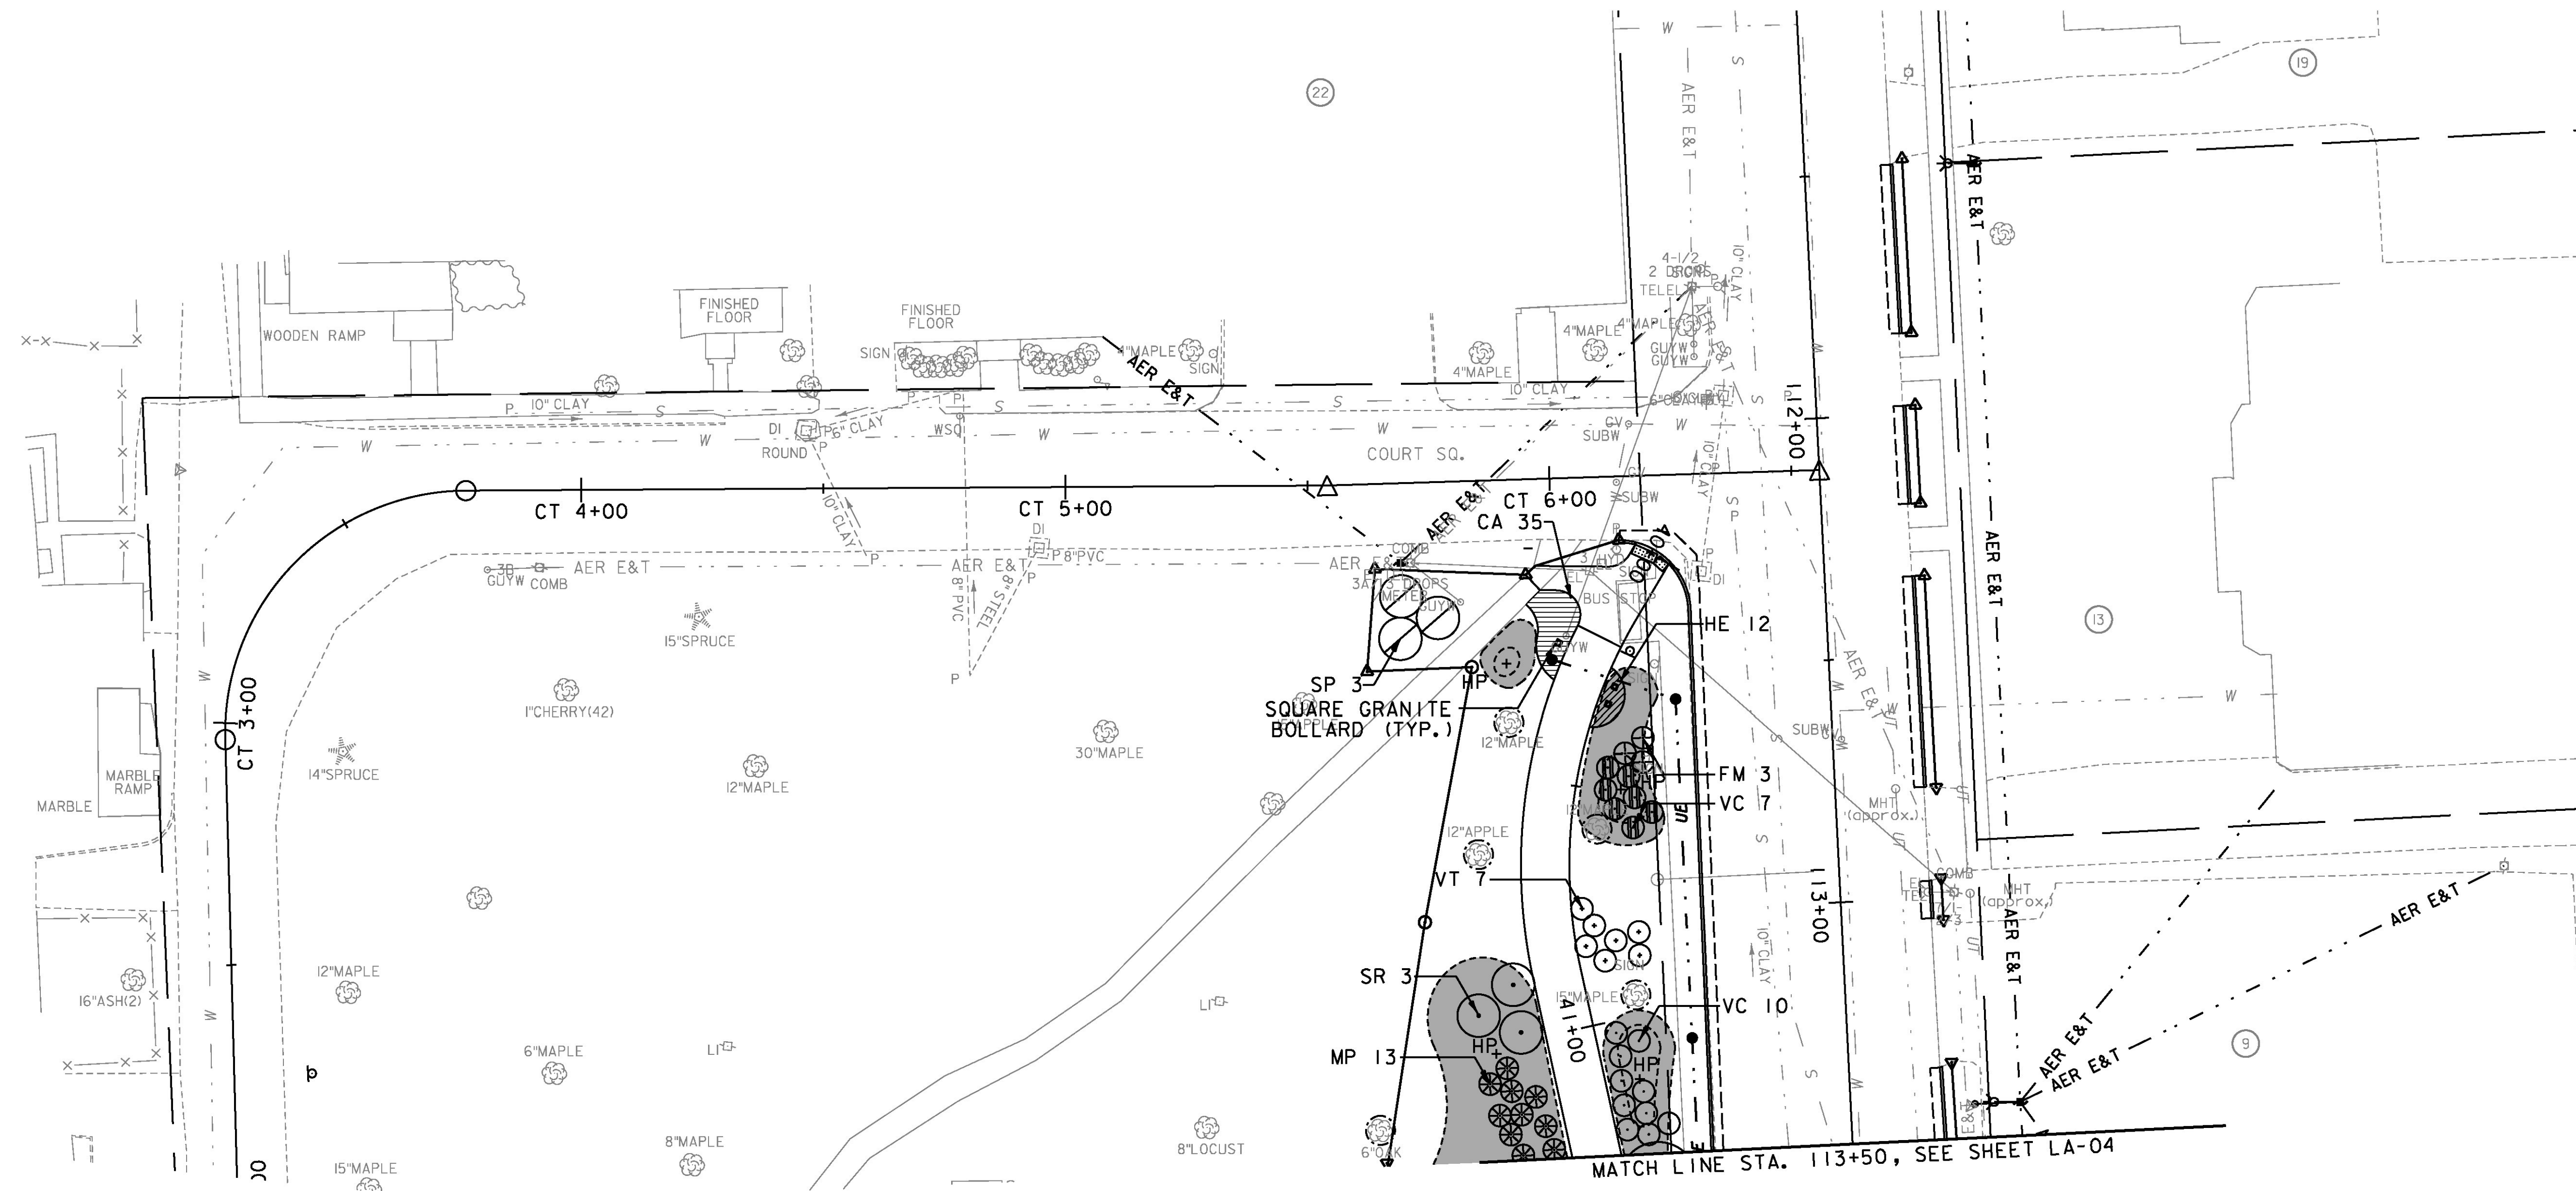


**SPECIAL PROVISION**  
**(SQUARE GRANITE BOLLARD)**  
 STA. 112+43, 55' RT.  
 STA. 112+53, 44' RT.  
 STA. 112+56, 46' RT.

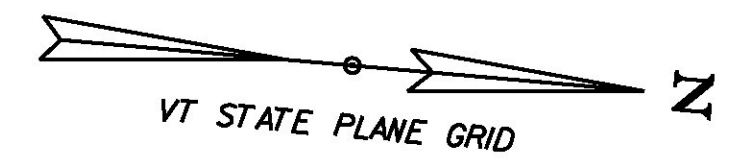

NOTE:  
 1. FOR LANDSCAPE GENERAL NOTES SEE SHEET LA-01.

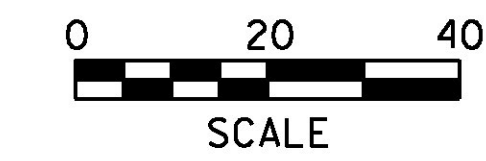

PROJECT NAME:	RUTLAND CITY
PROJECT NUMBER:	STP 019-3(57)
FILE NAME:	...Trans\PlotFiles\rut_land.dgn
PLOT DATE:	7/12/2013
PROJECT LEADER:	GAE
DRAWN BY:	PZA
DESIGNED BY:	TFD
CHECKED BY:	GAE
LANDSCAPE PLAN LA-05	SHEET 370 OF 392