




724+50

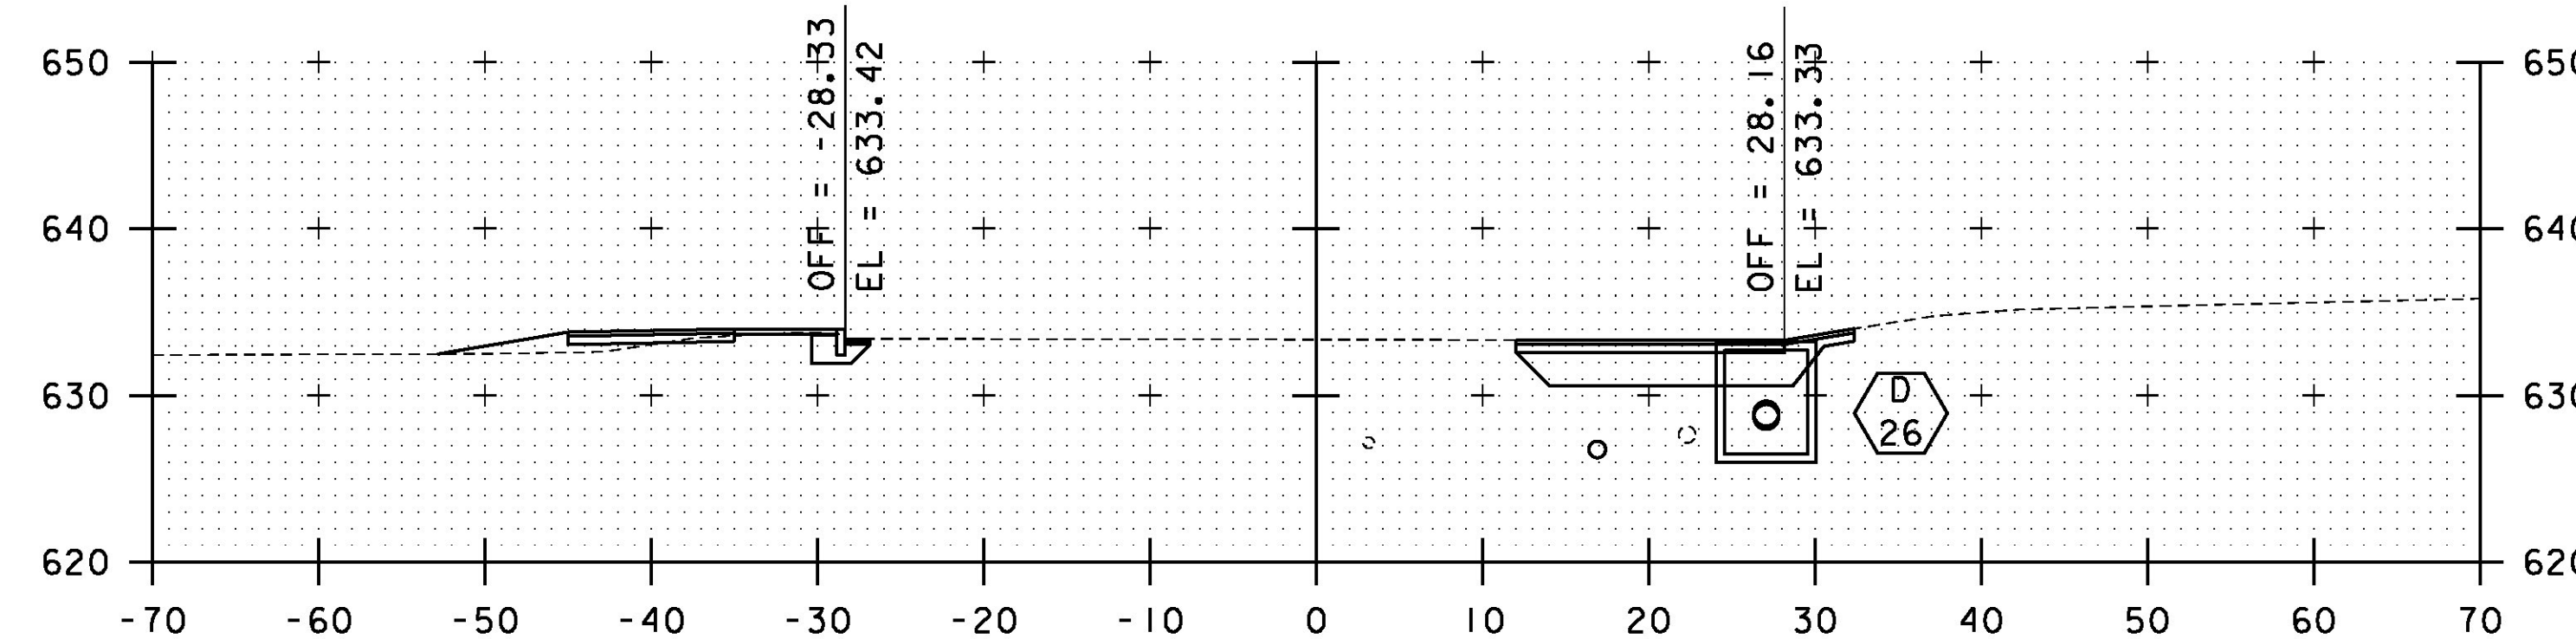


726+00
BIT. DRIVE, RT

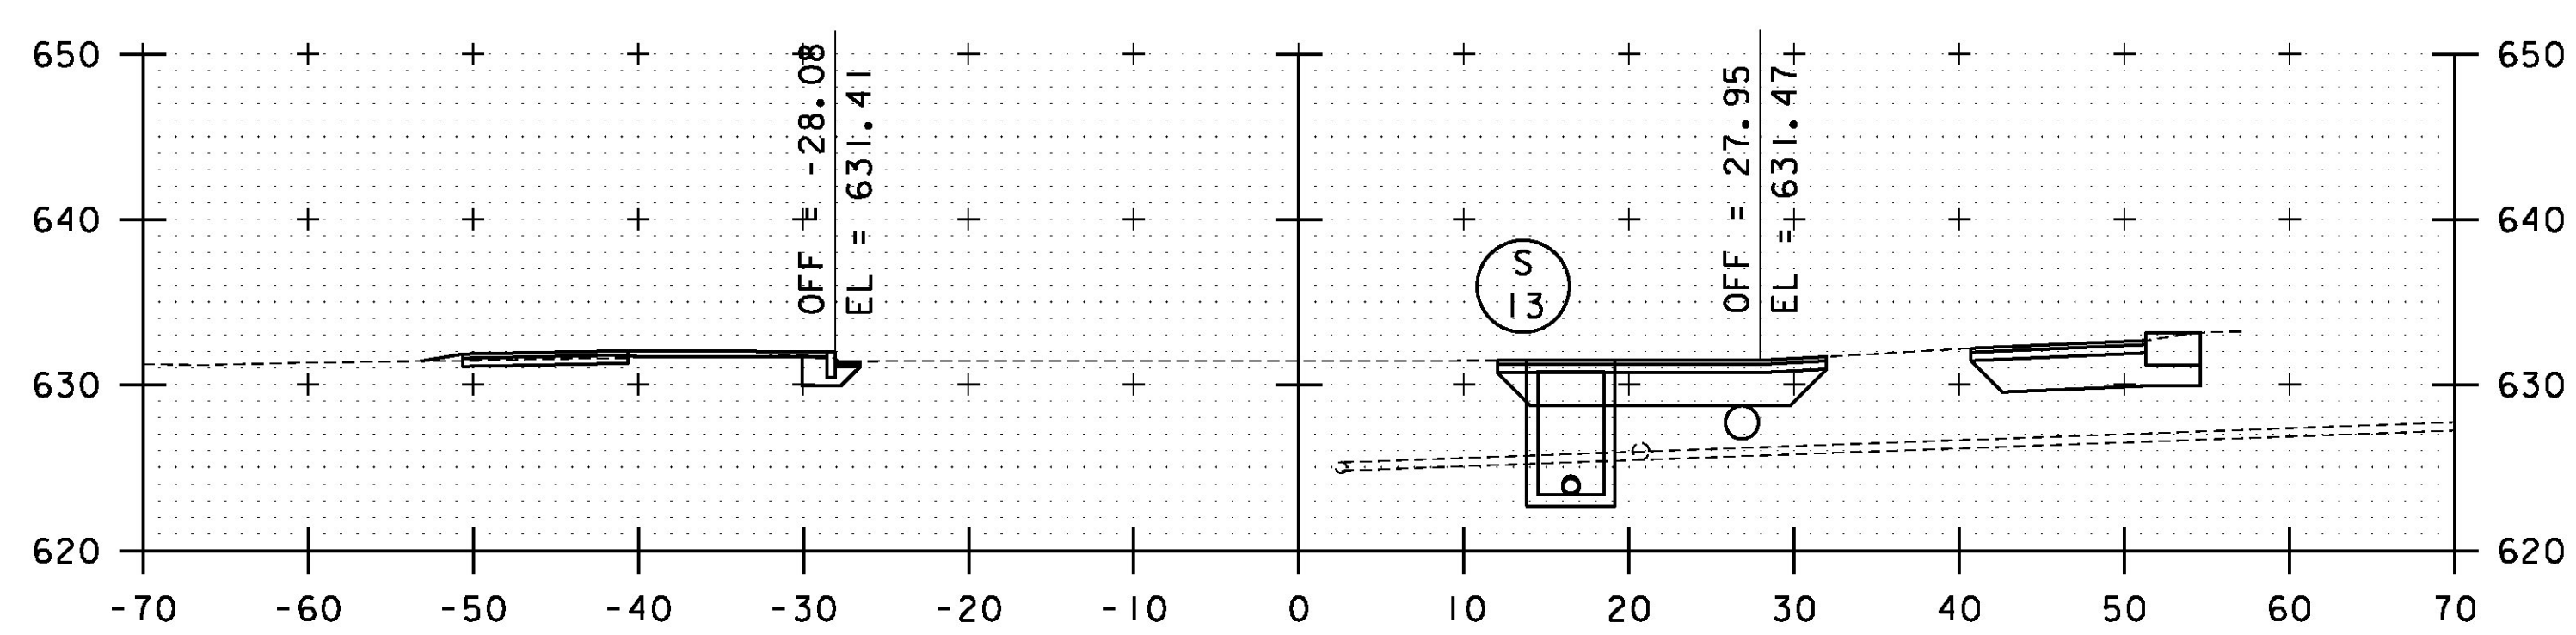


724+00
SPELLMAN TERRACE, RT

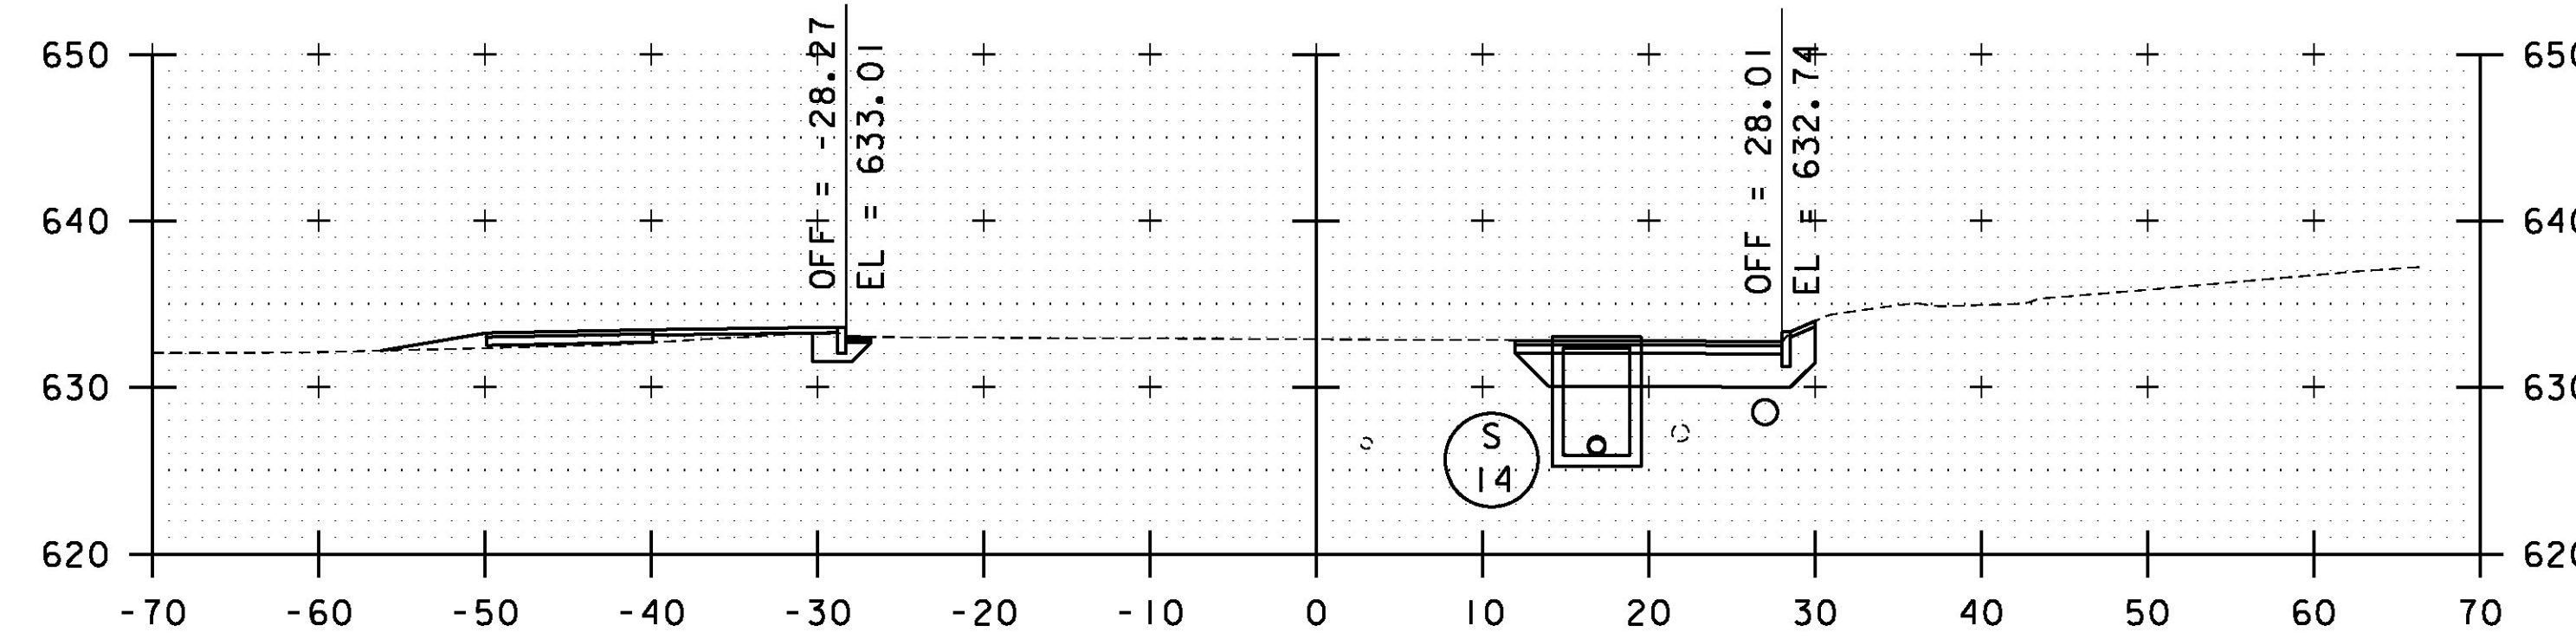

725+50

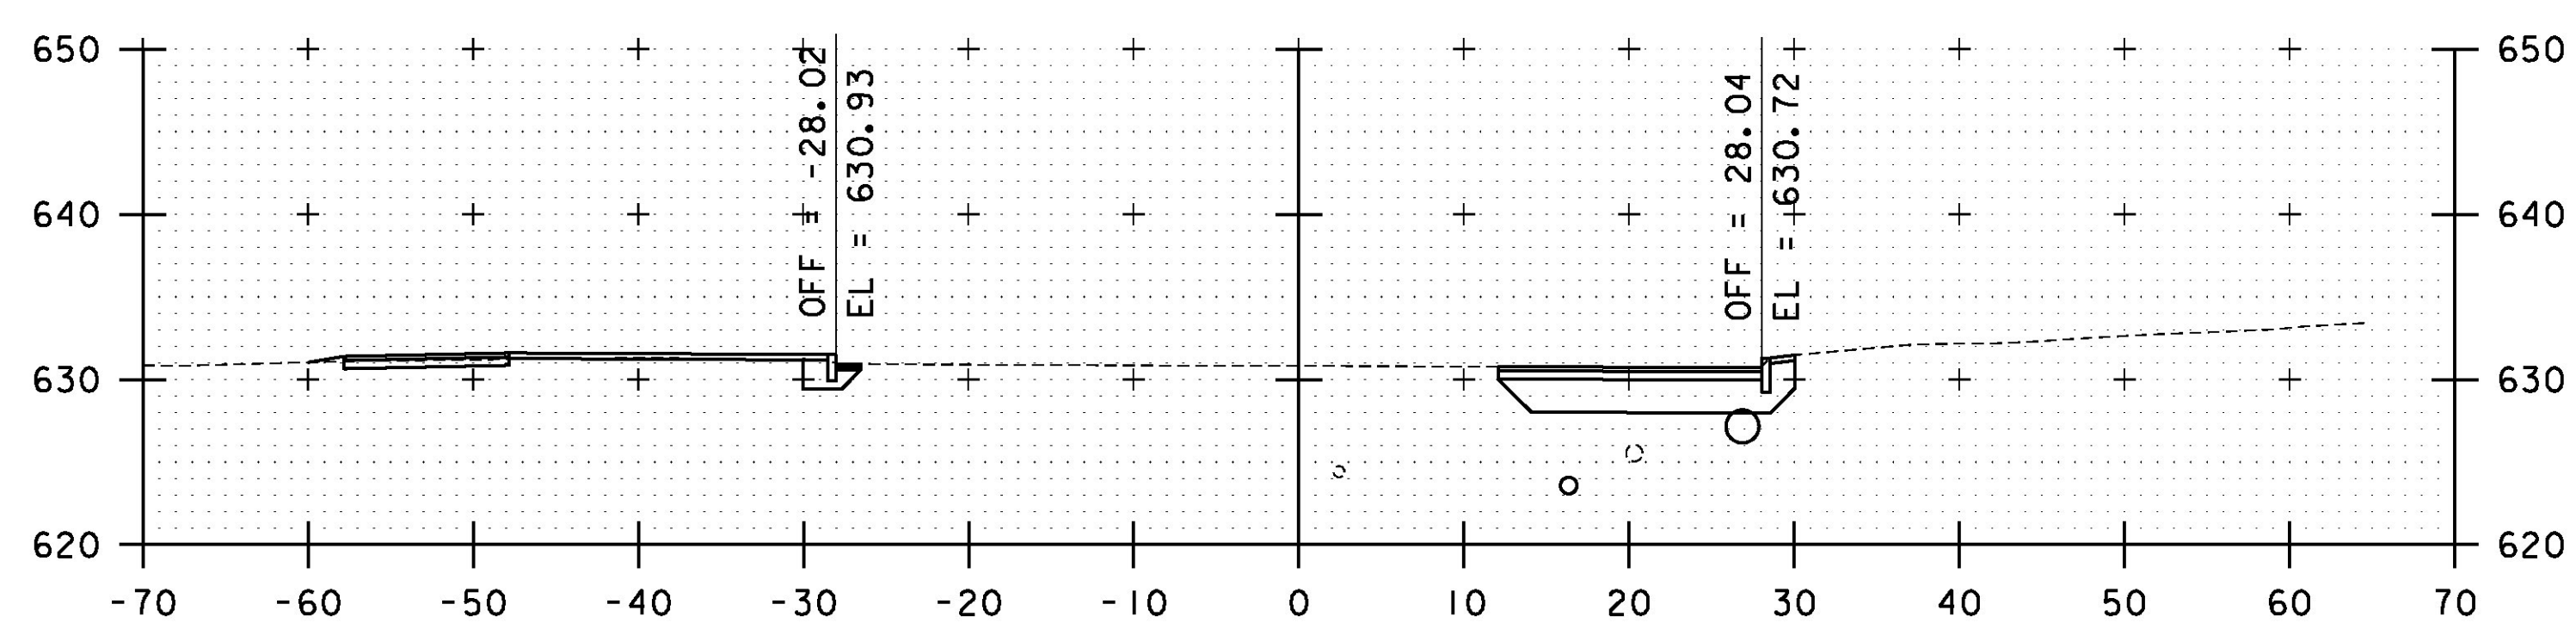

723+50

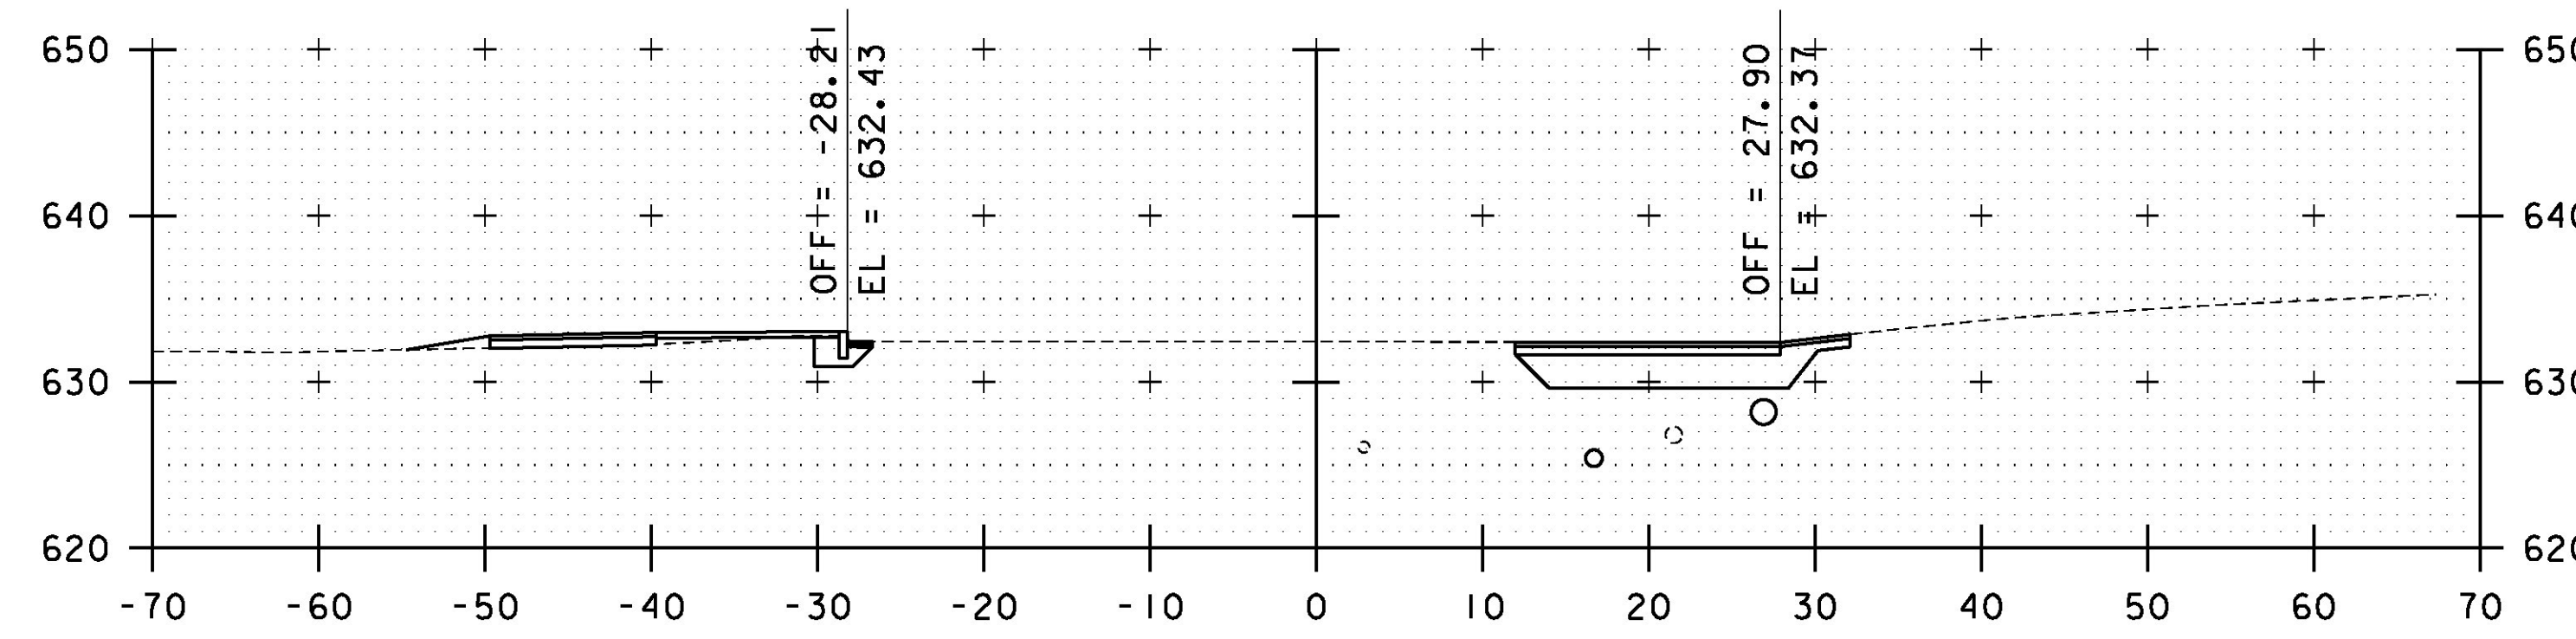

725+00
BIT. DRIVE, RT

STA. 723+50 TO STA. 726+00

PROJECT NAME:	RUTLAND CITY	PLOT DATE:	7/12/2013
PROJECT NUMBER:	STP 019-3(57)	DRAWN BY:	PZA
FILE NAME:	...\\PlotFiles\\rut_sections.dgn	DESIGNED BY:	TFD
PROJECT LEADER:	GAE	CHECKED BY:	GAE
CROSS SECTIONS XS-12		SHEET	385 OF 392

