



733+44  
EX. COURT SQUARE, LT

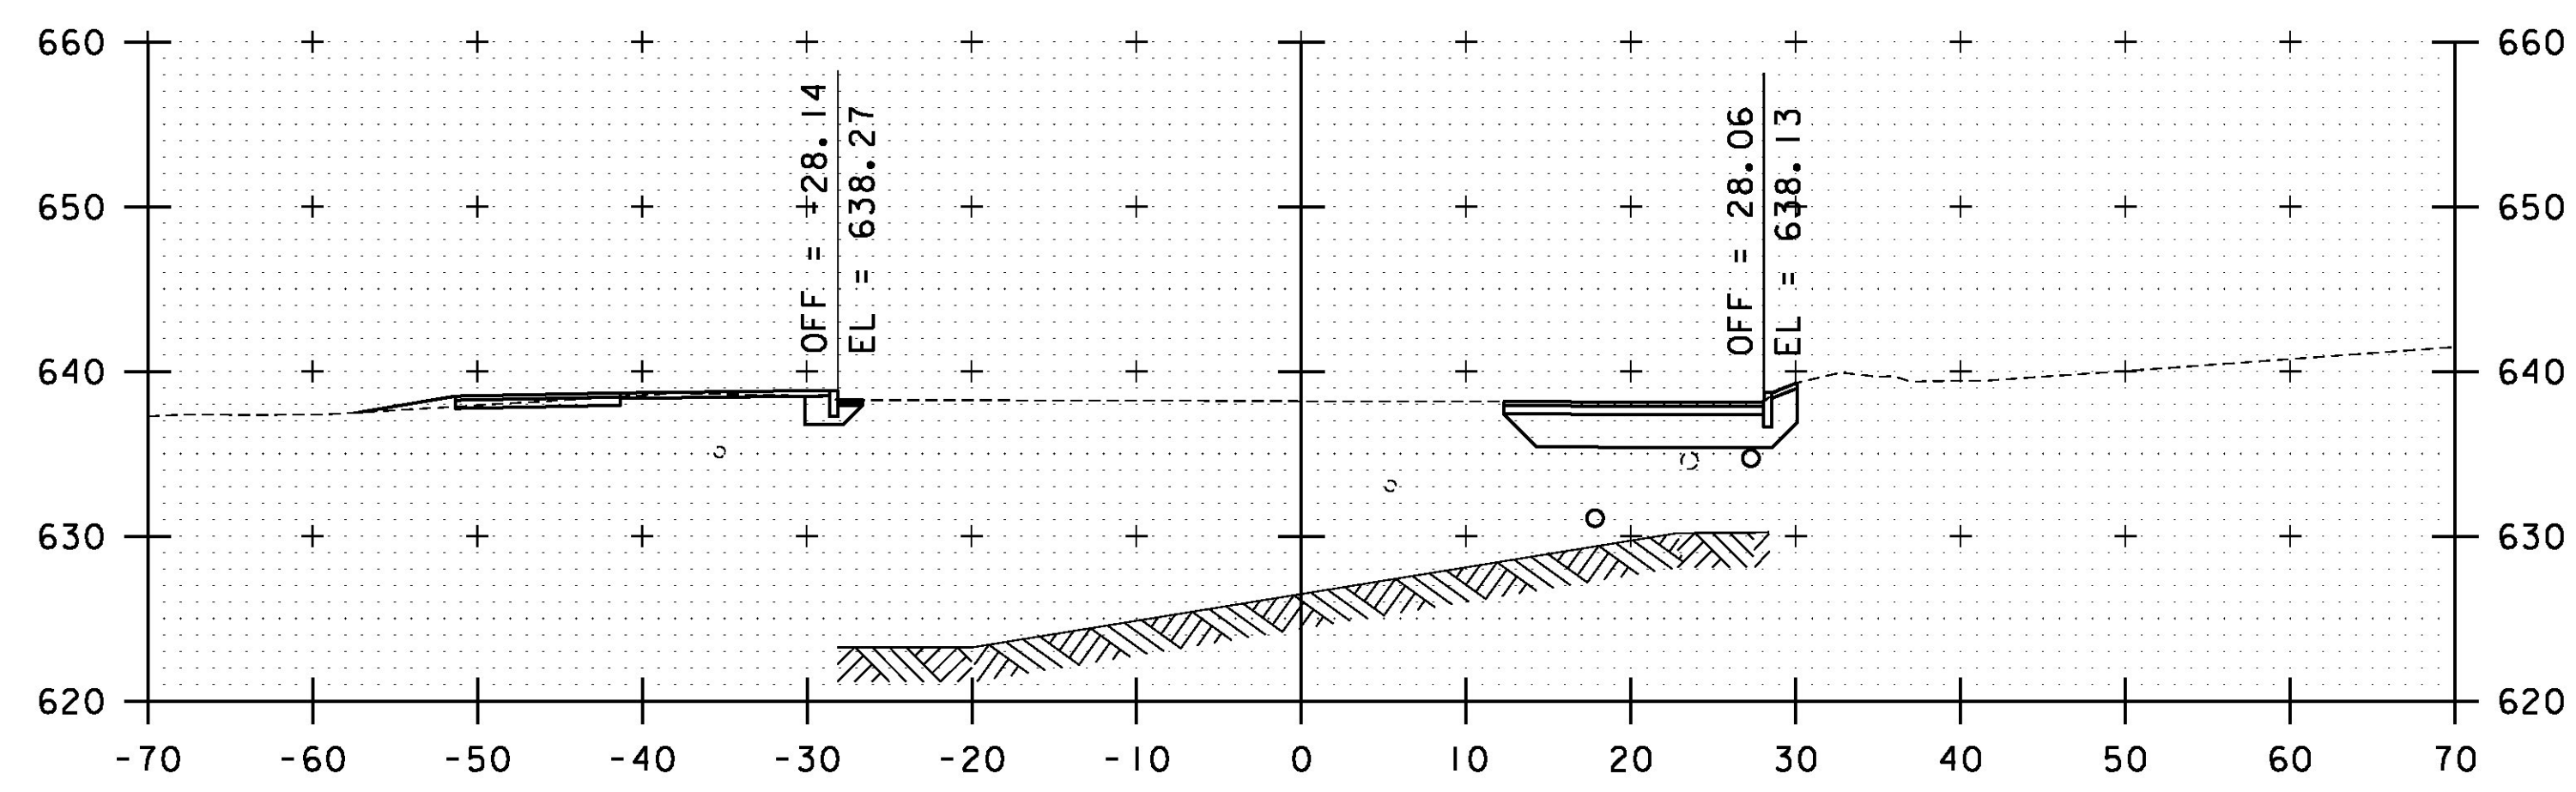

733+00

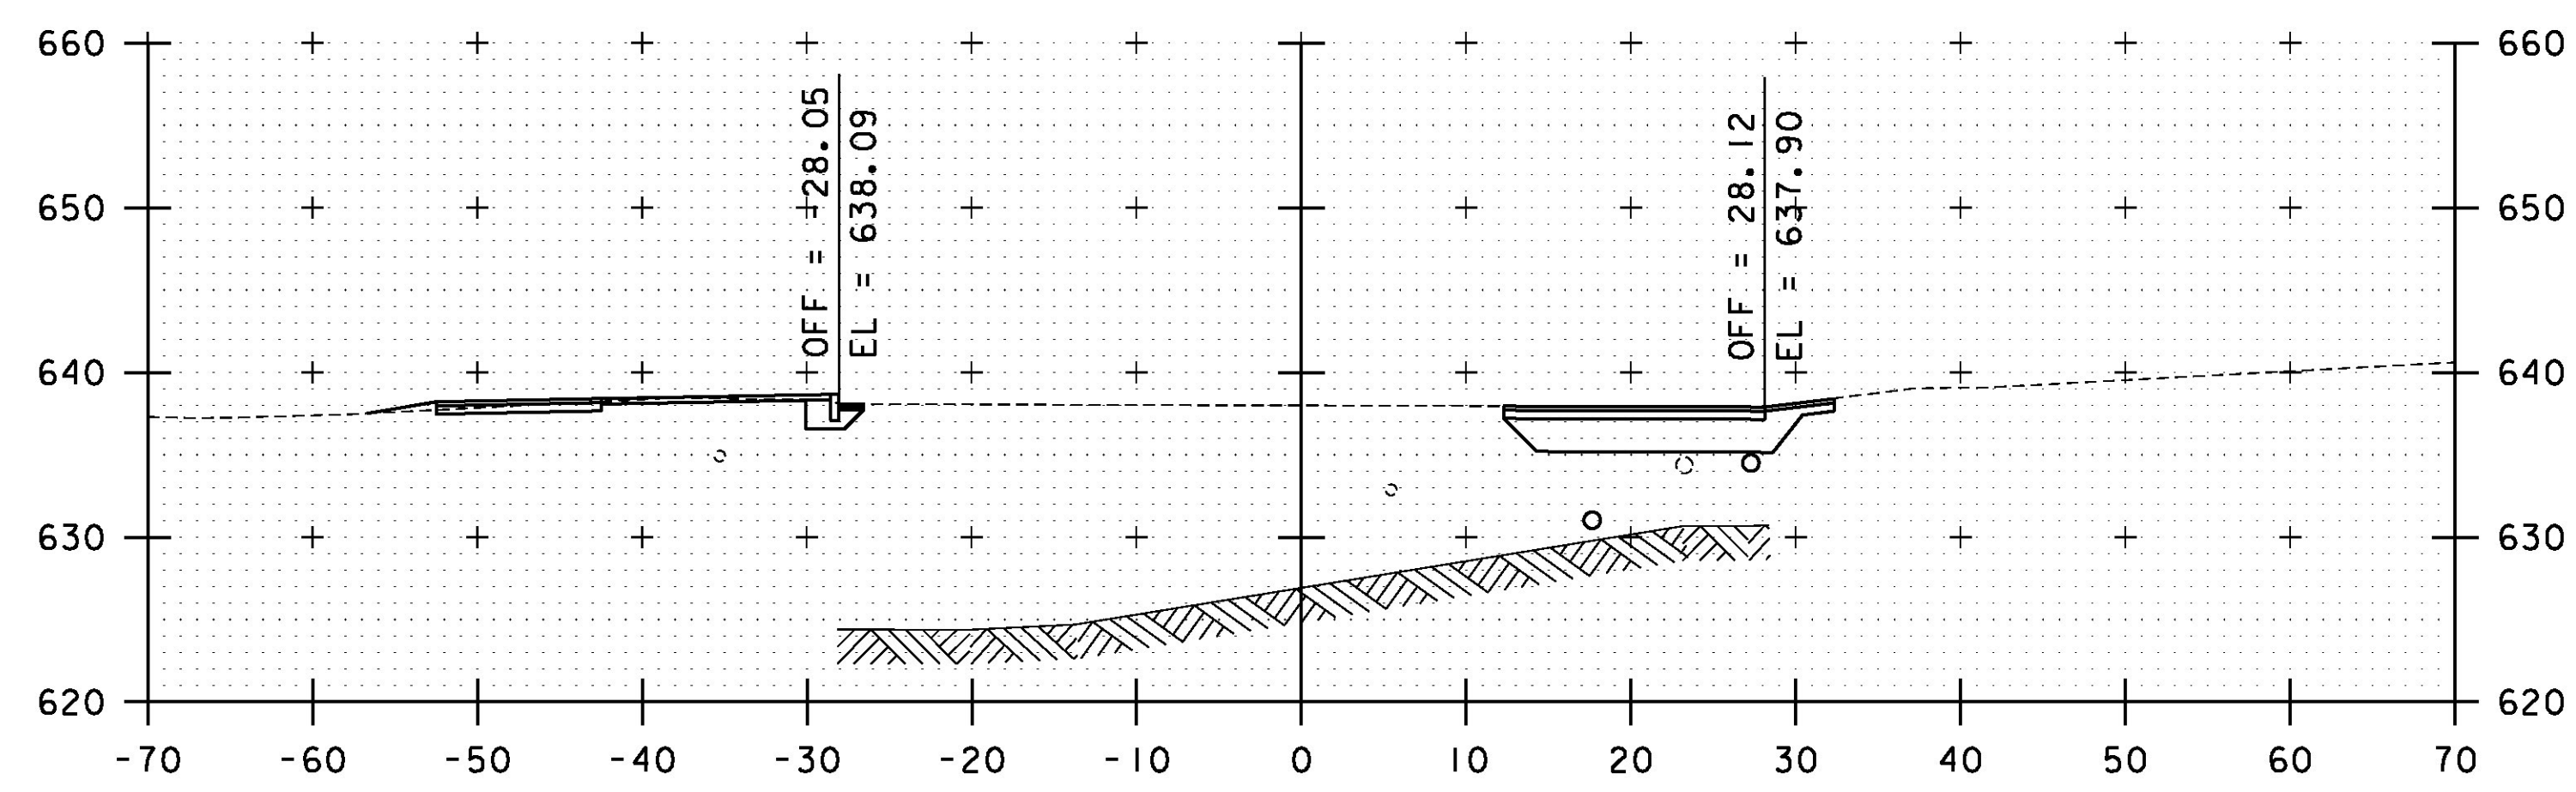

732+72  
BIT. DRIVE, RT

STA. 732+72 TO STA. 733+44

PROJECT NAME:	RUTLAND CITY
PROJECT NUMBER:	STP 019-3(57)
FILE NAME: ...\PlotFiles\rut_sections.dgn	PLOT DATE: 7/12/2013
PROJECT LEADER: GAE	DRAWN BY: PZA
DESIGNED BY: TFD	CHECKED BY: GAE
<b>CROSS SECTIONS XS-16</b>	SHEET 389 OF 392

