




MAINLINE

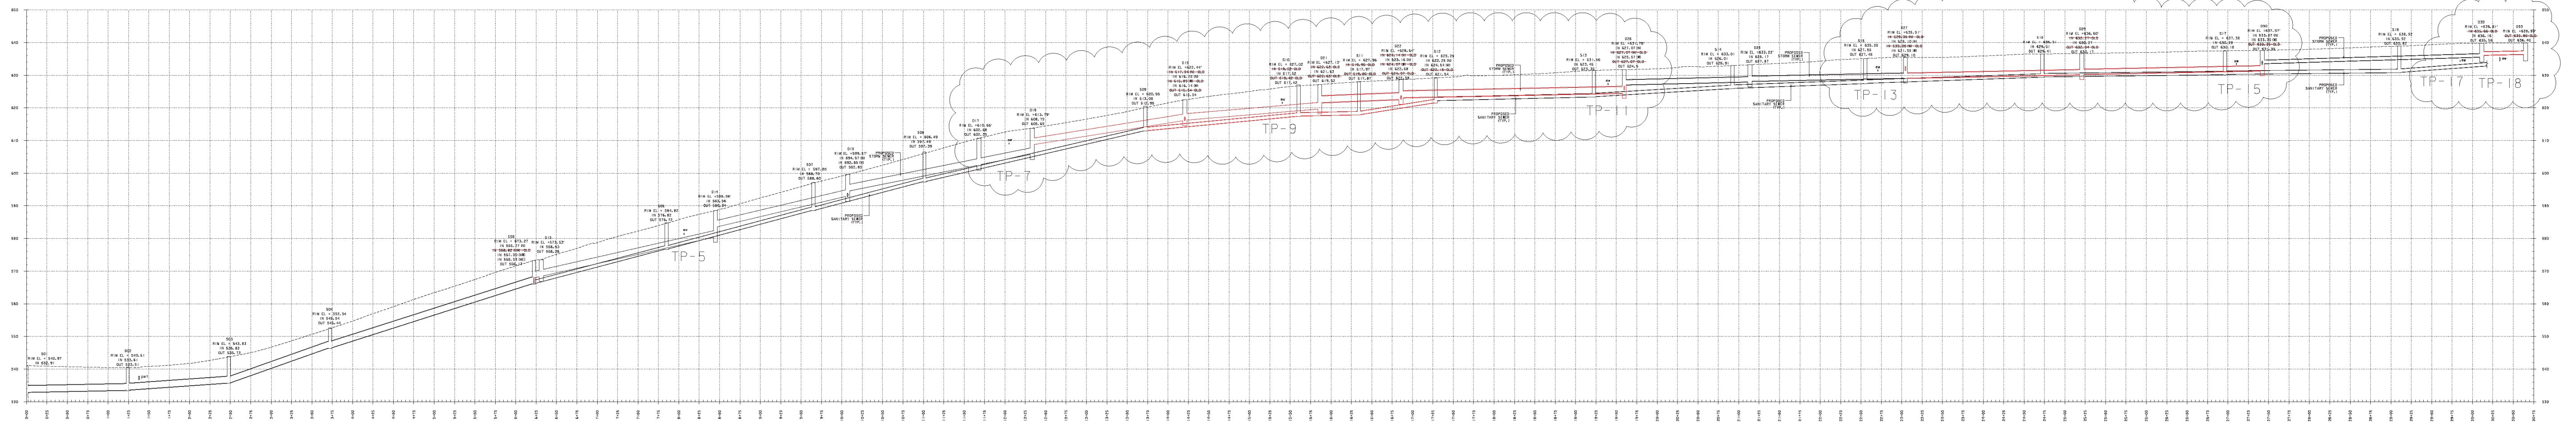

D07 - D11

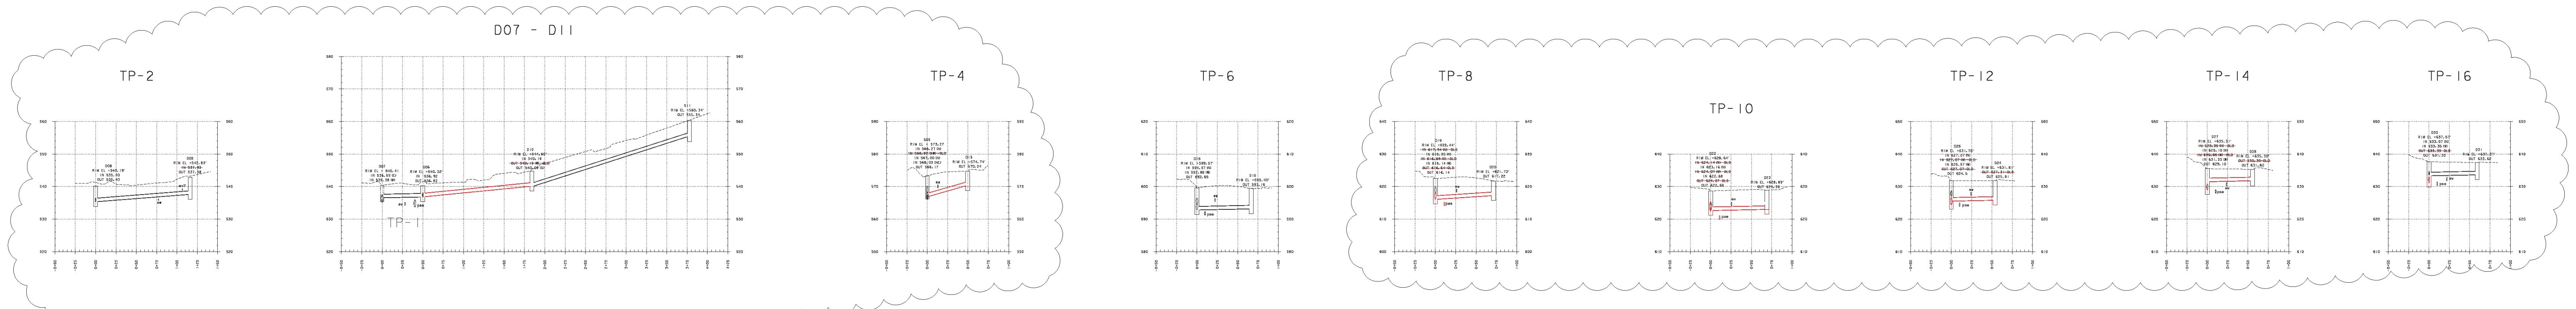

- NOTES:
1. NO CHANGES HAVE BEEN MADE TO STRUCTURE LOCATIONS.
  2. OLD INVERT HAS BEEN LINED OUT.
  3. REVISED PIPING IS DEPICTED IN RED.
  4. ew = EXISTING WATER  
pst = PROPOSED STORM SEWER  
pse = PROPOSED SANITARY SEWER

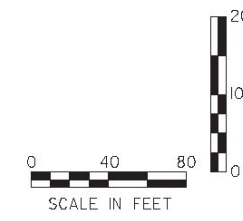

APRIL 25, 2014  
STORM & SANITARY SEWER  
PROFILE REVISION  
STANTEC