


104+65

RECORD DRAWING
DATE: DECEMBER 21, 2012

FIELD CHANGE #4
 ADDED DRIVE FOR EMERGENCY ACCESS
 STA. 104+80, LT
 OCTOBER 6, 2011

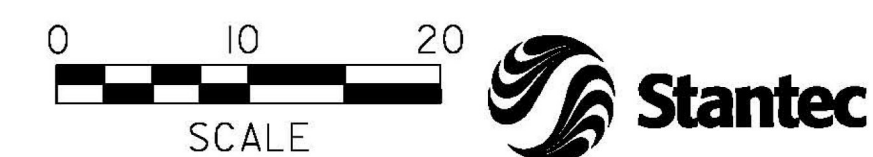

PROJECT NAME:	COLCHESTER CAMPUS CONNECTOR
PROJECT NUMBER:	TCSP TCSE (007)
FILE NAME:	... \ROADWAY_PLANS.dgn
DESIGNED BY:	JBL
DESIGNED BY:	JBL
GENERAL PLAN	GP-2
PLOT DATE:	10/6/2011
DRAWN BY:	GJB
CHECKED BY:	TL
SHEET	1 OF 1