


**MATERIAL THICKNESSES**

MATERIAL ITEM	THICKNESS TOLERANCE
PAVEMENT COURSES (TOTAL DEPTH)	+/- 1/4"
BASE COURSES (TOTAL DEPTH)	+/- 1"
SUBBASE	+/- 1"


**TYPICAL SECTIONS**

- 1.5" SUPERPAVE BITUMINOUS CONCRETE PAVEMENT (TYPE 111S), 1 LIFT
- 3" SUPERPAVE BITUMINOUS CONCRETE PAVEMENT (TYPE 1S), 1 LIFT
- 24" SUBBASE OF DENSE GRADED CRUSHED STONE

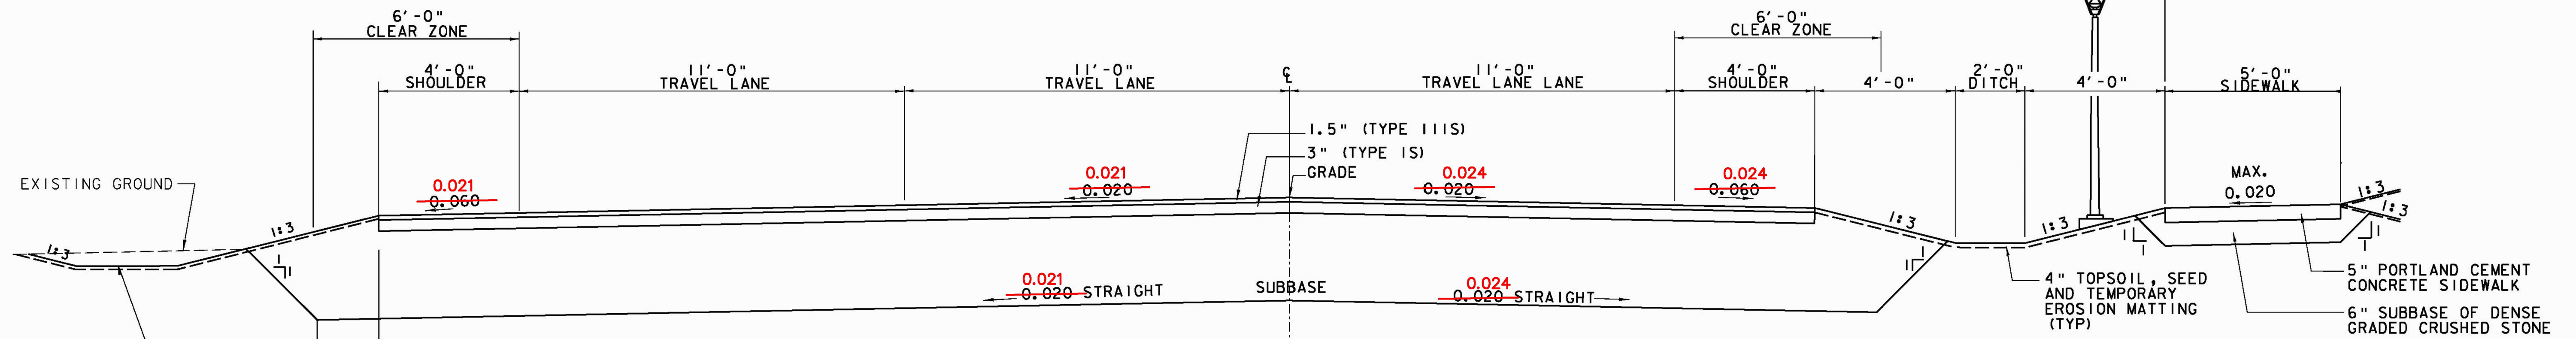

**VT NATIONAL GUARD ROAD TYPICAL SECTION**

STA 30+95 TO 35+50  
SCALE: N.T.S.

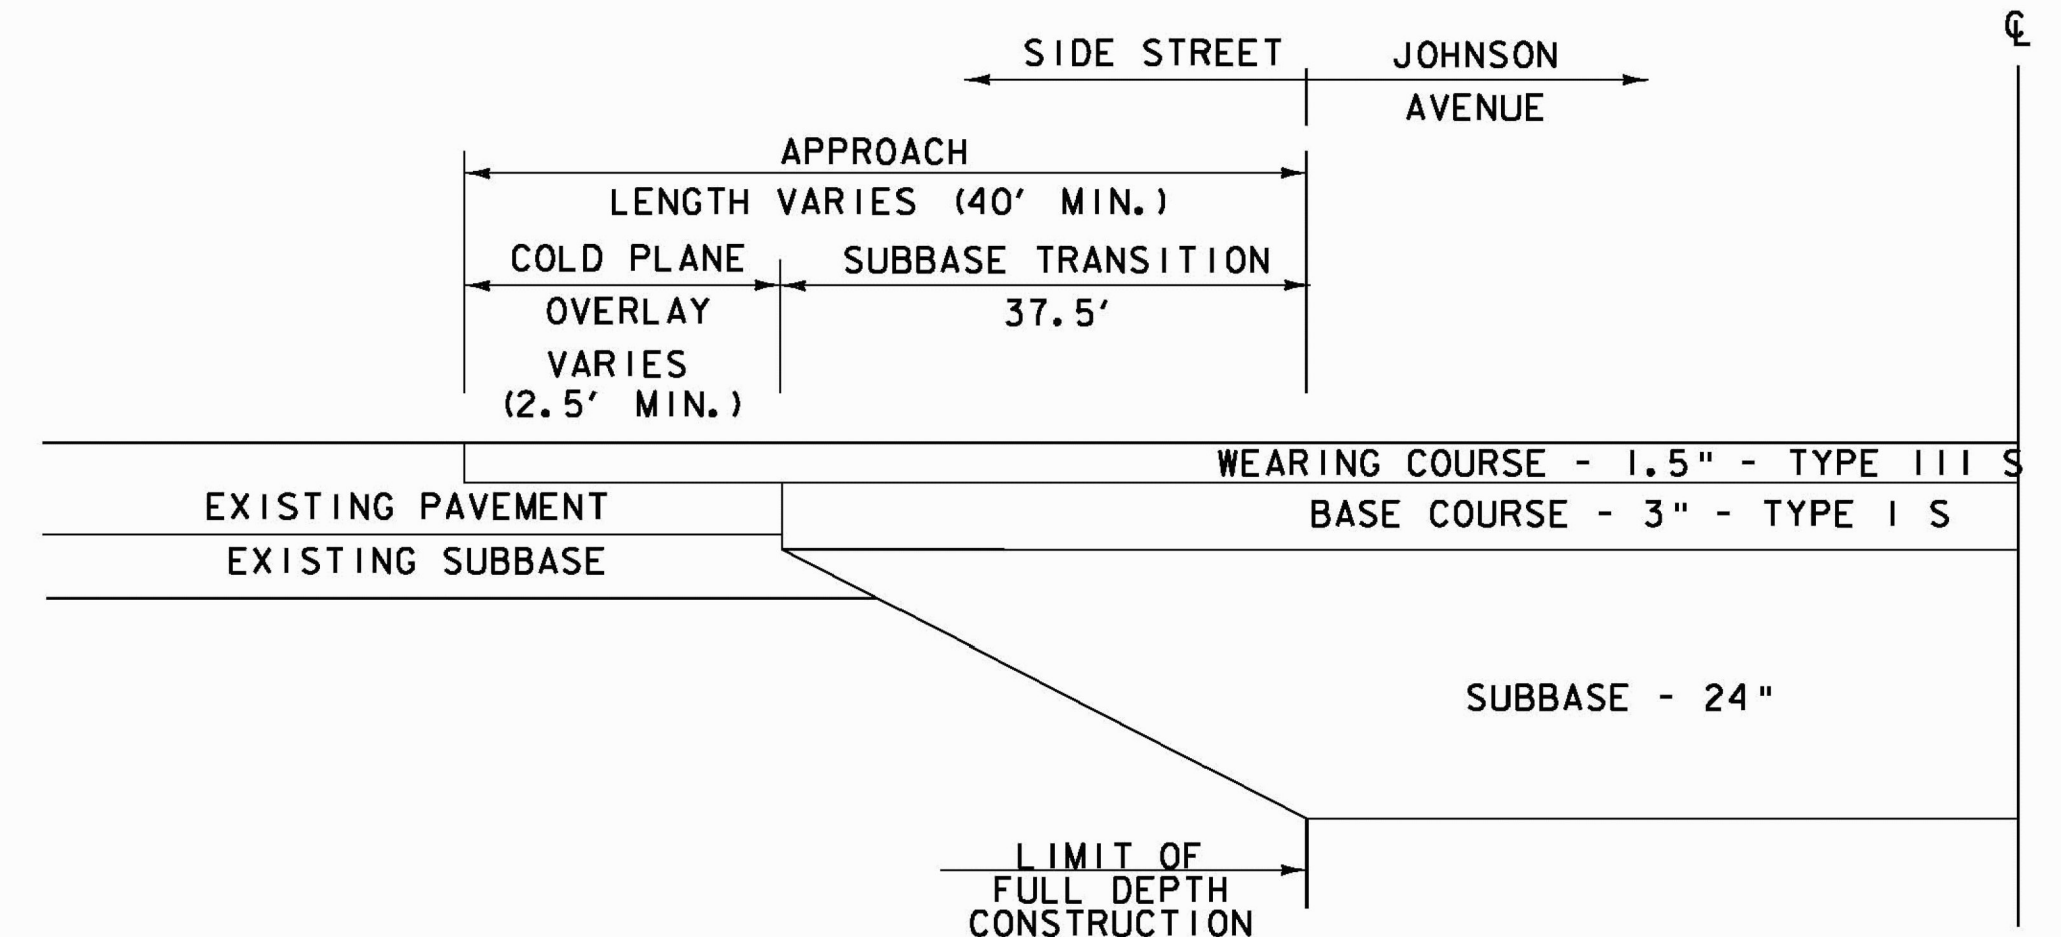

**RESIDENTIAL/COMMERCIAL DRIVEWAY**

SCALE: N.T.S.


**SIDE STREET TYPICAL PAVEMENT & SUBBASE TRANSITION**

- STA. 106+59, LT. (MT. STERLING AVENUE)
  - STA. 107+75, LT. (MT. MANSFIELD AVENUE)
  - STA. 114+07, RT. (LINCOLN DRIVE)
  - STA. 118+15, RT. (DOUGLAS DRIVE)
  - STA. 120+36, RT. (GILMAN CIRCLE)
  - STA. 122+46, RT. (GILMAN CIRCLE)
  - STA. 125+84, RT. (GILMAN CIRCLE)
- SCALE: N.T.S.

**RECORD DRAWING**  
DATE: DECEMBER 21, 2012


**BARNES AVE. SIDEWALK TYPICAL**

STA 91+00 TO 94+33  
SCALE: N.T.S.

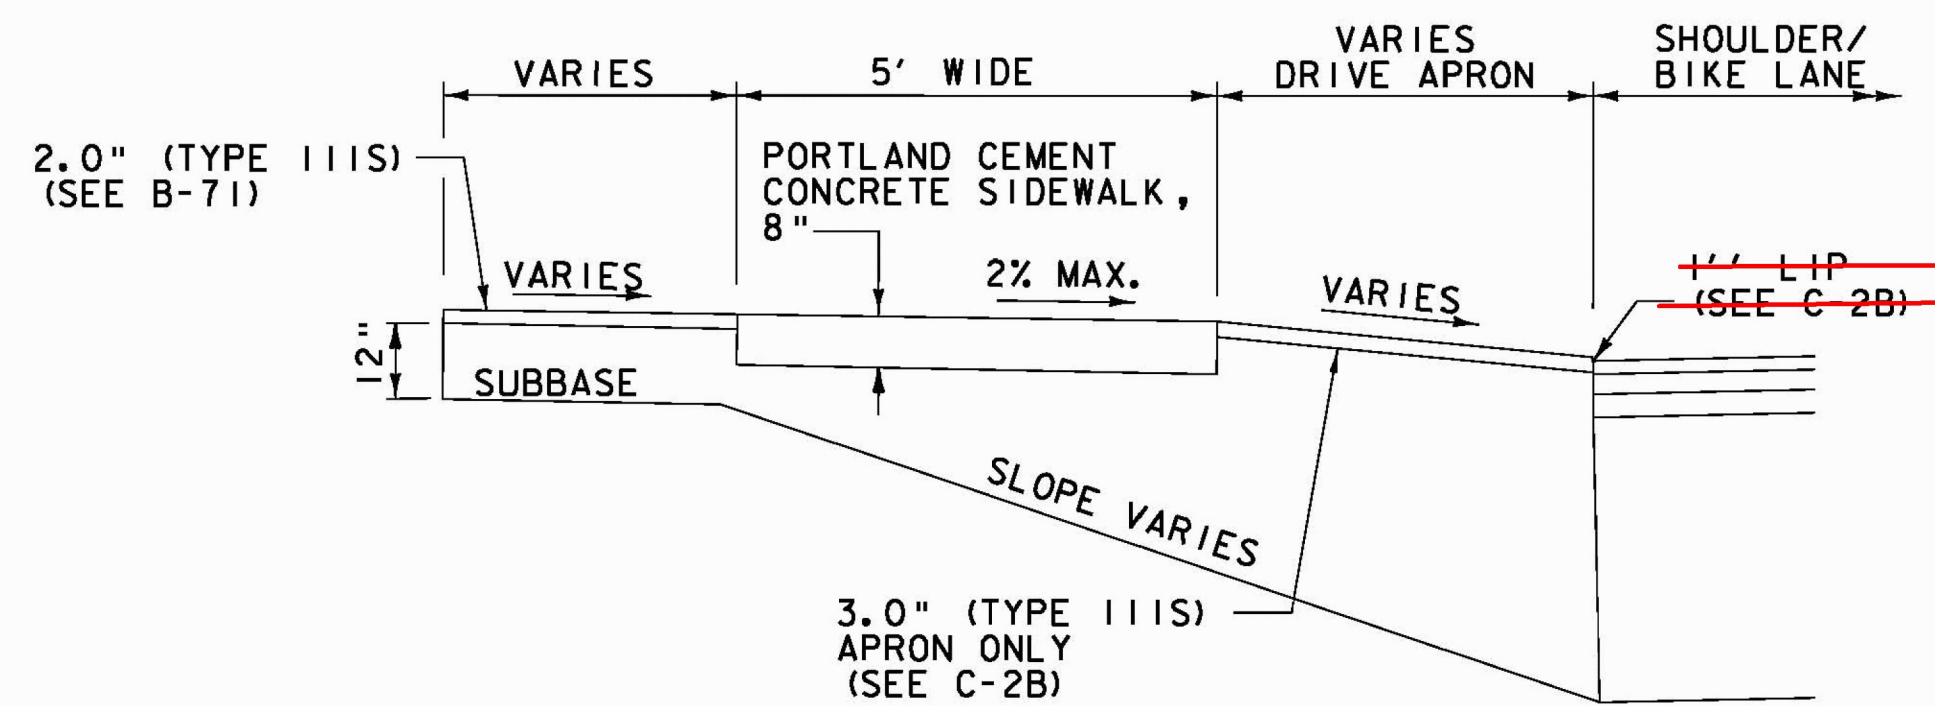

**RESIDENTIAL DRIVEWAY W/SIDEWALK**

STA. 105+00 TO 105+22  
SCALE: N.T.S.

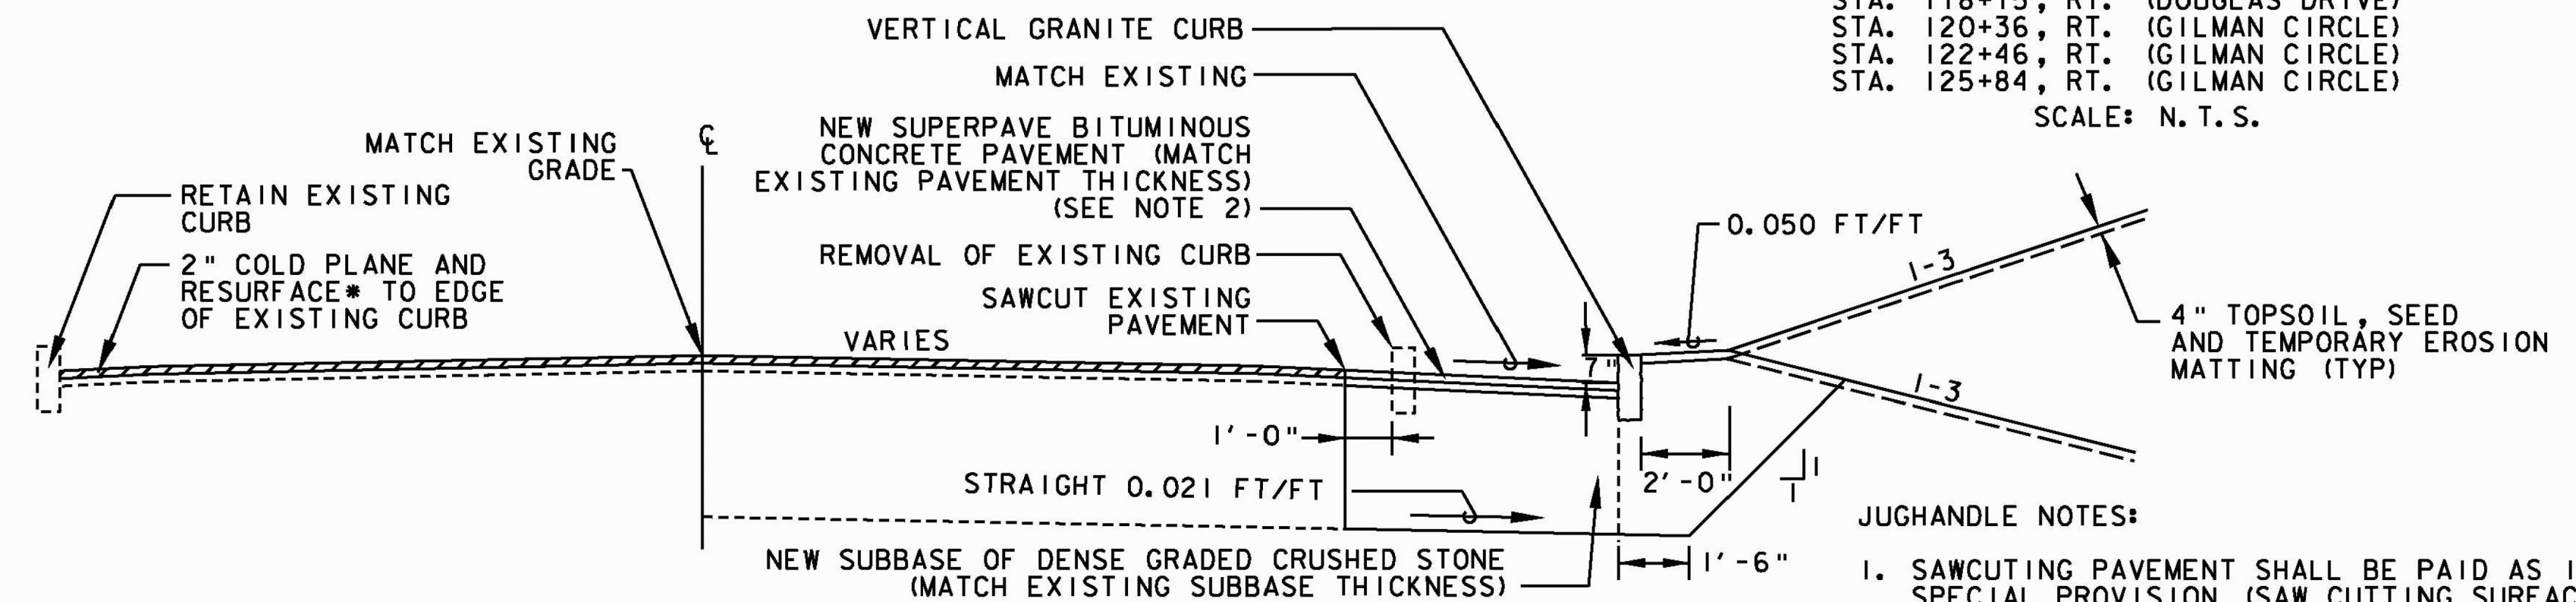

**JUGHANDLE TYPICAL SECTION**

STA. 29+57 TO 30+29  
SCALE: N.T.S.

\*RESURFACING:

- ~~LEVELING COURSE - 1/2" SUPERPAVE BITUMINOUS CONCRETE PAVEMENT (TYPE 1VS)~~
- WEARING COURSE - 1 1/2" SUPERPAVE BITUMINOUS CONCRETE PAVEMENT (TYPE 111S)

- JUGHANDLE NOTES:
- SAWCUTTING PAVEMENT SHALL BE PAID AS ITEM 900.6409 SPECIAL PROVISION (SAW CUTTING SURFACES AND PAVEMENTS).
  - IN WIDENED AREA ONLY, TOP 1.5" OF PAVEMENT SHALL BE TYPE 111S, REMAINING PAVEMENT SHALL MATCH EXISTING PAVEMENT THICKNESS AND BE TYPE 1S.



PROJECT NAME:	COLCHESTER CAMPUS CONNECTOR
PROJECT NUMBER:	TCSP TCSE (007)
FILE NAME:	...Plot Files\003-005_typical.plt
PROJECT LEADER:	JBL
DESIGNED BY:	TFD
DRAWN BY:	AHC
CHECKED BY:	GGG
PLOT DATE:	12/2/2010
<b>TYPICAL SECTION TS-2</b>	
SHEET 4 OF 153	