


**MAINLINE**  
 CURVE ML-2  
 PI STA. 101+69.47  
 N 728769.99  
 E 1468368.67  
 DELTA = 85° 58' 15" RT  
 DC = 89° 31' 29"  
 R = 64 FT  
 T = 59.65 FT  
 L = 96.03 FT  
 E = 23.49 FT  
 BANK = NA  
 PC = 101+09.82  
 PT = 102+05.85

JOHNSON AVENUE EXT STA. BL 102+05.85 =  
 MAINLINE PT STA. 102+05.85

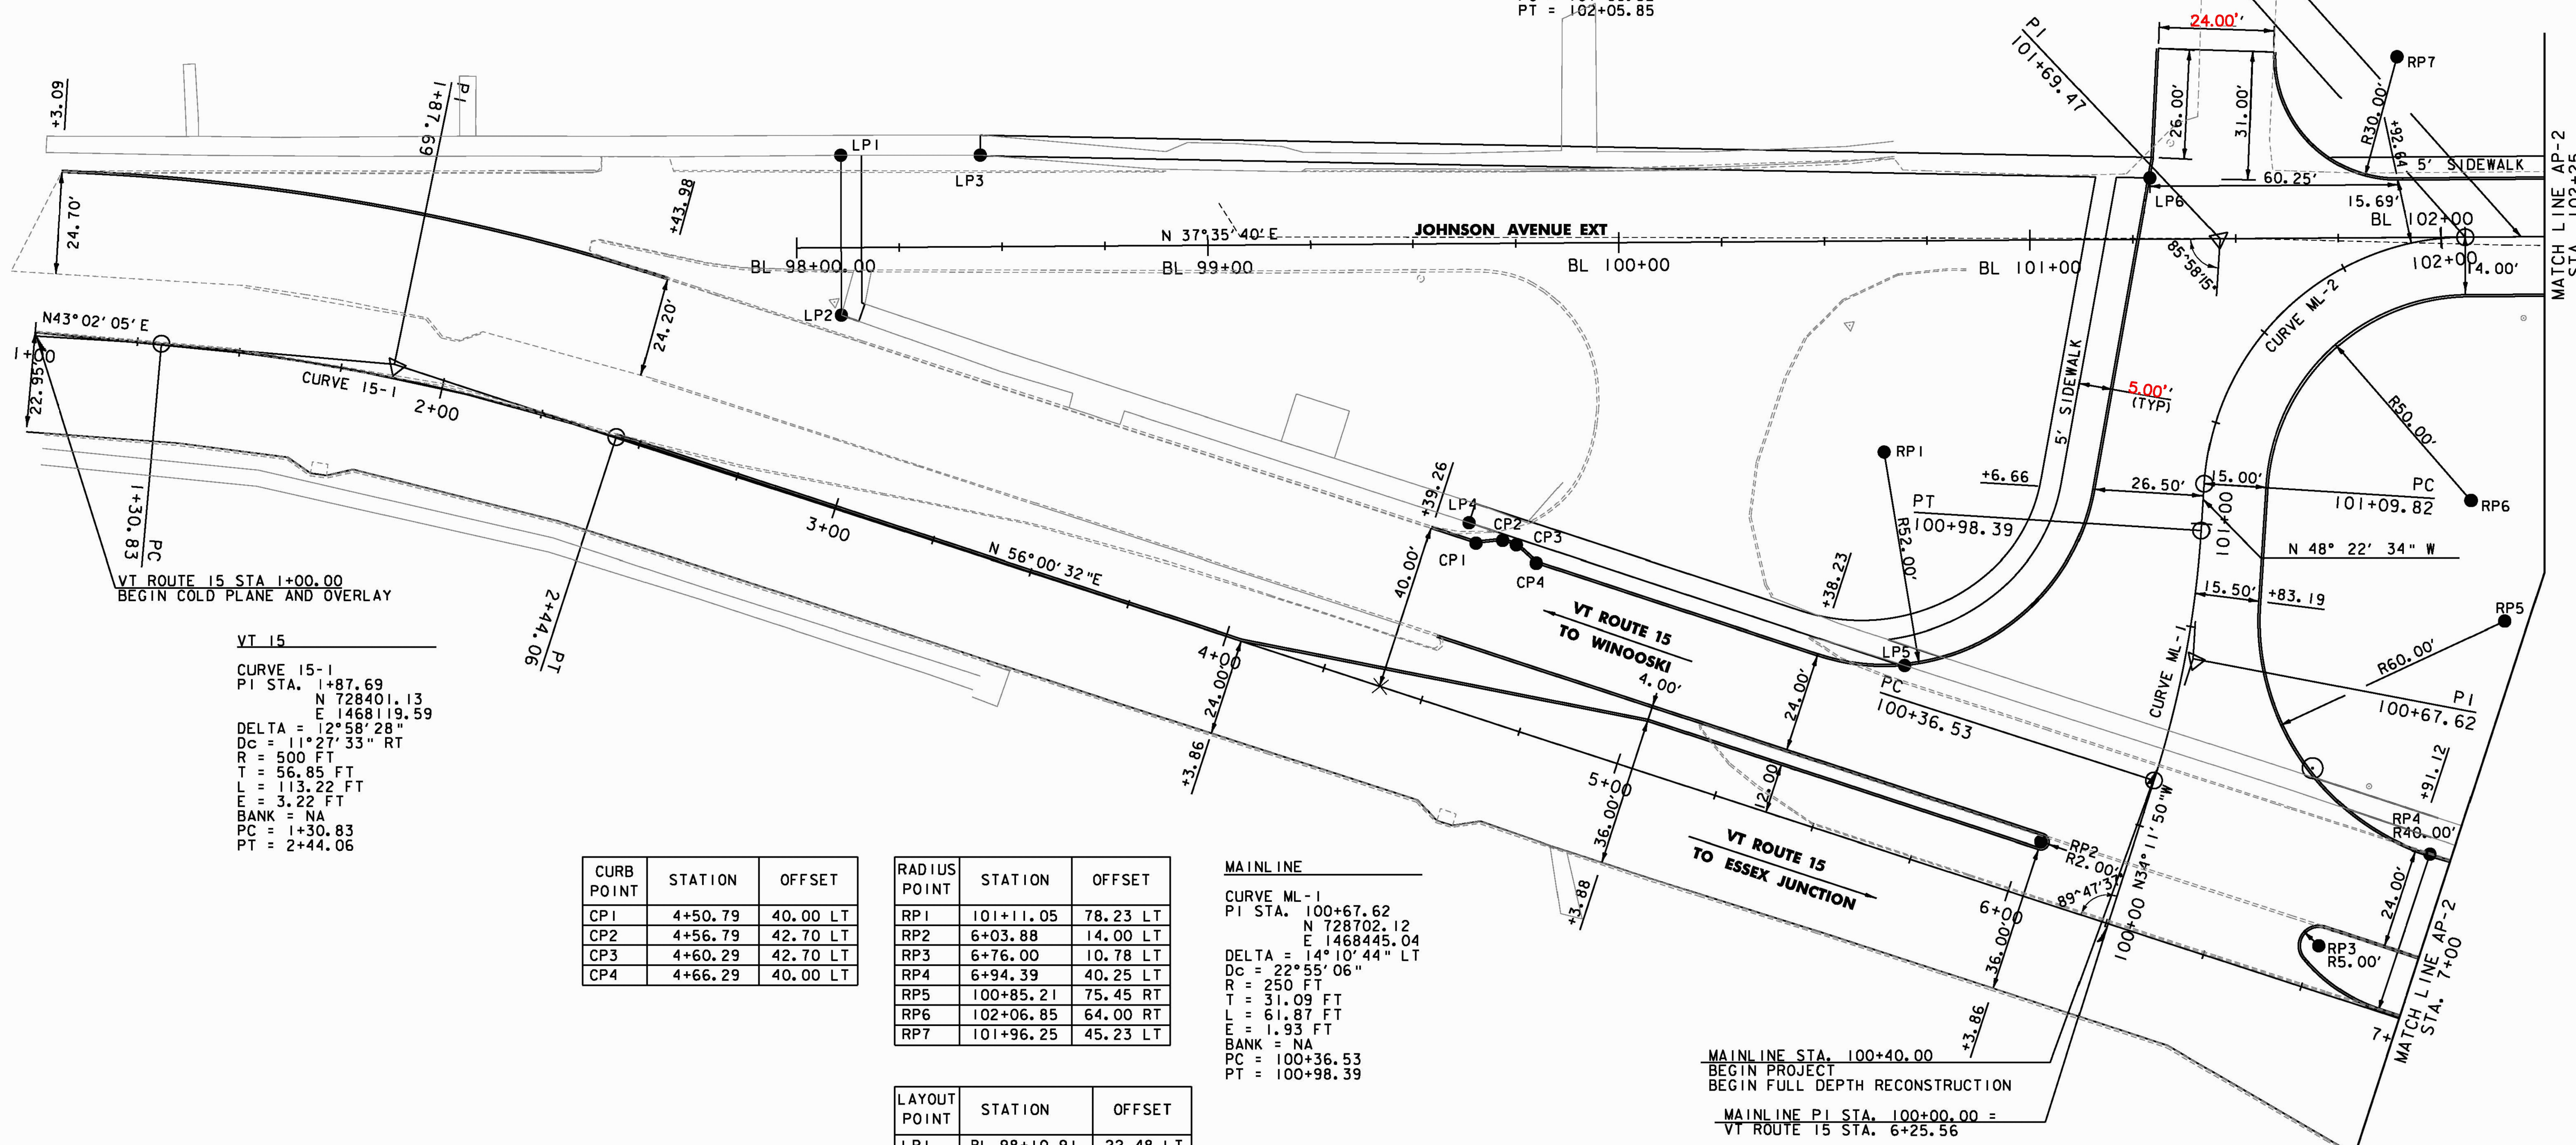

**VT 15**  
 CURVE 15-1  
 PI STA. 1+87.69  
 N 728401.13  
 E 1468119.59  
 DELTA = 12° 58' 28"  
 DC = 11° 27' 33" RT  
 R = 500 FT  
 T = 56.85 FT  
 L = 113.22 FT  
 E = 3.22 FT  
 BANK = NA  
 PC = 1+30.83  
 PT = 2+44.06

CURB POINT	STATION	OFFSET
CP1	4+50.79	40.00 LT
CP2	4+56.79	42.70 LT
CP3	4+60.29	42.70 LT
CP4	4+66.29	40.00 LT

RADIUS POINT	STATION	OFFSET
RP1	101+11.05	78.23 LT
RP2	6+03.88	14.00 LT
RP3	6+76.00	10.78 LT
RP4	6+94.39	40.25 LT
RP5	100+85.21	75.45 RT
RP6	102+06.85	64.00 RT
RP7	101+96.25	45.23 LT

LAYOUT POINT	STATION	OFFSET
LP1	BL 98+10.91	22.48 LT
LP2	BL 98+10.83	16.40 RT
LP3	BL 98+44.85	22.13 LT
LP4	4+47.64	44.39 LT
LP5	5+58.42	44.05 LT
LP6	BL 101+29.25	14.90 LT

**MAINLINE**  
 CURVE ML-1  
 PI STA. 100+67.62  
 N 728702.12  
 E 1468445.04  
 DELTA = 14° 10' 44" LT  
 DC = 22° 55' 06"  
 R = 250 FT  
 T = 31.09 FT  
 L = 61.87 FT  
 E = 1.93 FT  
 BANK = NA  
 PC = 100+36.53  
 PT = 100+98.39

MAINLINE STA. 100+40.00  
 BEGIN PROJECT  
 BEGIN FULL DEPTH RECONSTRUCTION  
 MAINLINE PI STA. 100+00.00 =  
 VT ROUTE 15 STA. 6+25.56

**RECORD DRAWING**  
**DATE: DECEMBER 21, 2012**

PROJECT NAME:	COLCHESTER CAMPUS CONNECTOR
PROJECT NUMBER:	TCSP TCSE (007)
FILE NAME:	... \Plot Files\006-013_All.plt
PROJECT LEADER:	JBL
DESIGNED BY:	TFD
<b>ALIGNMENT PLAN AP-1</b>	
PLOT DATE:	12/2/2010
DRAWN BY:	PZA
CHECKED BY:	GGG
SHEET	6 OF 153

