

RADIUS POINT	STATION	OFFSET
RP20	106+85.13	29.00 LT
RP21	107+58.35	29.00 LT
RP22	107+12.10	24.00 RT
RP23	107+52.60	24.00 RT
RP24	107+75.93	19.00 RT
RP25	108+05.34	19.00 LT
RP26	108+12.35	29.00 LT
RP27	109+01.45	44.00 LT
RP28	109+64.90	21.00 LT
RP28A	109+69.92	21.00 LT
RP29	110+29.69	44.00 LT
RP30	108+94.31	64.00 RT
RP31	110+71.78	69.00 RT

MAINLINE
 CURVE ML-4
 PI STA. 111+11.84
 N 729537.25
 E 1468954.98
 DELTA = 52°07'39" RT
 Dc = 22°55'06"
 R = 250 FT
 T = 122.28 FT
 L = 227.45 FT
 E = 28.30 FT
 BANK = NA
 PC = 109+89.56
 PT = 112+17.01

MAINLINE
 CURVE ML-5
 PI STA. 113+95.71
 N 729541.05
 E 1469255.94
 DELTA = 55°33'55" LT
 Dc = 22°55'06"
 R = 250 FT
 T = 131.71 FT
 L = 242.45 FT
 E = 32.57 FT
 BANK = NA
 PC = 112+64.00
 PT = 115+06.45


STA. 111+45
 50.6' LT

STA. 111+77
 106.7' LT

STA. 112+44.0
 100.3' LT


STA. 112+44
 50.2' LT

REVISION	BY	DATE
UTILITY ACCESS	JBL	04/22/11

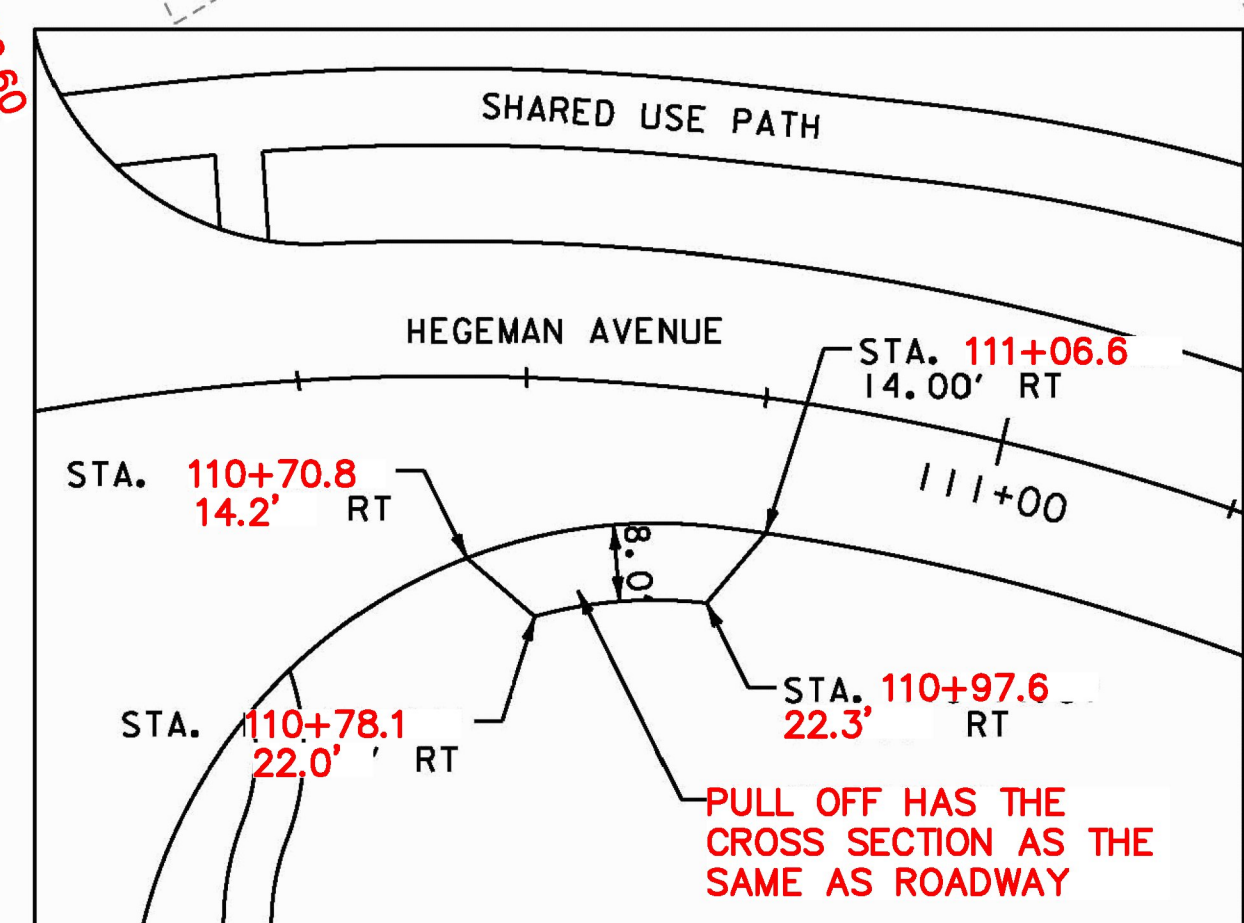

VT NATIONAL GUARD ROAD
 CURVE VTNG-1
 PI STA. 32+16.90
 N 729284.59
 E 1469157.34
 DELTA = 52°37'24" LT
 Dc = 14°19'26"
 R = 400 FT
 T = 197.79 FT
 L = 367.38 FT
 E = 46.23 FT
 BANK = NA
 PC = 30+19.11
 PT = 33+86.49

VT NATIONAL GUARD ROAD
 CURVE VTNG-2
 PI STA. 34+83.06
 N 729402.48
 E 1468887.62
 DELTA = 19°05'55" RT
 Dc = 19°05'55"
 R = 300 FT
 T = 47.12 FT
 L = 93.47 FT
 E = 3.68 FT
 BANK = NA
 PC = 34+35.94
 PT = 35+29.41

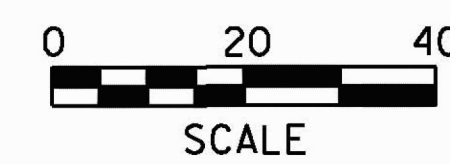

RECORD DRAWING
 DATE: DECEMBER 21, 2012

PROJECT NAME: COLCHESTER CAMPUS CONNECTOR	PLOT DATE: 4/22/2011
PROJECT NUMBER: TCSP TCSE (007)	DRAWN BY: PZA
FILE NAME: ...plotfiles\006-013.Alt.plt	CHECKED BY: GGG
DESIGNED BY: TFD	SHEET 8 OF 153
ALIGNMENT PLAN AP-3	