


RADIUS POINT	STATION	OFFSET
RP32	31+42.14	76.00 LT
RP33	31+68.45	90.00 RT
RP34	30+27.19	25.00 RT

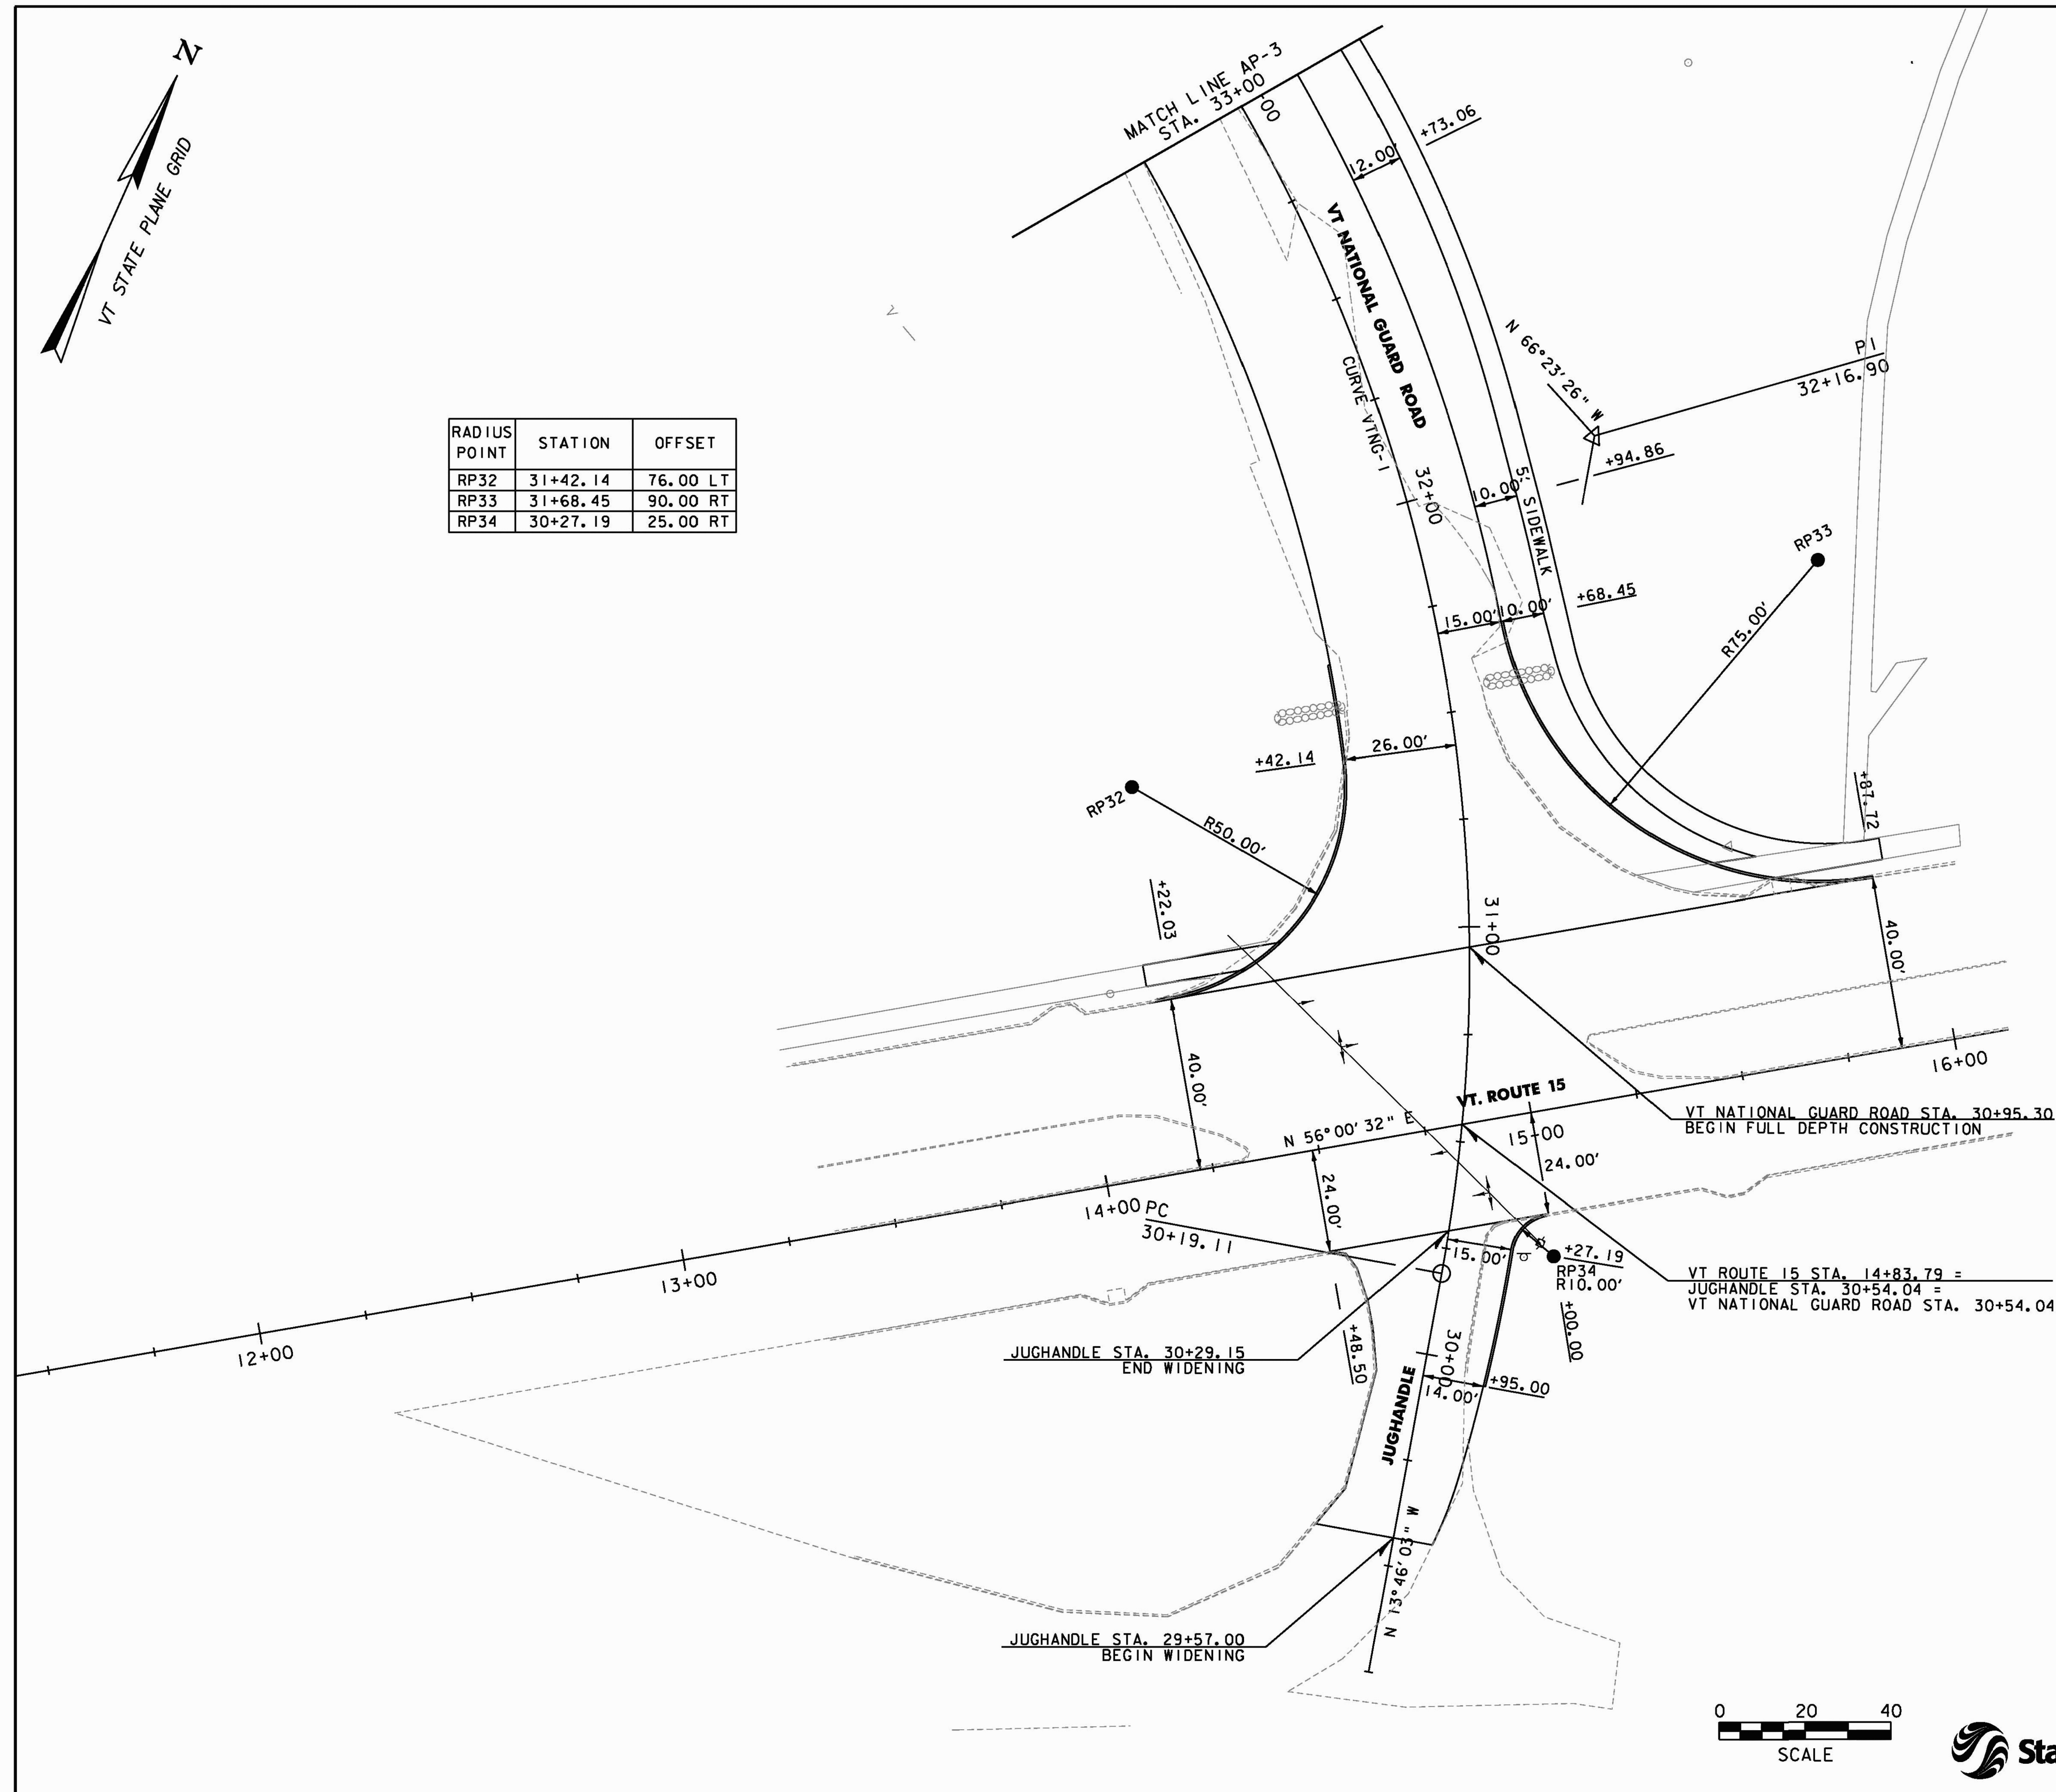

RECORD DRAWING
DATE: DECEMBER 21, 2012

PROJECT NAME:	COLCHESTER CAMPUS CONNECTOR	
PROJECT NUMBER:	TCSP TCSE (007)	
FILE NAME:	...\\Plot Files\006-013_All.plt	PLOT DATE: 12/2/2010
PROJECT LEADER:	JBL	DRAWN BY: PZA
DESIGNED BY:	TFD	CHECKED BY: GGG
ALIGNMENT PLAN	AP-4	SHEET 9 OF 153

