


BARNES AVENUE
 CURVE BA-2
 PI STA. 94+82.26
 N 73° 05' 66.47"
 E 147° 04' 28.41"
 DELTA = 32° 21' 07" RT
 Dc = 57° 17' 45"
 R = 100 FT
 T = 29.01 FT
 L = 56.46 FT
 E = 4.12 FT
 BANK = NA
 PC = 94+53.26
 PT = 95+09.72

RECORD DRAWING
DATE: DECEMBER 21, 2012

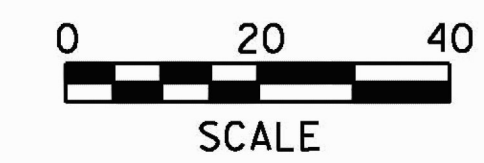

PROJECT NAME: COLCHESTER CAMPUS CONNECTOR	PLOT DATE: 12/2/2010
PROJECT NUMBER: TCSP TCSE (007)	DRAWN BY: PZA
FILE NAME: ...\Plot Files\006-013_All.pxf	CHECKED BY: GGG
PROJECT LEADER: JBL	SHEET 13 OF 153
DESIGNED BY: TFD	
ALIGNMENT PLAN AP-8	