

CONSTRUCT DRIVES		
CL STATION	WIDTH	TYPE
102+75, RT.	36.2	BITUMINOUS, COMMERCIAL
103+13, LT.	22.0	BITUMINOUS, RESIDENTIAL
104+84, RT.	83.0	BITUMINOUS, COMMERCIAL
105+11, LT.	18.3	BITUMINOUS, RESIDENTIAL
105+62, RT.	17.0	BITUMINOUS, RESIDENTIAL
106+58, LT.	24.0	BITUMINOUS, COMMERCIAL

- — — — — EXISTING RIGHT-OF-WAY
- - - - - TAKING WITH ACCESS
- /// /// TAKING WITHOUT ACCESS
- - - - - CZ - - - - - CLEAR ZONE
- - - - - P - - - - - PROPERTY LINE
- ○ ○ TOE OF SLOPE
- △ △ △ TOP OF CUT
- SR (P) ○ SLOPE RIGHT
- CONST. (T) ○ CONST. (P) CONSTRUCTION RIGHT

- (P) PERMANENT
- (T) TEMPORARY
- DR. DRAINAGE RIGHT
- DIT. DITCHING RIGHT
- CH. CHANNEL RIGHT
- DRIVE DRIVE RIGHT
- CUL. CULVERT
- C&T CLEARING & TRIMMING
- SR SLOPE RIGHT
- UE UTILITY EASEMENT
- SL STREET LIGHT
- HH HAND HOLE

FOR CONSTRUCTION NOTES AND DETAILS SEE ROW SHEET 29 OF 94

FOR DRAINAGE NOTES AND DETAILS SEE ROW SHEET 45 OF 94

FOR EROSION CONTROL NOTES AND DETAILS SEE ROW SHEET 53 OF 94

FOR LANDSCAPING NOTES AND DETAILS SEE ROW SHEET 69 OF 94


FOR LIGHTING NOTES AND DETAILS SEE ROW SHEET 88 OF 94

LINES SHOWN ON THIS PLAN AS EXISTING PROPERTY LINES (P/L) ARE BELIEVED TO BE ACCURATE BUT SHOULD NOT BE RELIED UPON FOR PURPOSES UNRELATED TO THE TOWN OF COLCHESTER, VERMONT'S ACQUISITION OF LAND AND RIGHTS FOR THIS PROJECT.


VT ROUTE 15 STA. 8+00  
END COLD PLANE AND OVERLAY

MATCH LINE ROW-1

MATCH LINE ROW-3

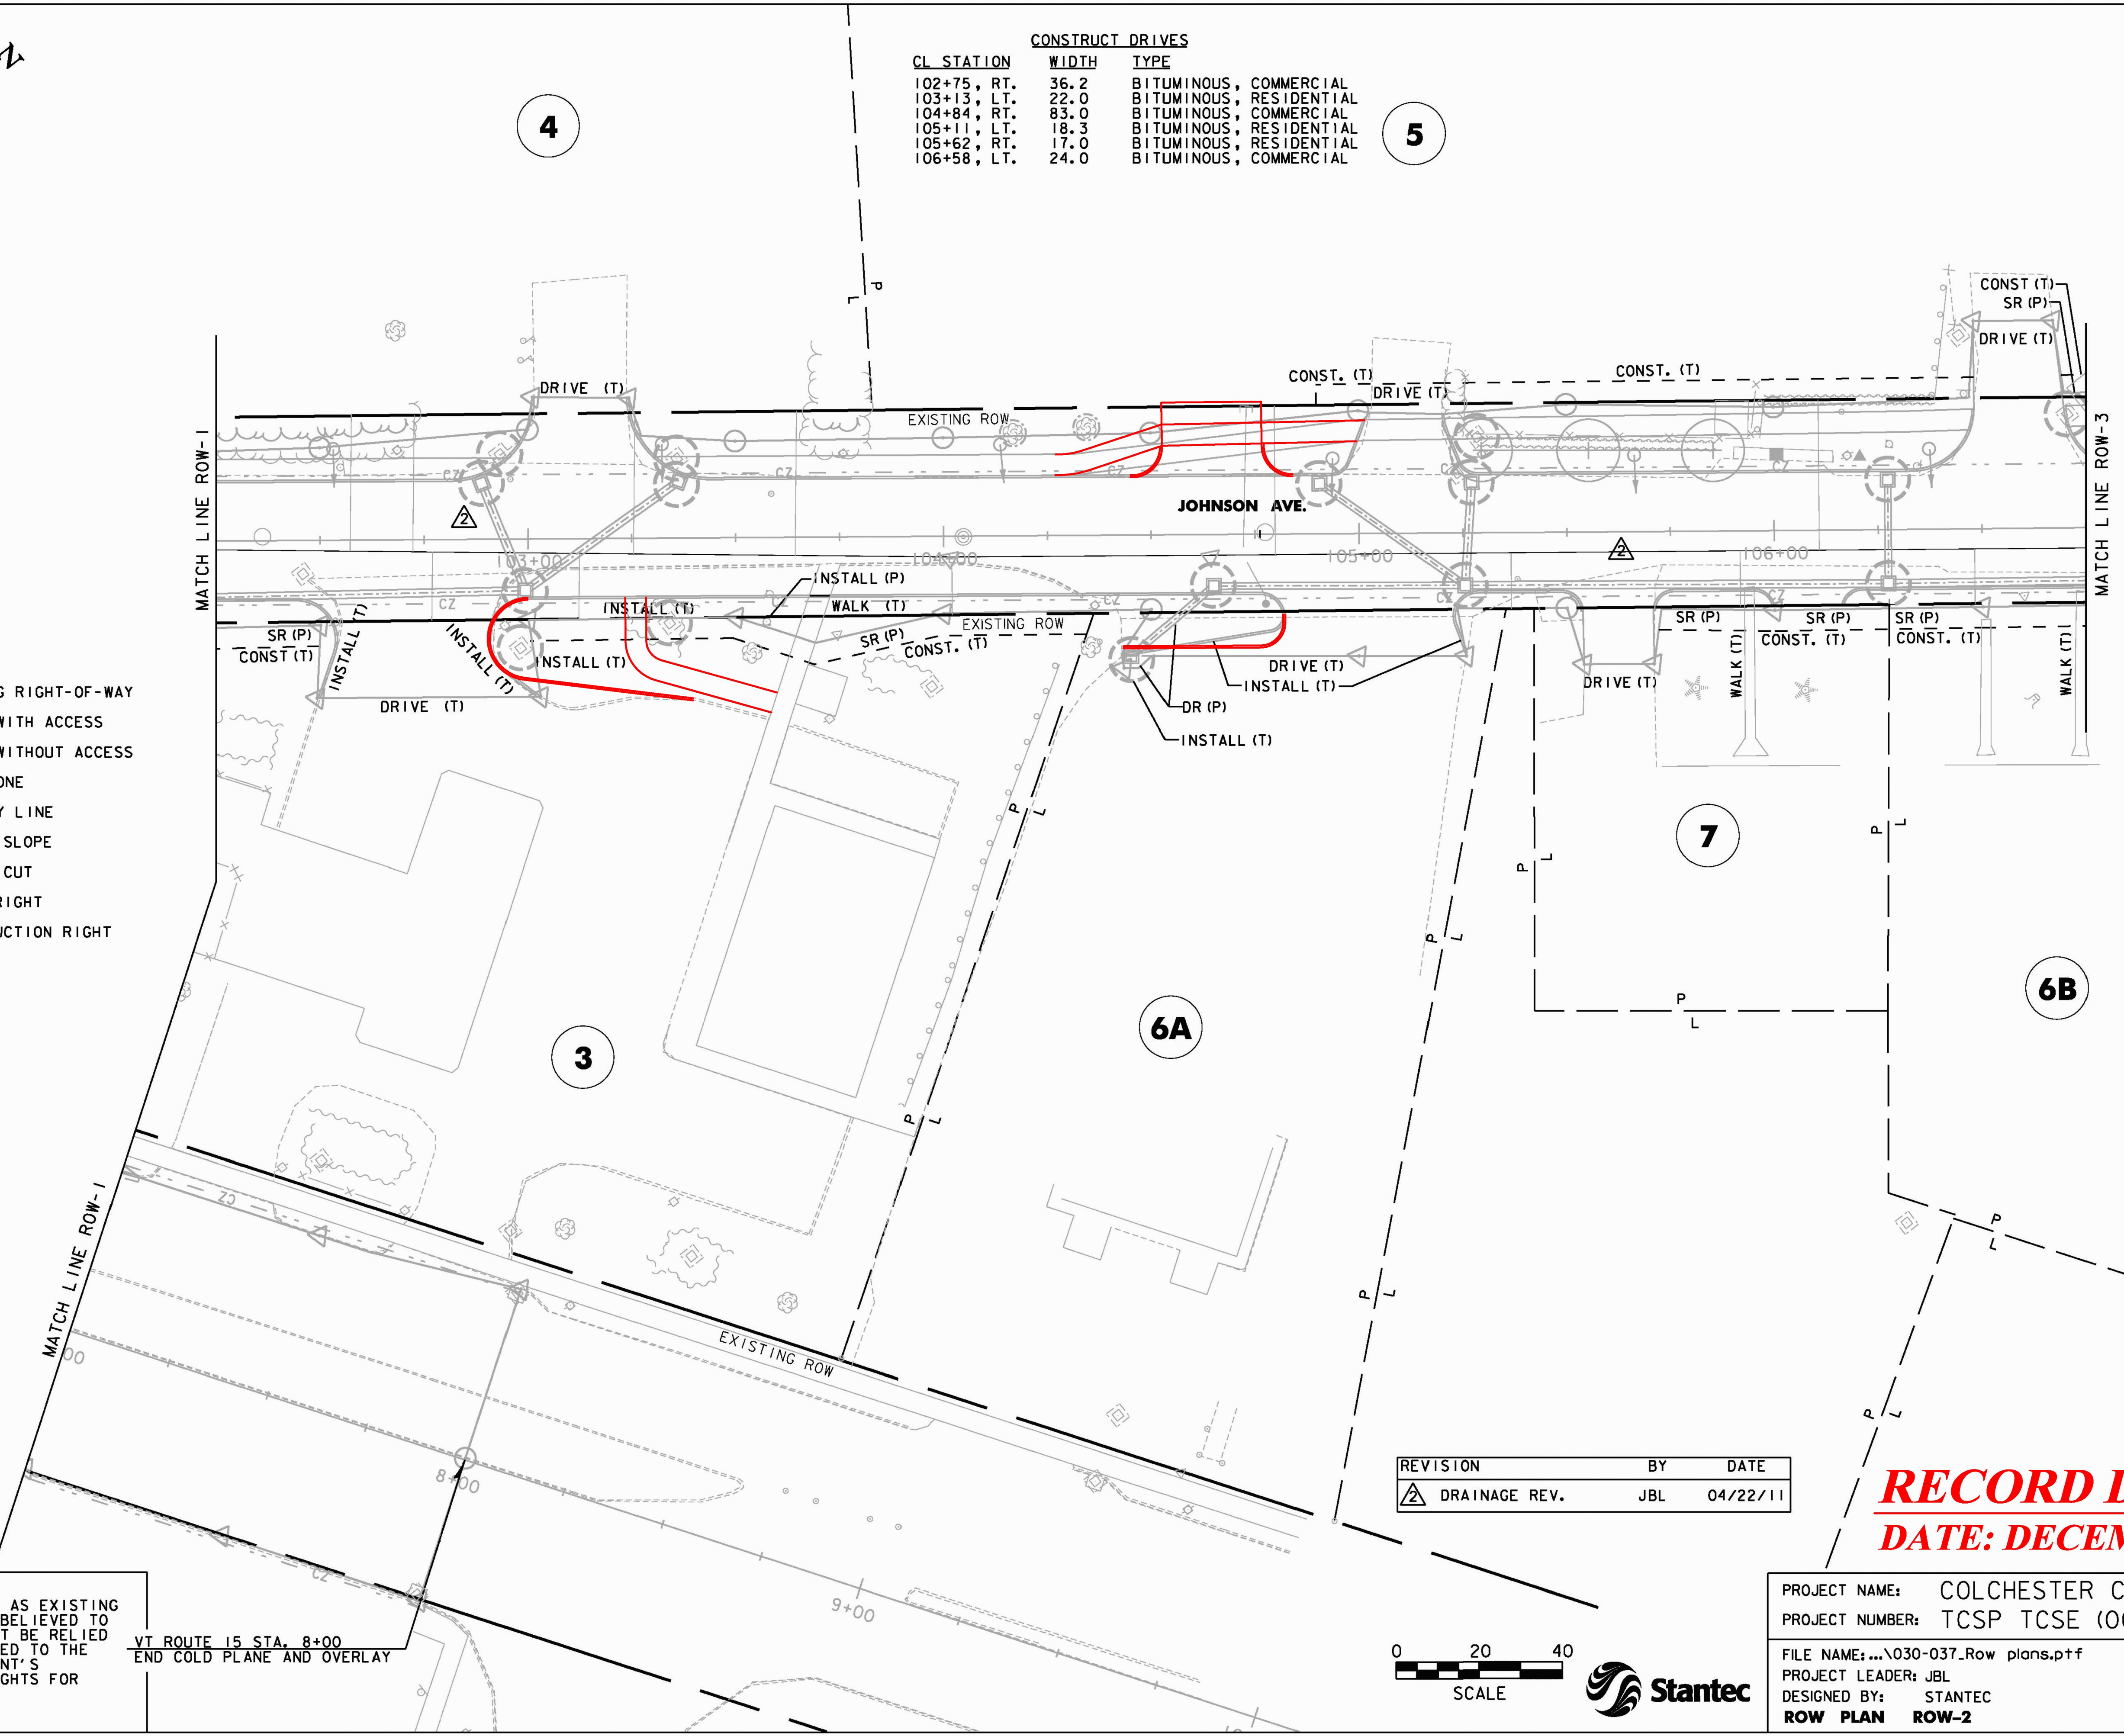

REVISION	BY	DATE
△ DRAINAGE REV.	JBL	04/22/11

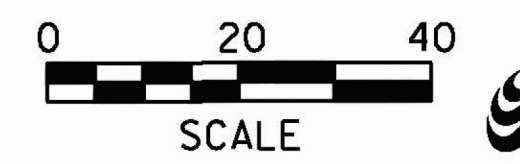

**RECORD DRAWING**  
**DATE: DECEMBER 21, 2012**

PROJECT NAME: COLCHESTER CAMPUS CONNECTOR  
 PROJECT NUMBER: TCSP TCSE (007)  
 FILE NAME: ...030-037\_Row plans.pxf PLOT DATE: 4/22/2011  
 PROJECT LEADER: JBL DRAWN BY: DDH  
 DESIGNED BY: STANTEC CHECKED BY: STANTEC  
**ROW PLAN ROW-2** SHEET 31 OF 153