

FOR CONSTRUCTION NOTES AND DETAILS SEE ROW SHEET 30 OF 94

FOR DRAINAGE NOTES AND DETAILS SEE ROW SHEET 46 OF 94

FOR EROSION CONTROL NOTES AND DETAILS SEE ROW SHEET 54 OF 94

FOR LANDSCAPING NOTES AND DETAILS SEE ROW SHEET 70 OF 94

FOR LIGHTING NOTES AND DETAILS SEE ROW SHEET 89 OF 94

(P) PERMANENT DRIVE  
(T) TEMPORARY DRIVE  
DR. DRAINAGE RIGHT  
DIT. DITCHING RIGHT  
CH. CHANNEL RIGHT  
DRIVE DRIVE RIGHT

CUL. CULVERT  
C&T CLEARING & TRIMMING  
SR SLOPE RIGHT  
UE UTILITY EASEMENT  
SL STREET LIGHT  
HH HAND HOLE

--- EXISTING RIGHT-OF-WAY  
--- TAKING WITH ACCESS  
--- TAKING WITHOUT ACCESS  
--- CZ --- CLEAR ZONE  
--- P --- PROPERTY LINE

○ TOE OF SLOPE  
△ TOP OF CUT  
○ SR (P) SLOPE RIGHT  
--- CONST. (T) --- oc. (P) CONSTRUCTION RIGHT

HIGHWAY (P)  
STA. 112+43.00  
100' LT.

HIGHWAY (P)  
STA. 112+64.00  
50' LT.

HIGHWAY (P)  
STA. 111+77.50'  
50' LT.

HIGHWAY (P)  
STA. 111+77.00  
106' LT.

CL. STATION	WIDTH	TYPE
107+84, LT.	24.0	BITUMINOUS, COMMERCIAL
107+91, RT.	19.4	BITUMINOUS, RESIDENTIAL

5

MOBILE HOME TO BE MOVED BY OTHERS

DRIVE (T)

CONST. (T)

SR (P)

REMOVE (T)

JOHNSON AVE.

SR (P)

CONST. (T)

DRIVE (T)

6B

8

HIGHWAY (P)  
STA. 108+59.60  
18.43' RT.

HIGHWAY (P)  
STA. 33+90.17  
55.64' LT.

2B


9

HIGHWAY (P)  
STA. 32+90.64  
88.62' RT.

1C

LINES SHOWN ON THIS PLAN AS EXISTING PROPERTY LINES (P/L) ARE BELIEVED TO BE ACCURATE BUT SHOULD NOT BE RELIED UPON FOR PURPOSES UNRELATED TO THE TOWN OF COLCHESTER, VERMONT'S ACQUISITION OF LAND AND RIGHTS FOR THIS PROJECT.

REVISION	BY	DATE
△ ADDENDUM - 1	JBL	01/24/11
△ DRAINAGE REV. UTILITY ACCESS	JBL	04/22/11

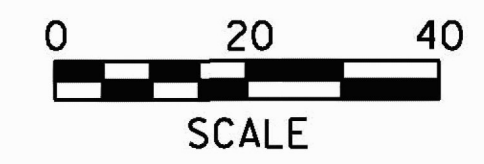

**RECORD DRAWING**  
**DATE: DECEMBER 21, 2012**

PROJECT NAME: COLCHESTER CAMPUS CONNECTOR  
PROJECT NUMBER: TCSP TCSE (007)

FILE NAME: ...030-037\_Row plans.prf  
PROJECT LEADER: JBL  
DESIGNED BY: STANTEC  
**ROW PLAN ROW-3**

PLOT DATE: 4/22/2011  
DRAWN BY: DDH  
CHECKED BY: STANTEC  
SHEET 32 OF 153