



FOR CONSTRUCTION NOTES AND DETAILS SEE ROW SHEET 31 OF 94	FOR LANDSCAPING NOTES AND DETAILS SEE ROW SHEET 71 OF 94
FOR DRAINAGE NOTES AND DETAILS SEE ROW SHEET 47 OF 94	FOR LIGHTING NOTES AND DETAILS SEE ROW SHEET 90 OF 94
FOR EROSION CONTROL NOTES AND DETAILS SEE ROW SHEET 55 OF 94	

(P)	PERMANENT	CUL.	CULVERT
(T)	TEMPORARY	C&T	CLEARING & TRIMMING
DR.	DRAINAGE RIGHT	SR	SLOPE RIGHT
DIT.	DITCHING RIGHT	UE	UTILITY EASEMENT
CH.	CHANNEL RIGHT	SL	STREET LIGHT
DRIVE	DRIVE RIGHT	HH	HAND HOLE

---	---	---	---	EXISTING RIGHT-OF-WAY
---	---	---	---	TAKING WITH ACCESS
---	---	---	---	TAKING WITHOUT ACCESS
---	---	---	---	CZ --- CLEAR ZONE
---	P	---	---	PROPERTY LINE
---	---	---	---	TOE OF SLOPE
---	---	---	---	TOP OF CUT
---	---	---	---	SLOPE RIGHT
---	---	---	---	CONSTRUCTION RIGHT

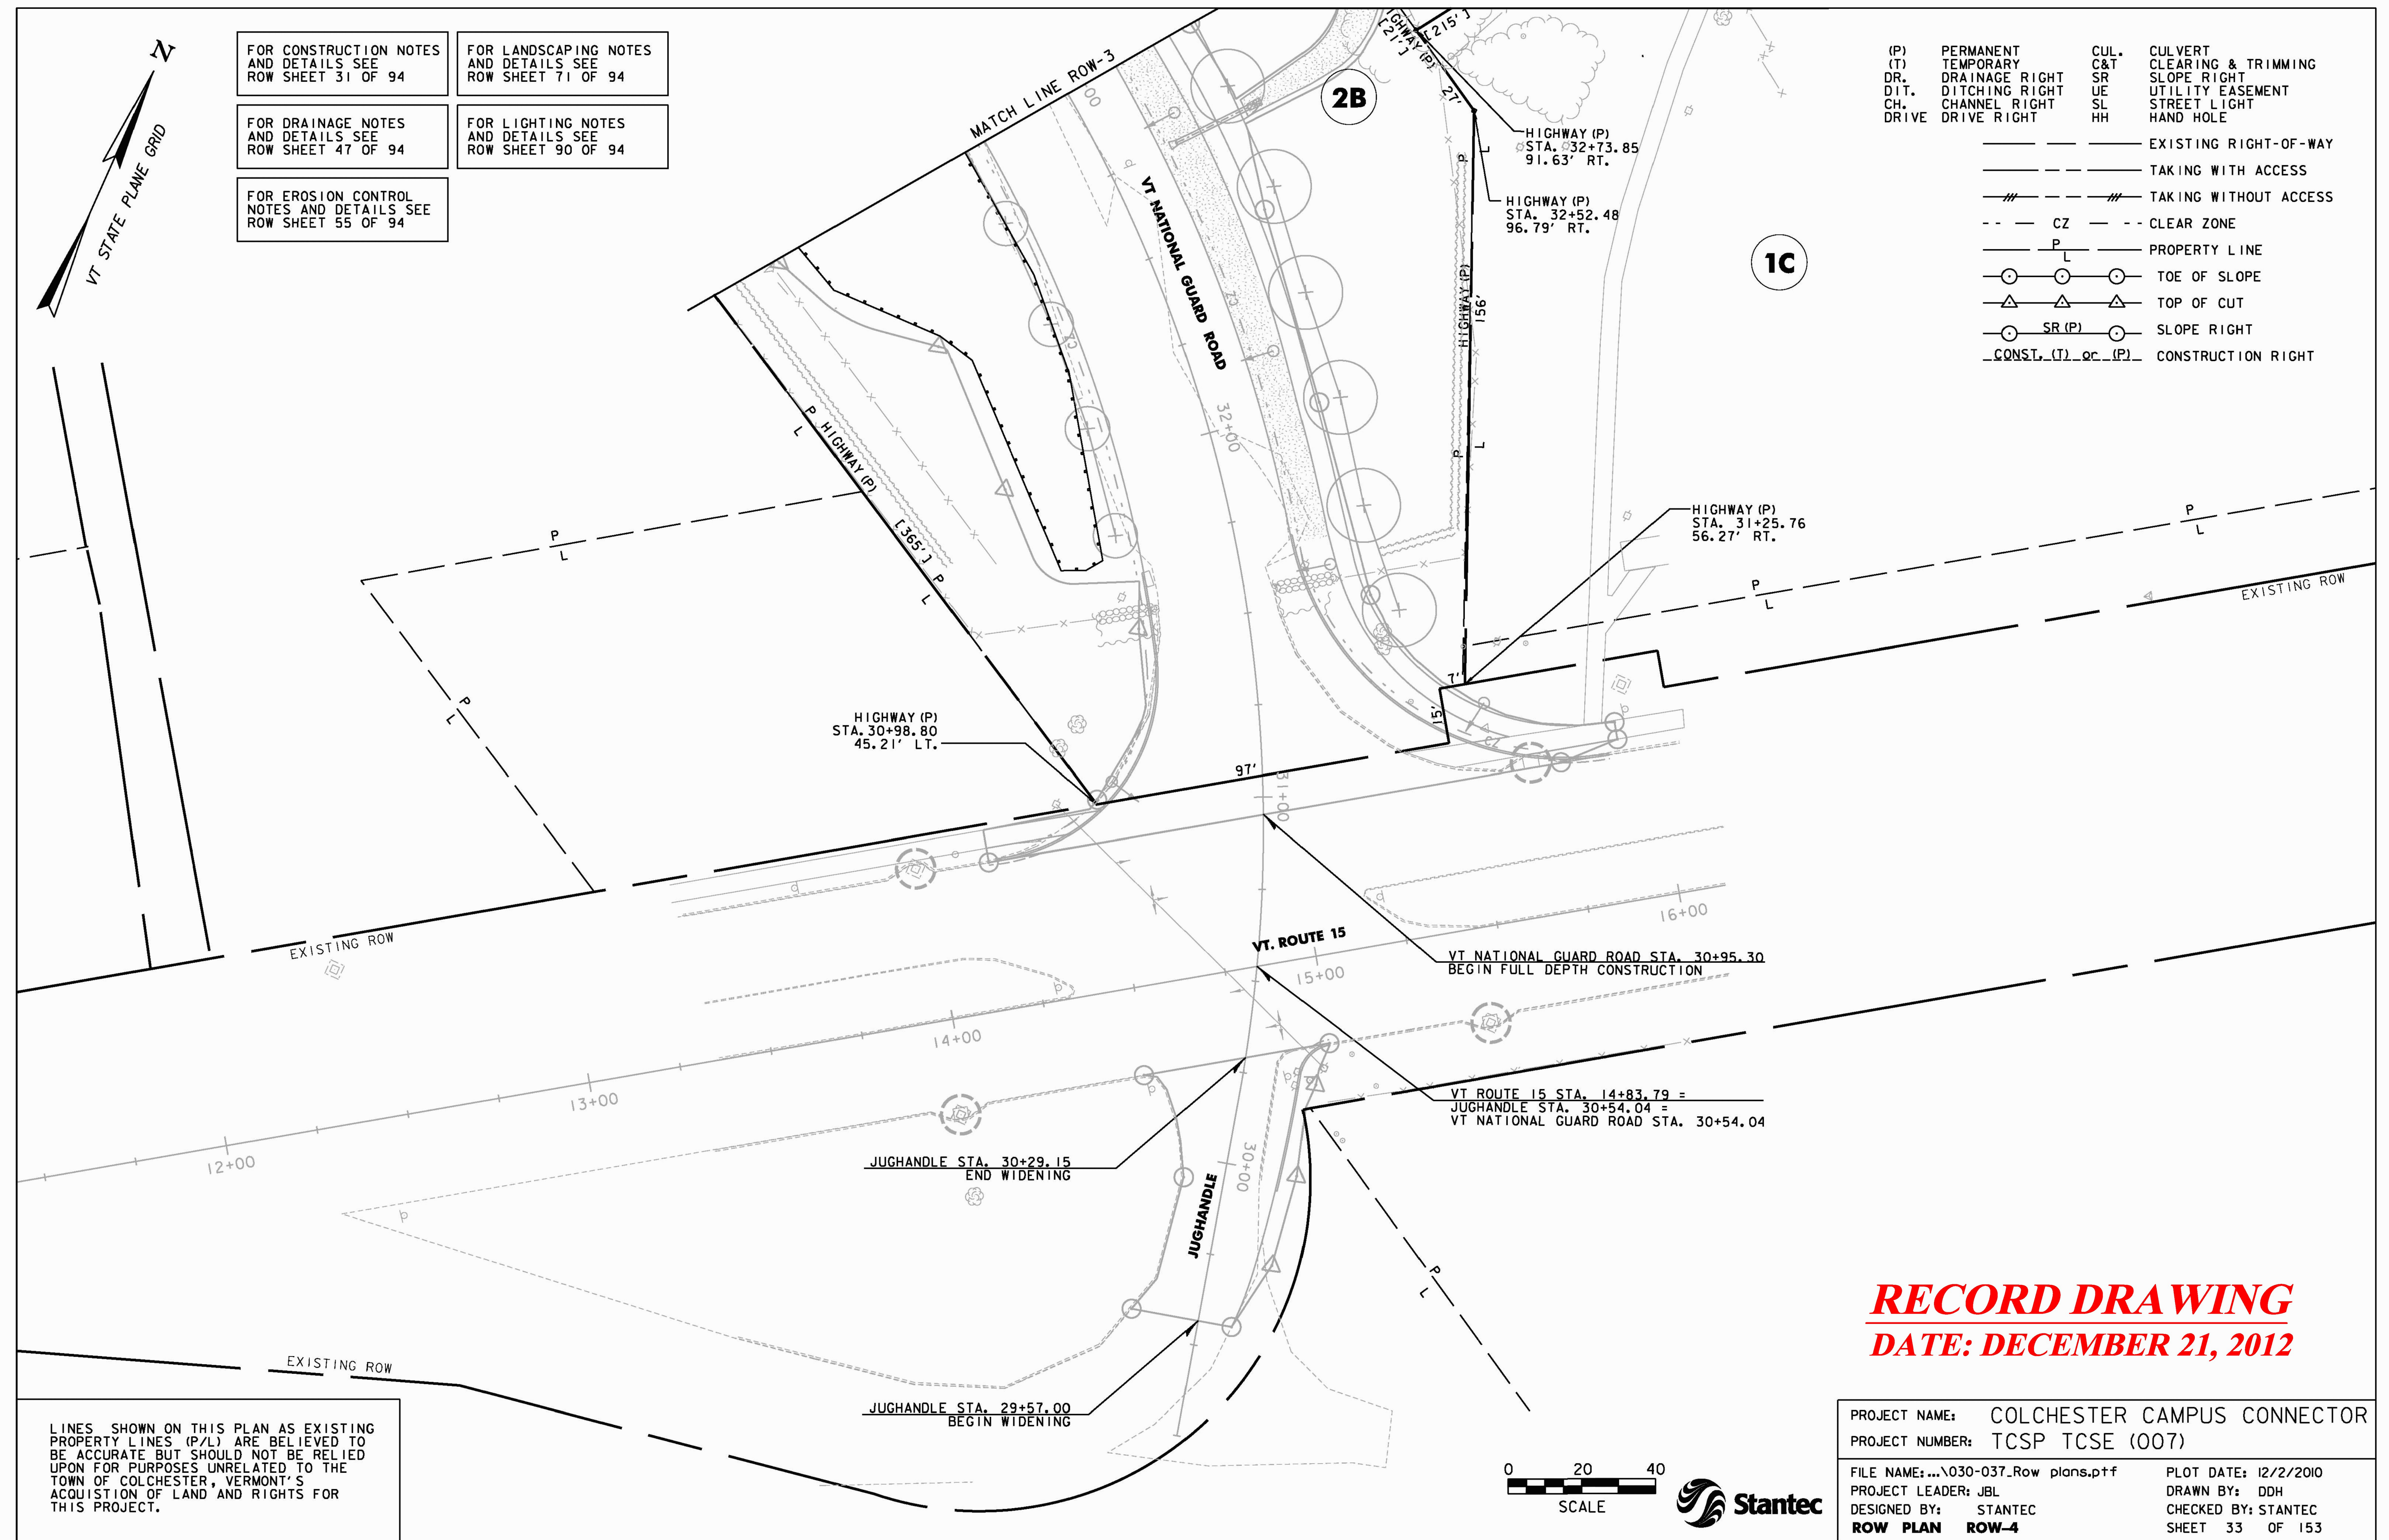

LINES SHOWN ON THIS PLAN AS EXISTING PROPERTY LINES (P/L) ARE BELIEVED TO BE ACCURATE BUT SHOULD NOT BE RELIED UPON FOR PURPOSES UNRELATED TO THE TOWN OF COLCHESTER, VERMONT'S ACQUISITION OF LAND AND RIGHTS FOR THIS PROJECT.

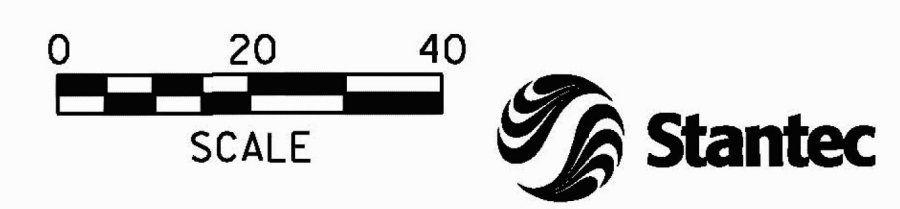

RECORD DRAWING
DATE: DECEMBER 21, 2012

PROJECT NAME: COLCHESTER CAMPUS CONNECTOR	PLOT DATE: 12/2/2010
PROJECT NUMBER: TCSP TCSE (007)	DRAWN BY: DDH
FILE NAME: ...030-037.Row plans.ptf	CHECKED BY: STANTEC
DESIGNED BY: STANTEC	SHEET 33 OF 153
ROW PLAN ROW-4	