

CONSTRUCT DRIVES		
CL STATION	WIDTH	TYPE
114+07, RT.	22.0	BITUMINOUS RESIDENTIAL
118+15, RT.	35.6	BITUMINOUS RESIDENTIAL

FOR CONSTRUCTION NOTES AND DETAILS SEE ROW SHEET 32 OF 94

FOR DRAINAGE NOTES AND DETAILS SEE ROW SHEET 48 OF 94

FOR EROSION CONTROL NOTES AND DETAILS SEE ROW SHEET 56 OF 94


FOR LANDSCAPING NOTES AND DETAILS SEE ROW SHEET 72 OF 94

FOR LIGHTING NOTES AND DETAILS SEE ROW SHEET 91 OF 94

LINES SHOWN ON THIS PLAN AS EXISTING PROPERTY LINES (P/L) ARE BELIEVED TO BE ACCURATE BUT SHOULD NOT BE RELIED UPON FOR PURPOSES UNRELATED TO THE TOWN OF COLCHESTER, VERMONT'S ACQUISITION OF LAND AND RIGHTS FOR THIS PROJECT.

- — — — — EXISTING RIGHT-OF-WAY
- - - - - TAKING WITH ACCESS
- /// - - - /// TAKING WITHOUT ACCESS
- - - CZ - - - CLEAR ZONE
- P — — — — — PROPERTY LINE
- — ○ — ○ TOE OF SLOPE
- △ — △ — △ TOP OF CUT
- — SR (P) — ○ SLOPE RIGHT
- CONST. (T) — DR. (P) — CONSTRUCTION RIGHT
- (P) PERMANENT
- (T) TEMPORARY
- DR. DRAINAGE RIGHT
- DIT. DITCHING RIGHT
- CH. CHANNEL RIGHT
- DRIVE DRIVE RIGHT
- CUL. CULVERT
- C&T CLEARING & TRIMMING
- SR SLOPE RIGHT
- UE UTILITY EASEMENT
- SL STREET LIGHT
- HH HAND HOLE

RECORD DRAWING
DATE: DECEMBER 21, 2012

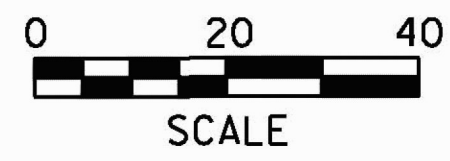

PROJECT NAME: COLCHESTER CAMPUS CONNECTOR	PLOT DATE: 12/2/2010
PROJECT NUMBER: TCSP TCSE (007)	DRAWN BY: DDH
FILE NAME: ...030-037_Row plans.ptf	CHECKED BY: STANTEC
DESIGNED BY: STANTEC	SHEET 34 OF 153
ROW PLAN ROW-5	