


CONSTRUCT DRIVES		
CL. STATION	WIDTH	TYPE
125+84, RT.	33.3	BITUMINOUS RESIDENTIAL

- FOR CONSTRUCTION NOTES AND DETAILS SEE ROW SHEET 34 OF 94
- FOR DRAINAGE NOTES AND DETAILS SEE ROW SHEET 50 OF 94
- FOR EROSION CONTROL NOTES AND DETAILS SEE ROW SHEET 58 OF 94
- FOR LANDSCAPING NOTES AND DETAILS SEE ROW SHEET 74 OF 94
- FOR LIGHTING NOTES AND DETAILS SEE ROW SHEET 93 OF 94

- — — — — EXISTING RIGHT-OF-WAY
- - - - - TAKING WITH ACCESS
- /// /// TAKING WITHOUT ACCESS
- - - - - CZ — — — CLEAR ZONE
- P — — — PROPERTY LINE
- ○ ○ TOE OF SLOPE
- △ △ △ TOP OF CUT
- SR (P) ○ SLOPE RIGHT
- CONSL (T) - or - (P) - CONSTRUCTION RIGHT
- (P) PERMANENT
- (T) TEMPORARY
- DR. DRAINAGE RIGHT
- DIT. DITCHING RIGHT
- CH. CHANNEL RIGHT
- DRIVE DRIVE RIGHT
- CUL. CULVERT
- C&T CLEARING & TRIMMING
- SR SLOPE RIGHT
- UE UTILITY EASEMENT
- SL STREET LIGHT
- HH HAND HOLE

LINES SHOWN ON THIS PLAN AS EXISTING PROPERTY LINES (P/L) ARE BELIEVED TO BE ACCURATE BUT SHOULD NOT BE RELIED UPON FOR PURPOSES UNRELATED TO THE TOWN OF COLCHESTER, VERMONT'S ACQUISITION OF LAND AND RIGHTS FOR THIS PROJECT.

RECORD DRAWING
DATE: DECEMBER 21, 2012

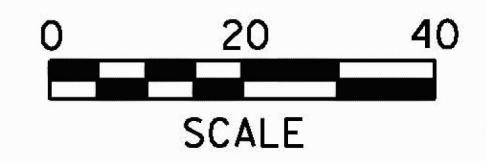

PROJECT NAME: COLCHESTER CAMPUS CONNECTOR	PLOT DATE: 12/2/2010
PROJECT NUMBER: TCSP TCSE (007)	DRAWN BY: DDH
FILE NAME: ...030-037_Row plans.pxf	CHECKED BY: STANTEC
DESIGNED BY: STANTEC	SHEET 36 OF 153
ROW PLAN ROW-7	