

FOR CONSTRUCTION NOTES
AND DETAILS SEE
ROW SHEET 35 OF 94

FOR DRAINAGE NOTES
AND DETAILS SEE
ROW SHEET 51 OF 94


FOR EROSION CONTROL
NOTES AND DETAILS SEE
ROW SHEET 59 OF 94

FOR LANDSCAPING NOTES
AND DETAILS SEE
ROW SHEET 75 OF 94

FOR LIGHTING NOTES
AND DETAILS SEE
ROW SHEET 94 OF 94

LINES SHOWN ON THIS PLAN AS EXISTING
PROPERTY LINES (P/L) ARE BELIEVED TO
BE ACCURATE BUT SHOULD NOT BE RELIED
UPON FOR PURPOSES UNRELATED TO THE
TOWN OF COLCHESTER, VERMONT'S
ACQUISITION OF LAND AND RIGHTS FOR
THIS PROJECT.

- — — — — EXISTING RIGHT-OF-WAY
 - — — — — TAKING WITH ACCESS
 - — — — — TAKING WITHOUT ACCESS
 - - - - - CZ - - - - - CLEAR ZONE
 - - - - - P/L - - - - - PROPERTY LINE
 - ○ ○ ○ ○ TOE OF SLOPE
 - △ △ △ △ △ TOP OF CUT
 - SR (P) ○ SLOPE RIGHT
 - CONST. (T) or (P) — CONSTRUCTION RIGHT
- | | |
|-------|---------------------|
| (P) | PERMANENT |
| (T) | TEMPORARY |
| DR. | DRAINAGE RIGHT |
| DIT. | DITCHING RIGHT |
| CH. | CHANNEL RIGHT |
| DRIVE | DRIVE RIGHT |
| CUL. | CULVERT |
| C&T | CLEARING & TRIMMING |
| SR | SLOPE RIGHT |
| UE | UTILITY EASEMENT |
| SL | STREET LIGHT |
| HH | HAND HOLE |

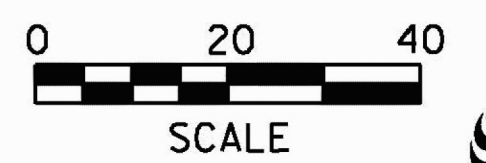

RECORD DRAWING
DATE: DECEMBER 21, 2012

PROJECT NAME:	COLCHESTER CAMPUS CONNECTOR
PROJECT NUMBER:	TCSP TCSE (007)
FILE NAME: ...030-037_Row plans.ptf	PLOT DATE: 12/2/2010
PROJECT LEADER: JBL	DRAWN BY: DDH
DESIGNED BY: STANTEC	CHECKED BY: STANTEC
ROW PLAN ROW-8	SHEET 37 OF 153