


NOTE: THESE TWO WATER VALVES AND THIS WATER PIPE SHOWN APPROXIMATE ONLY AND NOT MARKED IN THE FIELD. SEE TIE SHEET THIS DRAWING.

REVISION	BY	DATE
△ ADDED WATER LINE	JBL	04/22/11

**RECORD DRAWING**  
**DATE: DECEMBER 21, 2012**

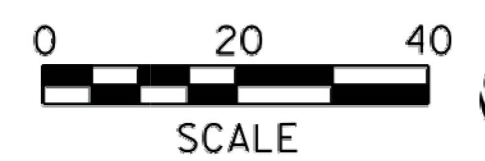

PROJECT NAME:	COLCHESTER CAMPUS CONNECTOR
PROJECT NUMBER:	TCSP TCSE (007)
FILE NAME: ...\\038-045_Existplans.pxf	PLOT DATE: 4/22/2011
PROJECT LEADER: JBL	DRAWN BY: PZA
DESIGNED BY: TFD	CHECKED BY: GGG
<b>EXISTING CONDITIONS PLAN EC-1</b>	SHEET 38 OF 153

MATCH LINE EC-2  
STA. 102+25

MATCH LINE EC-2  
STA. 7+00