


**RECORD DRAWING**  
**DATE: DECEMBER 21, 2012**

REVISION	BY	DATE
△ ADDENDUM - 1	JBL	01/24/11
△ ADDED WATER LINE METER VAULT	JBL	04/22/11

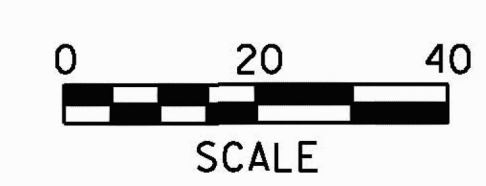

PROJECT NAME:	COLCHESTER CAMPUS CONNECTOR
PROJECT NUMBER:	TCSP TCSE (007)
FILE NAME: ...\038-045_Existplans.ptf	PLOT DATE: 4/22/2011
PROJECT LEADER: JBL	DRAWN BY: PZA
DESIGNED BY: TFD	CHECKED BY: GGG
<b>EXISTING CONDITIONS PLAN EC-3</b>	SHEET 40 OF 153

MATCH LINE EC-3  
 STA. 99+00

MATCH LINE EC-4  
 STA. 33+00

MATCH LINE EC-5  
 STA. 112+75