


RECORD DRAWING
DATE: DECEMBER 21, 2012

REVISION	BY	DATE
△ ADDENDUM - 1	JBL	01/24/11

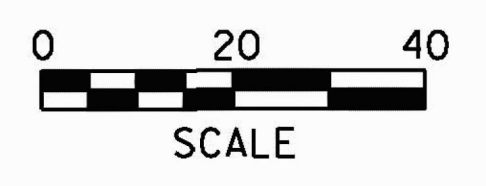

PROJECT NAME:	COLCHESTER CAMPUS CONNECTOR		
PROJECT NUMBER:	TCSP TCSE (007)		
FILE NAME:	...038-045_Extplans.pfx	PLOT DATE:	4/22/2011
PROJECT LEADER:	JBL	DRAWN BY:	PZA
DESIGNED BY:	TFD	CHECKED BY:	GGG
EXISTING CONDITIONS PLAN EC-4		SHEET	41 OF 153