


RECORD DRAWING
DATE: DECEMBER 21, 2012

REVISION	BY	DATE
△ ADDENDUM - 1	JBL	01/24/11

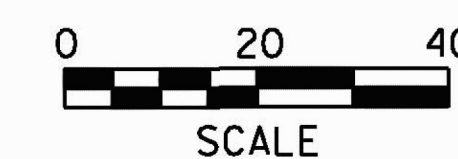

PROJECT NAME:	COLCHESTER CAMPUS CONNECTOR		
PROJECT NUMBER:	TCSP TCSE (007)		
FILE NAME: ...038-045-Existplans.ptf	PLOT DATE:	4/22/2011	
PROJECT LEADER: JBL	DRAWN BY:	PZA	
DESIGNED BY: TFD	CHECKED BY:	GGG	
EXISTING CONDITIONS PLAN EC-6	SHEET	43	OF 153