


RECORD DRAWING
DATE: DECEMBER 21, 2012

REVISION	BY	DATE
▲ ADDENDUM - 1	JBL	01/24/11

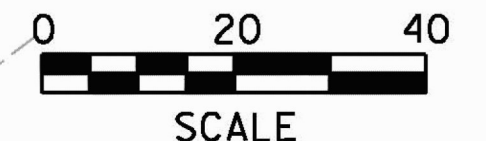

PROJECT NAME:	COLCHESTER CAMPUS CONNECTOR
PROJECT NUMBER:	TCSP TCSE (007)
FILE NAME: ...038-045_Existplans.pxf	PLOT DATE: 4/22/2011
PROJECT LEADER: JBL	DRAWN BY: PZA
DESIGNED BY: TFD	CHECKED BY: GGG
EXISTING CONDITIONS PLAN EC-8	SHEET 45 OF 153