

EPSC NOTES


1. THESE PLANS SHOW A CONCEPTUAL EROSION CONTROL PLAN, THE CONTRACTOR MUST SUBMIT A TEMPORARY EROSION CONTROL PLAN FOR APPROVAL.
2. TEMPORARY EROSION CONTROL MEASURES ARE CONCEPTUALLY SHOWN. THE CONTRACTOR MAY RELOCATE TEMPORARY MEASURES TO IMPROVE EROSION CONTROL WITH APPROVAL OF THE RESIDENT ENGINEER AND ON SITE COORDINATOR. SILT FENCE SHALL NOT BE INSTALLED ACROSS CONTOURS.
3. THE CONTRACTOR SHALL USE OTHER TEMPORARY EROSION CONTROL MEASURES AS NECESSITATED BY THE SEQUENCE OF CONSTRUCTION OR AS DIRECTED BY THE RESIDENT ENGINEER AND ON SITE COORDINATOR.
4. REFER TO EROSION CONTROL DETAIL SHEETS FOR ADDITIONAL DETAILS.

LEGEND	
	VEHICLE TRACKING PAD
	DISTURBED AREAS REQUIRING REVEGETATION
	EROSION MATTING
	SILT FENCE
	INLET PROTECTION
	STONE OUTLET PROTECTION
	PROJECT DEMARCATION FENCING
	EXISTING CONTOURS
	PROPOSED CONTOURS

ON SITE PLAN COORDINATOR

REVISION	BY	DATE
△ DRAINAGE REV.	JBL	04/22/11

RECORD DRAWING
DATE: DECEMBER 21, 2012

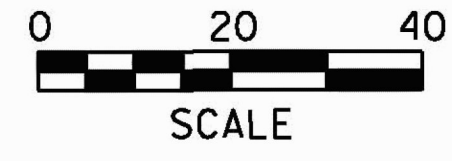

PROJECT NAME:	COLCHESTER CAMPUS CONNECTOR	FILE NAME:	...\\plotfiles\046-053_EPSC.prf	PLOT DATE:	4/22/2011
PROJECT NUMBER:	TCSP TCSE (007)	PROJECT LEADER:	JBL	DRAWN BY:	PZA
		DESIGNED BY:	TFD	CHECKED BY:	GGG
		EPSC PLAN	EPSC-1		SHEET 46 OF 153