


VT ROUTE 15 STA. 8+00
END COLD PLANE AND OVERLAY

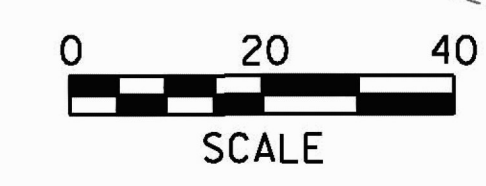

REVISION	BY	DATE
△ DRAINAGE REV.	JBL	04/22/11

RECORD DRAWING
DATE: DECEMBER 21, 2012

PROJECT NAME:	COLCHESTER CAMPUS CONNECTOR	PLOT DATE:	4/22/2011
PROJECT NUMBER:	TCSP TCSE (007)	DRAWN BY:	PZA
FILE NAME:	...plotfiles\046-053.EPSC.ptf	CHECKED BY:	GGG
PROJECT LEADER:	JBL	SHEET	47 OF 153
DESIGNED BY:	TFD		
EPSC PLAN	EPSC-2		

