



PER THE DRAWING DETAILS
THE BOTTOM OF THE INFILTRATION
GALLERY WAS NOT TOPSOILED OR SEEDED

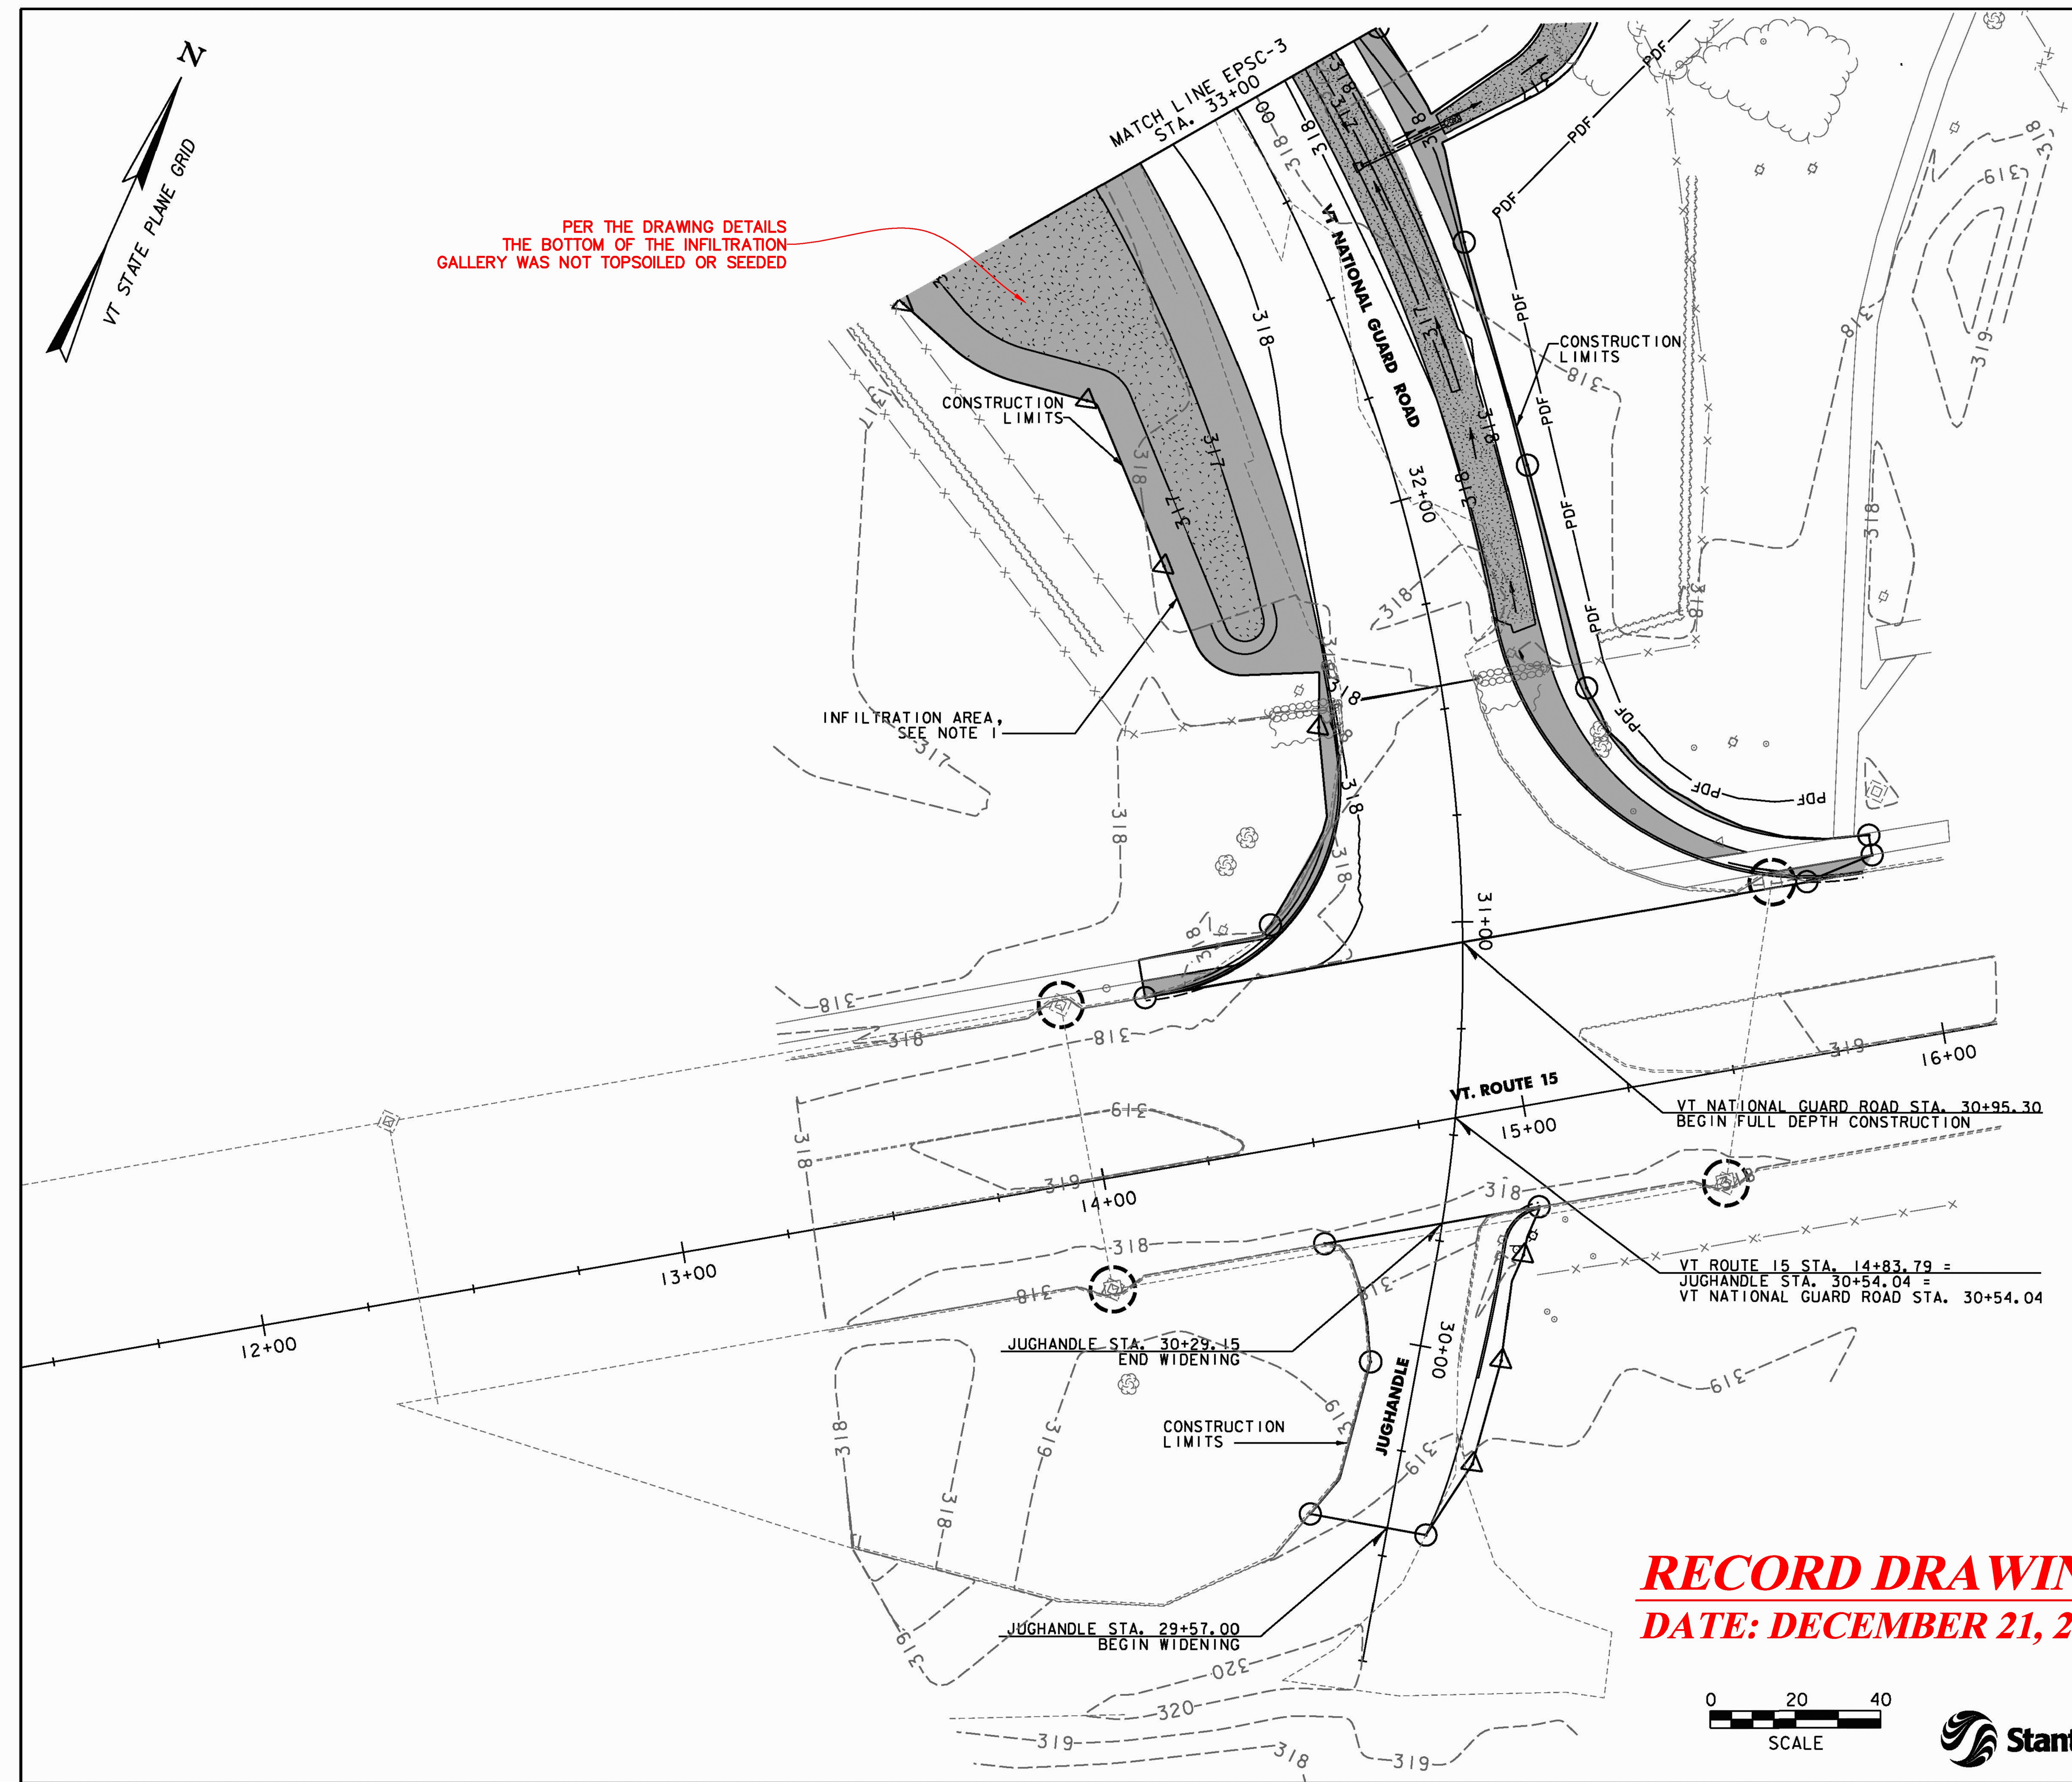

RECORD DRAWING
DATE: DECEMBER 21, 2012

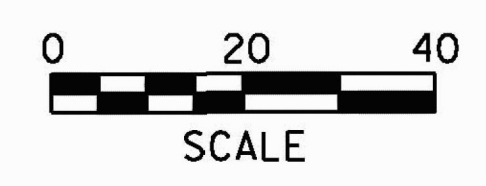

- EPSC NOTES:
1. INFILTRATION AREAS/BASINS SHALL BE CONSTRUCTED AFTER FINAL STABILIZATION OF ROADWAY CONSTRUCTION TO PREVENT SILT AND SEDIMENT BUILDUP IN BASIN DURING CONSTRUCTION. INFILTRATION BASIN AREAS SHALL NOT BE USED FOR STAGING OR STOCKPILING OF MATERIALS DURING CONSTRUCTION.
 2. SILT FENCE SHALL BE PLACED ALONG PERIMETER OF INFILTRATION AREAS THAT RECEIVE UPSTREAM RUNOFF. SILT FENCE SHALL REMAIN IN PLACE UNTIL AREA SURROUNDING INFILTRATION AREAS HAS BEEN PERMANENTLY STABILIZED.

PROJECT NAME:	COLCHESTER CAMPUS CONNECTOR
PROJECT NUMBER:	TCSP TCSE (007)
FILE NAME: ...\\Plot Files\046-053_EPSC.pxf	PLOT DATE: 12/2/2010
PROJECT LEADER: JBL	DRAWN BY: PZA
DESIGNED BY: TFD	CHECKED BY: GGG
EPSC PLAN EPSC-4	SHEET 49 OF 153