


PER THE DRAWING DETAILS THE BOTTOM OF THE INFILTRATION GALLERY WAS NOT TOPSOILED OR SEEDED

- EPSC NOTES:
1. INFILTRATION AREAS/BASINS SHALL BE CONSTRUCTED AFTER FINAL STABILIZATION OF ROADWAY CONSTRUCTION TO PREVENT SILT AND SEDIMENT BUILDUP IN BASIN DURING CONSTRUCTION. INFILTRATION BASIN AREAS SHALL NOT BE USED FOR STAGING OR STOCKPILING OF MATERIALS DURING CONSTRUCTION.
 2. SILT FENCE SHALL BE PLACED ALONG PERIMETER OF INFILTRATION AREAS THAT RECEIVE UPSTREAM RUNOFF. SILT FENCE SHALL REMAIN IN PLACE UNTIL AREA SURROUNDING INFILTRATION AREAS HAS BEEN PERMANENTLY STABILIZED.

RECORD DRAWING
DATE: DECEMBER 21, 2012

FIELD CHANGE #3 - SEPTEMBER 2, 2011
 REVISED PATH GRADING

PROJECT NAME: COLCHESTER CAMPUS CONNECTOR
 PROJECT NUMBER: TCSP TCSE (007)

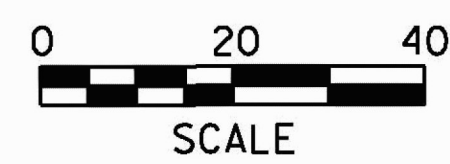

FILE NAME: ...046-053_EPSC.pxf PLOT DATE: 9/7/2011
 PROJECT LEADER: JBL DRAWN BY: PZA
 DESIGNED BY: TFD CHECKED BY: GGG
EPSC PLAN EPSC-5 SHEET 50 OF 155