


**EPSC NOTES:**

1. INFILTRATION AREAS/BASINS SHALL BE CONSTRUCTED AFTER FINAL STABILIZATION OF ROADWAY CONSTRUCTION TO PREVENT SILT AND SEDIMENT BUILDUP IN BASIN DURING CONSTRUCTION. INFILTRATION BASIN AREAS SHALL NOT BE USED FOR STAGING OR STOCKPILING OF MATERIALS DURING CONSTRUCTION.
2. SILT FENCE SHALL BE PLACED ALONG PERIMETER OF INFILTRATION AREAS THAT RECEIVE UPSTREAM RUNOFF. SILT FENCE SHALL REMAIN IN PLACE UNTIL AREA SURROUNDING INFILTRATION AREAS HAS BEEN PERMANENTLY STABILIZED.

**RECORD DRAWING**  
**DATE: DECEMBER 21, 2012**

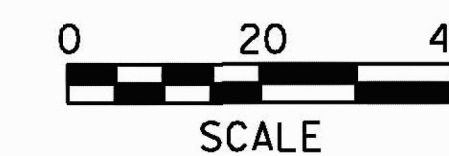

FIELD CHANGE #3 - SEPTEMBER 2, 2011  
 MOVED NATIONAL GUARD FENCE, INFILTRATION  
 BASIN AND REVISED PATH GRADING

PROJECT NAME: COLCHESTER CAMPUS CONNECTOR  
 PROJECT NUMBER: TCSP TCSE (007)

FILE NAME: ...046-053\_EPSC.prf PLOT DATE: 9/7/2011  
 PROJECT LEADER: JBL DRAWN BY: PZA  
 DESIGNED BY: TFD CHECKED BY: GGG  
**EPSC PLAN EPSC-6** SHEET 51 OF 155