


RECORD DRAWING
DATE: DECEMBER 21, 2012

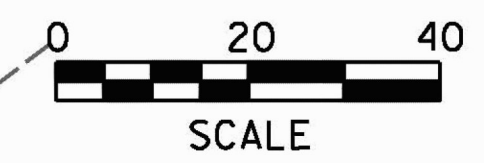

PROJECT NAME:	COLCHESTER CAMPUS CONNECTOR
PROJECT NUMBER:	TCSP TCSE (007)
FILE NAME: ...\\Plot Files\046-053_EPSC.pxf	PLOT DATE: 12/2/2010
PROJECT LEADER: JBL	DRAWN BY: PZA
DESIGNED BY: TFD	CHECKED BY: GGG
EPSC PLAN EPSC-8	SHEET 53 OF 153