

REMOVAL OF EXISTING FENCE
 STA. 113+60, 33.0' RT - STA. 118+75, 14.0' LT

REMOVING AND RESETTING FENCE (WOOD STOCKADE)
~~STA. 114+30, 37.0' RT - STA. 117+69, 20.0' RT~~
~~STA. 118+60, 20.0' RT - STA. 118+75, 20.0' RT~~

SPECIAL PROVISION (CHAIN-LINK FENCE WITH BARBED WIRE, 8 FEET 6 FEET)
 STA. 112+75, 50.5' LT - STA. 118+75, 110.5' LT

PORTLAND CEMENT CONCRETE SIDEWALK, 5 INCH
 STA. 113+79, 50.5' RT - STA. 113+98, 39.0' RT
 STA. 113+72, 14.0' LT - STA. 113+72, 24.0' LT
 STA. 113+72, 15.0' RT - STA. 113+84, 45.0' RT

BITUMINOUS CONCRETE SIDEWALK
 LOCATION WIDTH
 STA. 112+75, 28.0' LT - STA. 118+75, 30.0' LT 8.5'

CONSTRUCT SIDEWALK RAMP

CL STATION	OFFSET	TYPE
113+72	15.0' LT	I
113+72	15.0' RT	I
113+99	39.0' RT	I


ADJUST ELEVATION OF VALVE BOX

ALIGNMENT	STATION	OFFSET
MAINLINE	117+53.9	15.3' LT
	117+54.0	13.9' LT
	117+73.7	23.0' LT
	118+40.8	14.4' RT
	118+46.8	14.4' RT

CONSTRUCT DRIVES

CL STATION	WIDTH	TYPE
114+07, RT.	22.0	BITUMINOUS, RESIDENTIAL
118+15, RT.	35.6	BITUMINOUS, RESIDENTIAL

SPECIAL PROVISION (SAW CUTTING SURFACES AND PAVEMENTS)
 STA. 114+02, 52.0' RT - STA. 114+19, 44.0' RT - 22'
 STA. 117+95, 38.0' RT - STA. 118+30, 37.0' RT - 36'

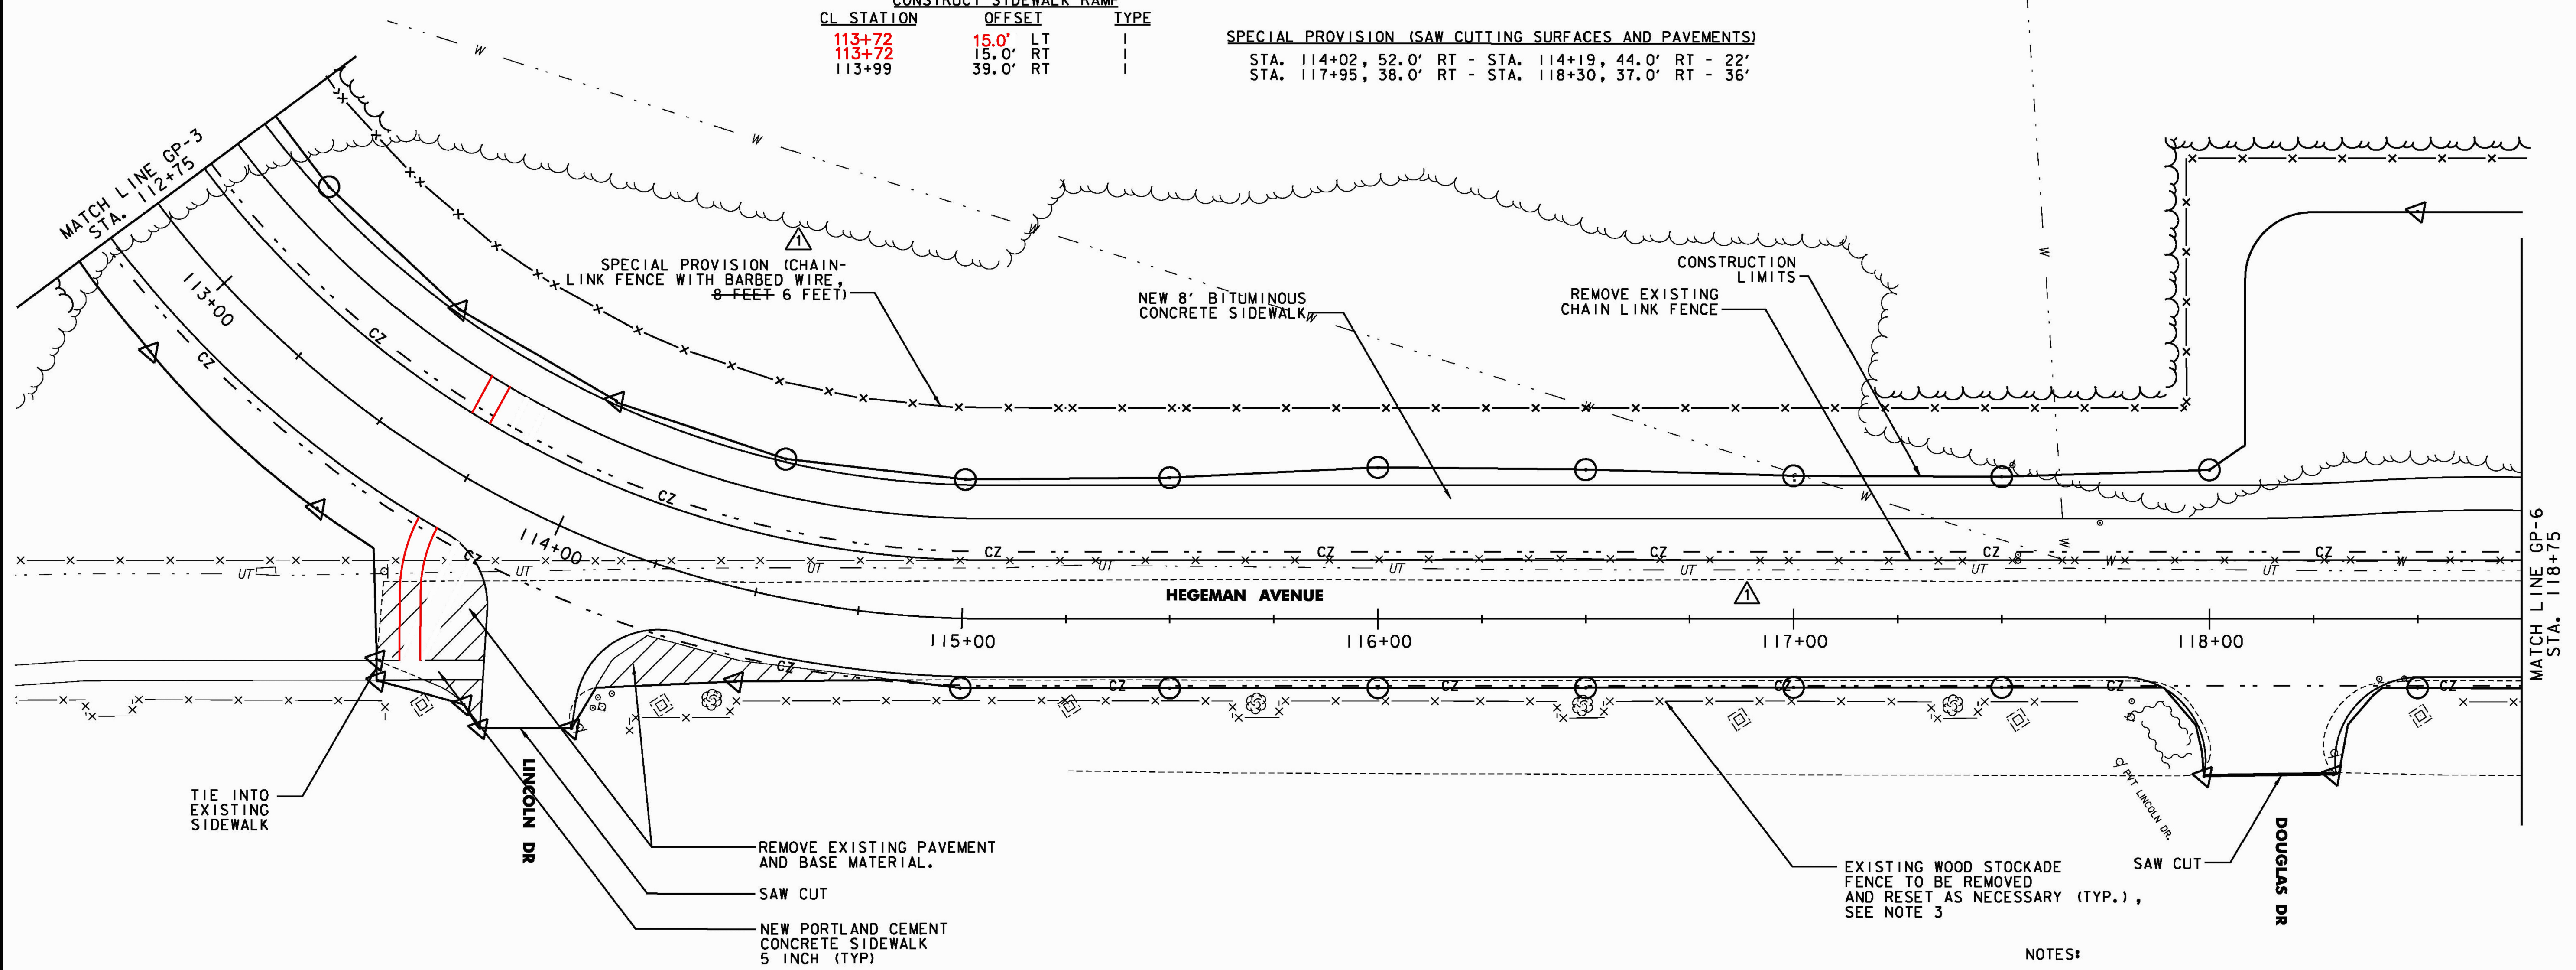

- NOTES:**
- SIDEWALK RAMPS SHALL BE CONSTRUCTED IN ACCORDANCE WITH VTRANS STANDARDS C-3A AND C-3B.
 - DETECTABLE WARNING SURFACES SHALL BE CONSTRUCTED AT SIDEWALK RAMPS IN ACCORDANCE WITH VTRANS STANDARDS C-3A AND C-3B. DETECTABLE WARNING SURFACES SHALL BE CAST IRON. SEE SIGNING/PVT MARKING PLANS FOR LOCATIONS.
 - EXISTING WOOD STOCKADE FENCE SHALL BE REMOVED AS NECESSARY TO AVOID DAMAGE DURING CONSTRUCTION. FENCE SHALL BE RESET BACK TO ORIGINAL LOCATION PRIOR TO COMPLETION OF CONSTRUCTION. CONTRACTOR SHALL OBTAIN APPROVAL FROM RESIDENT ENGINEER PRIOR TO REMOVING FENCE.

LEGEND:


SYMBOL	DESCRIPTION
	EXCAVATION OF SURFACES AND PAVEMENTS
	COLD PLANE AND OVERLAY
	REMOVAL OF MEDIAN ISLAND

RECORD DRAWING
DATE: DECEMBER 21, 2012

FIELD CHANGE #3 - SEPTEMBER 2, 2011
 REVISED CUT/FILL LIMIT

REVISION

REVISION	BY	DATE
ADDENDUM - I	JBL	01/24/11

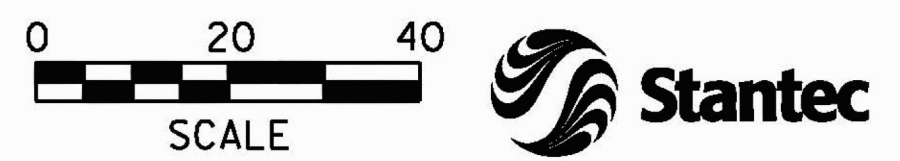

PROJECT NAME: COLCHESTER CAMPUS CONNECTOR
 PROJECT NUMBER: TCSP TCSE (007)

FILE NAME: ...058-065_Gen.ptf PLOT DATE: 9/7/2011
 PROJECT LEADER: JBL DRAWN BY: PZA
 DESIGNED BY: TFD CHECKED BY: GGG
GENERAL PLAN GP-5 SHEET 62 OF 155