

**PORTLAND CEMENT CONCRETE SIDEWALK, 5 INCH**  
 STA. 91+00, 16.8' RT - STA. 92+00, 16.9' RT  
 STA. 127+92, 24' LT - STA. 128+01, 24' LT

**CAST-IN-PLACE CONCRETE CURB, TYPE B**  
 STA. 127+77, 14.6' LT - STA. 128+11, 55.0' LT  
 STA. 127+78, 14.5' RT - STA. 128+25, 44.6' RT

**BITUMINOUS CONCRETE SIDEWALK**  
 LOCATION WIDTH  
 STA. 124+50, 28.0' LT - STA. 127+92, 28.0' LT 8.5'

**REMOVING AND RESETTING FENCE (WOOD STOCKADE)**  
~~STA. 124+50, 20.0' RT - STA. 125+35, 25.0' RT~~  
~~STA. 126+28, 20.7' RT - STA. 127+92, 29.2' RT~~

**REMOVAL OF EXISTING CURB**  
 STA. 127+88, 10.5' LT - STA. 128+11, 55.0' LT  
 STA. 127+93, 15.8' RT - STA. 128+25, 44.6' RT

**REMOVAL OF EXISTING FENCE**  
 STA. 124+50, 28.0' LT - STA. 127+54, 51.0' LT  
 STA. 126+27, 50.0' LT - STA. 126+31, 33.0' LT

**ADJUST ELEVATION OF VALVE BOX**

ALIGNMENT	STATION	OFFSET
MAINLINE	126+02.1	17.1' RT
	128+16.9	19.2' LT
	128+18.1	12.3' LT

**CONSTRUCT DRIVES**


CL STATION	WIDTH	TYPE
125+84, RT.	33.3	BITUMINOUS, RESIDENTIAL

**SPECIAL PROVISION (CHAIN-LINK FENCE WITH BARBED WIRE, 8 FEET 6 FEET)**  
 STA. 124+50, 110.5' LT - STA. 127+54, 50.5' LT

**SPECIAL PROVISION (SAW CUTTING SURFACES AND PAVEMENTS)**  
 STA. 125+68, 34.0' RT - STA. 126+01, 34.0' RT - 33'  
 STA. 90+17, 11.0' RT - STA. 91+17, 11.0' RT - 100'

**CONSTRUCT SIDEWALK RAMP**

CL STATION	OFFSET	TYPE
128+04	27.50' LT	I
128+15	24.80' RT	I

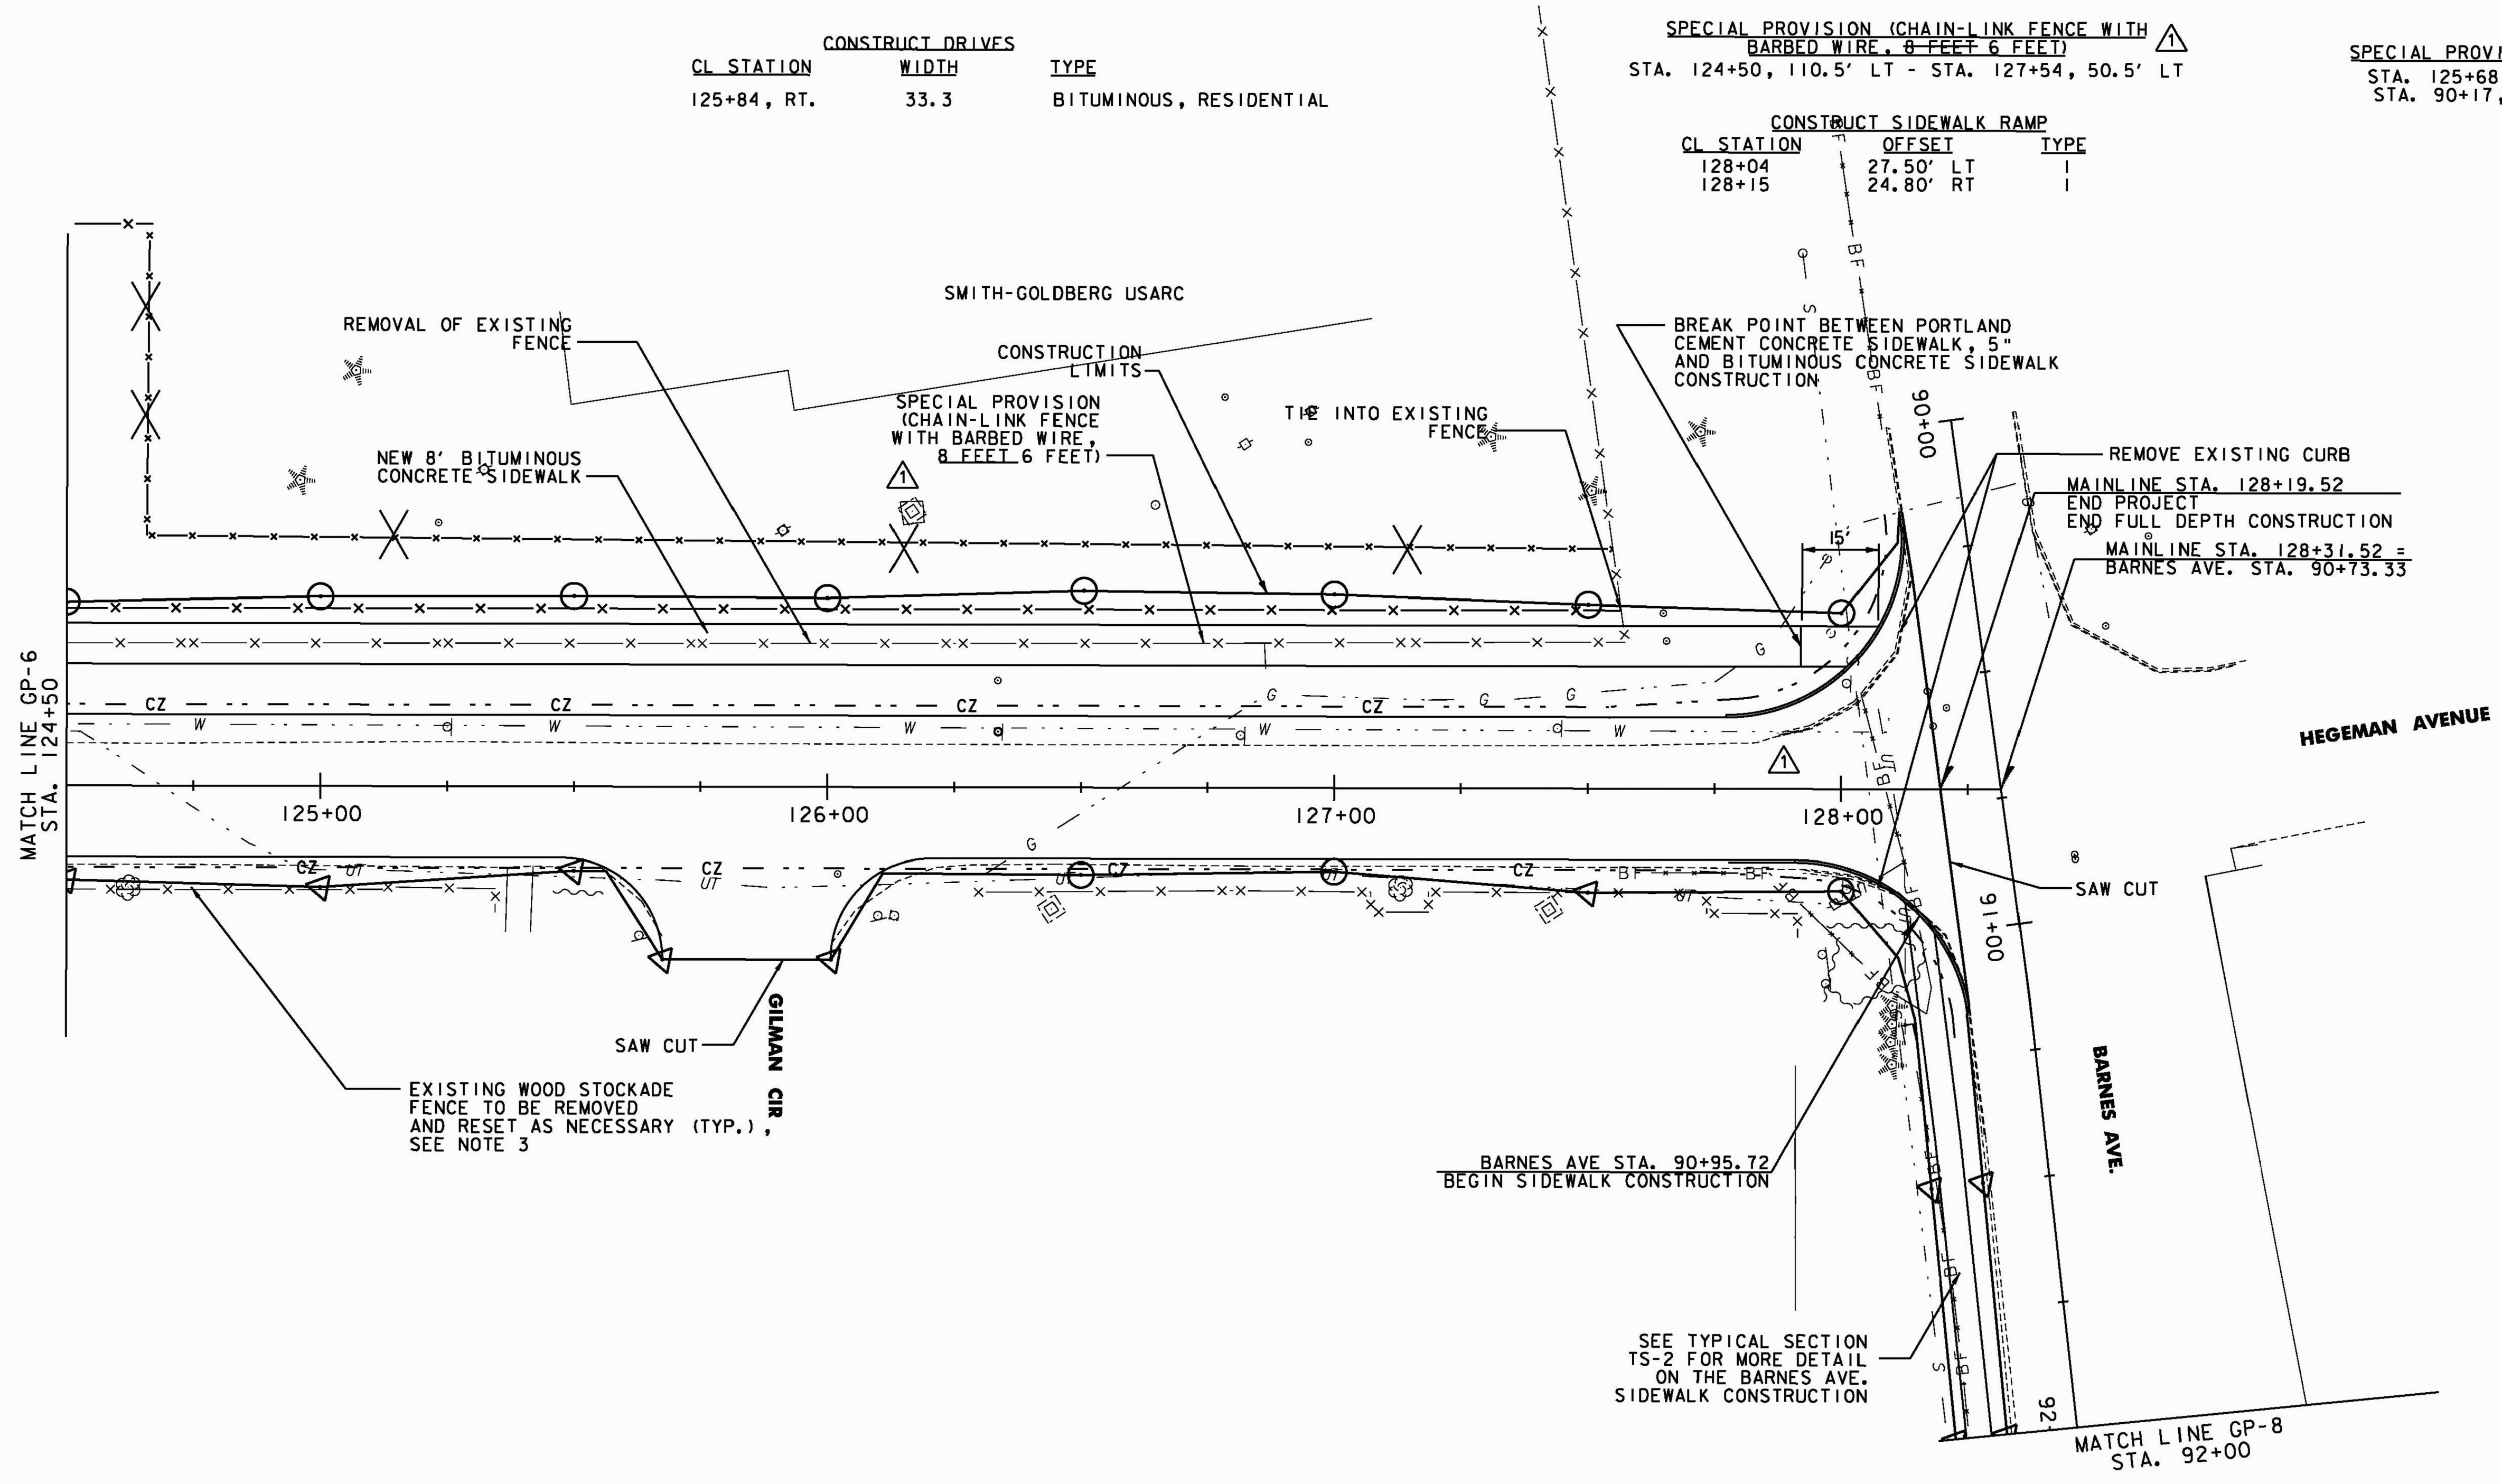


- NOTES:**
- SIDEWALK RAMPS SHALL BE CONSTRUCTED IN ACCORDANCE WITH VTRANS STANDARDS C-3A AND C-3B.
  - DETECTABLE WARNING SURFACES SHALL BE CONSTRUCTED AT SIDEWALK RAMPS IN ACCORDANCE WITH VTRANS STANDARDS C-3A AND C-3B. DETECTABLE WARNING SURFACES SHALL BE CAST IRON. SEE SIGNING/PVT MARKING PLANS FOR LOCATIONS.
  - EXISTING WOOD STOCKADE FENCE SHALL BE REMOVED AS NECESSARY TO AVOID DAMAGE DURING CONSTRUCTION. FENCE SHALL BE RESET BACK TO ORIGINAL LOCATION PRIOR TO COMPLETION OF CONSTRUCTION. CONTRACTOR SHALL OBTAIN APPROVAL FROM RESIDENT ENGINEER PRIOR TO REMOVING FENCE.

**RECORD DRAWING**  
**DATE: DECEMBER 21, 2012**

FIELD CHANGE #3 - SEPTEMBER 2, 2011  
 MOVED NATIONAL GUARD FENCE, REVISED  
 CUT/FILL LIMIT

REVISION	BY	DATE
ADDENDUM - 1	JBL	01/24/11

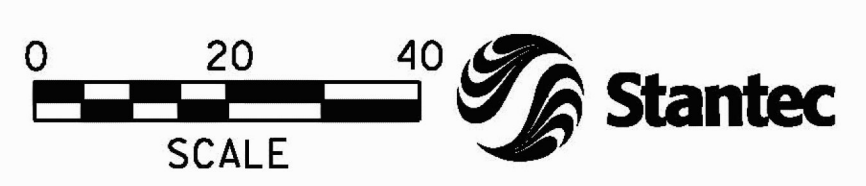

PROJECT NAME: COLCHESTER CAMPUS CONNECTOR	PLOT DATE: 9/7/2011
PROJECT NUMBER: TCSP TCSE (007)	DRAWN BY: PZA
FILE NAME: ...058-065.Gen.plt	CHECKED BY: GGG
DESIGNED BY: TFD	GENERAL PLAN GP-7
	SHEET 64 OF 155