


RECORD DRAWING
DATE: DECEMBER 21, 2012

DATUM	
VERTICAL	NAVD88
HORIZONTAL	NAD83 (96)
ADJUSTMENT	COMPASS

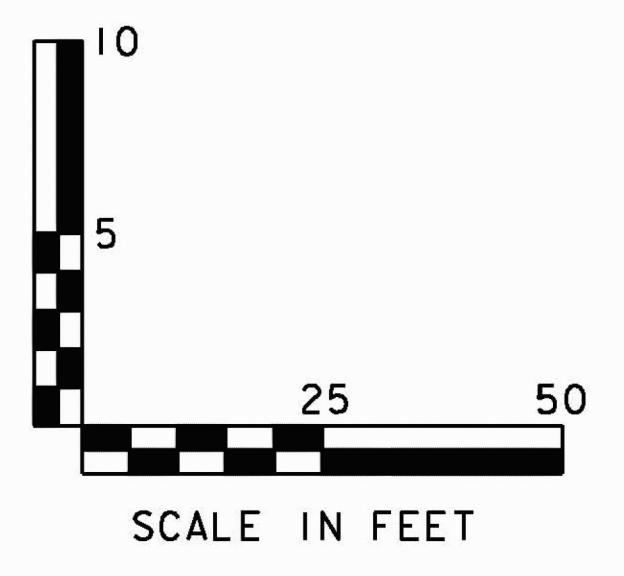

PROJECT NAME:	COLCHESTER CAMPUS CONNECTOR
PROJECT NUMBER:	TCSP TCSE (007)
FILE NAME: ... \Plot Files\067-074_Pro.prf	PLOT DATE: 12/2/2010
PROJECT LEADER: JBL	DRAWN BY: TFD
DESIGNED BY: TFD	CHECKED BY: GGG
PROFILE - MAINLINE PR-1	SHEET 67 OF 153