

NEW DRAINAGE PIPES			
PIPE #	LOCATION	INV. IN	INV. OUT
207	106+92 LT - 107+27 RT	312.91 313.19	312.75 312.99
207A	106+92 - 107+27 RT	312.93	312.92
208	107+58 LT - 107+27 RT	312.97 314.18	312.75 313.99
209	108+10 - 107+58 LT	313.11 313.30	312.97 313.12
210	108+05 RT - 108+10 LT	313.58 314.18	313.49 313.99
CV2	111+64 LT	315.38	315.30

EXISTING DRAINAGE PIPES		
PIPE #	LOCATION	COMMENTS
EX507	106+71 LT - 107+27 LT	REMOVE
EX508	107+77 LT - 107+27 RT	REMOVE
EX509	107+27 RT	RETAIN

NOTES:


208A 107+77 - 107+58 RT 313.98 313.76 8" X 21' SDR 35 PVC

- SEE STORMWATER MANAGEMENT SHEETS FOR GRADING AND DETAILS OF INFILTRATION AREA CONSTRUCTION.
- RETAIN EXISTING OUTLET PIPE. TIE EXISTING PIPE INTO NEW CB.
- INFORMATION ON PIPES CONNECTING JOHNSON AVE SYSTEM TO ROUTE 15 SYSTEM TAKEN FROM PLANS FOR SISTERS AND BROTHERS INVESTMENT GROUP PROJECT FOR 162+166 COLLEGE PARKWAY 11/03/2005.

EXISTING DRAINAGE STRUCTURES		
STRUCTURE #	LOCATION	COMMENTS
EXDS12	107+27 RT	REMOVE
EXDS13	107+77 RT	REMOVE
EXDW9	108+00 LT	EXISTING DRYWELL, CLEAN OUT ACCUMULATED SEDIMENT AND RETAIN

NEW DRAINAGE STRUCTURES		
STRUCTURE #	LOCATION	COMMENTS
CB207	106+94, 12.2' LT	CATCH BASIN, TYPE D HINGED GRATE, RIM EL. 316.33
CB207A	106+91.2, 13.5' RT	DROP INLET
CB208	107+26.6, 13.5' RT	CATCH BASIN, TYPE D HINGED GRATE, RIM EL. 316.41
CB209	107+58.3, 12.5' LT	CATCH BASIN, TYPE D HINGED GRATE, RIM EL. 316.82
CB210	108+00.0, 16.4' LT	DROP INLET
CB211	108+04.8, 13.4' RT	CATCH BASIN, TYPE D HINGED GRATE, RIM EL. 317.11
DW2	107+77.7, 23.0' LT	DROP INLET
		DRYWELL, TYPE D HINGED GRATE, RIM EL. 316.48

STONE FILL, TYPE I	
LOCATION	COMMENTS
33+21 RT, 111+54 LT	LEVEL SPREADER/ STILLING BASIN

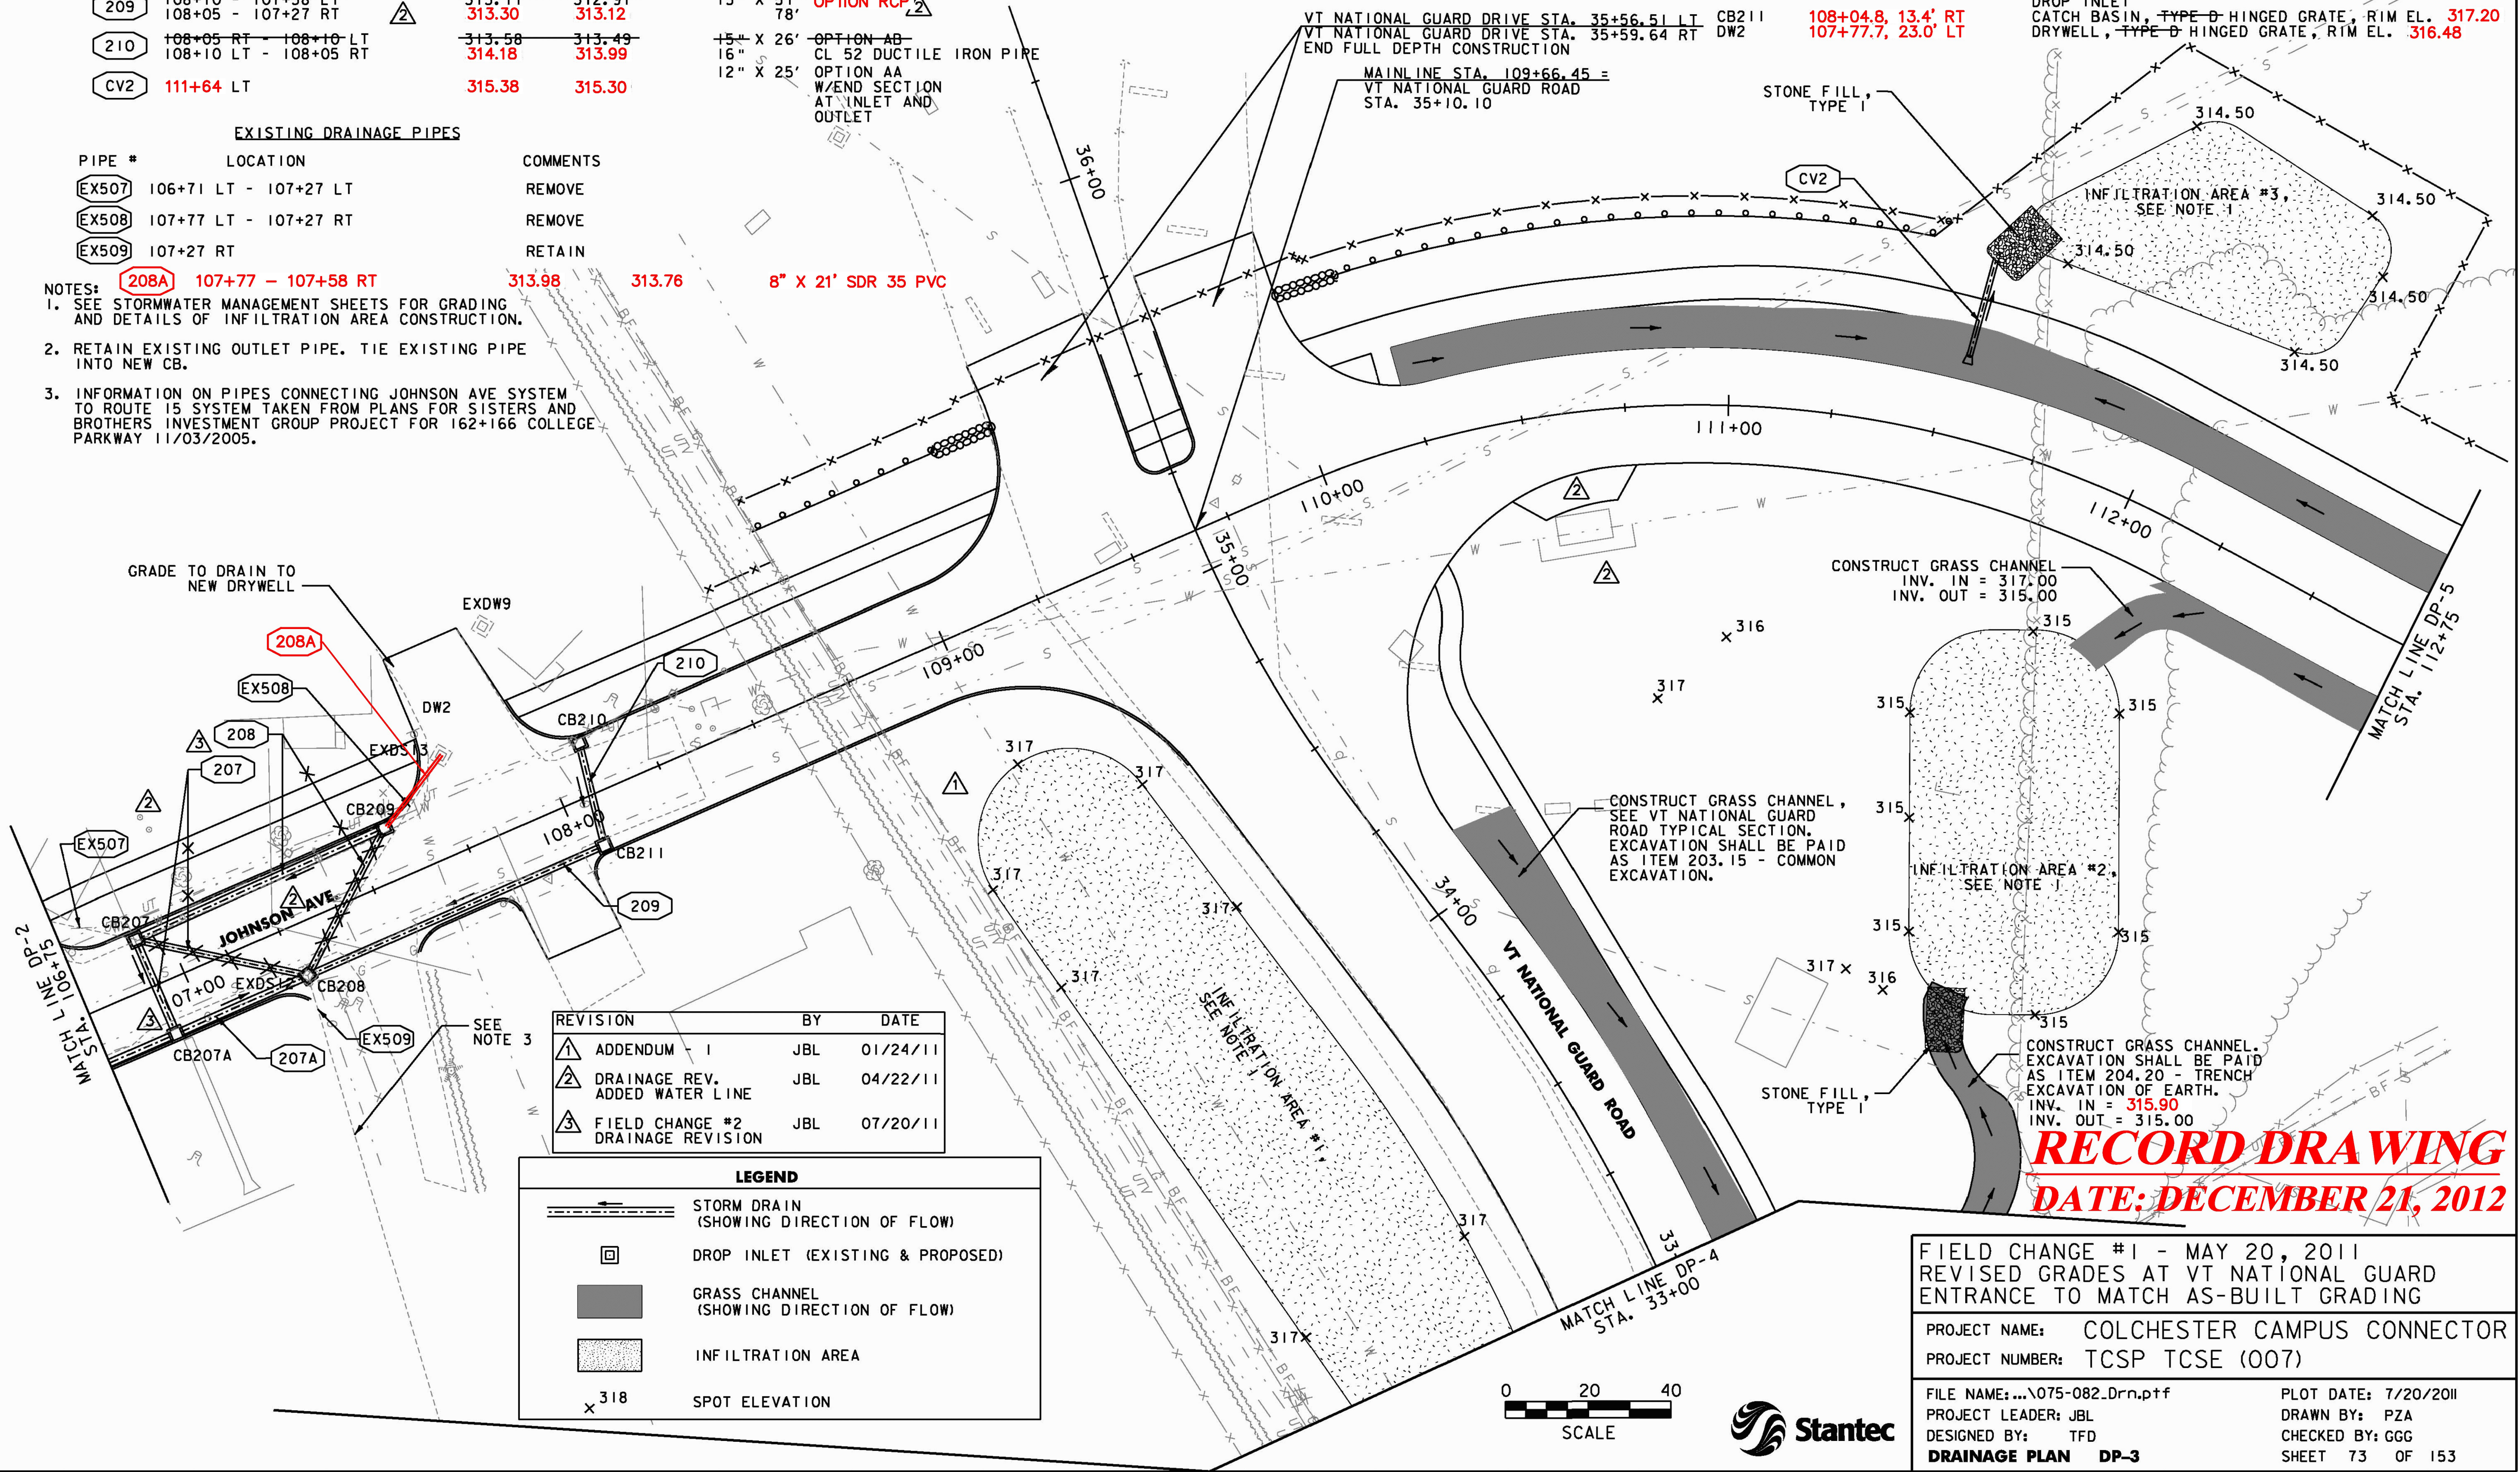

REVISION	BY	DATE
ADDENDUM - 1	JBL	01/24/11
DRAINAGE REV. ADDED WATER LINE	JBL	04/22/11
FIELD CHANGE #2 DRAINAGE REVISION	JBL	07/20/11

LEGEND	
	STORM DRAIN (SHOWING DIRECTION OF FLOW)
	DROP INLET (EXISTING & PROPOSED)
	GRASS CHANNEL (SHOWING DIRECTION OF FLOW)
	INFILTRATION AREA
	SPOT ELEVATION

RECORD DRAWING
DATE: DECEMBER 21, 2012

FIELD CHANGE #1 - MAY 20, 2011 REVISED GRADES AT VT NATIONAL GUARD ENTRANCE TO MATCH AS-BUILT GRADING	
PROJECT NAME:	COLCHESTER CAMPUS CONNECTOR
PROJECT NUMBER:	TCSP TCSE (007)
FILE NAME: ...075-082.Drn.ptf	PLOT DATE: 7/20/2011
PROJECT LEADER: JBL	DRAWN BY: PZA
DESIGNED BY: TFD	CHECKED BY: GGG
DRAINAGE PLAN DP-3	SHEET 73 OF 153

