


NEW DRAINAGE PIPES			
PIPE #	LOCATION	INV. IN	INV. OUT
CV4	122+90 LT	316.96 317.23	315.64
STONE FILL, TYPE I			
LOCATION	COMMENTS		
123+14 LT	LEVEL SPREADER/ STILLING BASIN		

NOTES:
1. SEE STORMWATER MANAGEMENT SHEETS FOR DETAILS OF INFILTRATION AREA CONSTRUCTION.


EXISTING DRAINAGE STRUCTURES		
STRUCTURE #	LOCATION	COMMENTS
EXDW17	119+68 RT	EXISTING DRYWELL, CLEAN OUT ACCUMULATED SEDIMENT AND RETAIN
EXDW18	120+59 RT	EXISTING DRYWELL, CLEAN OUT ACCUMULATED SEDIMENT AND RETAIN
EXDW19	121+40 RT	EXISTING DRYWELL, CLEAN OUT ACCUMULATED SEDIMENT AND RETAIN
EXDW20	121+98 RT	EXISTING DRYWELL, CLEAN OUT ACCUMULATED SEDIMENT AND RETAIN
EXDW21	122+86 RT	EXISTING DRYWELL, CLEAN OUT ACCUMULATED SEDIMENT AND RETAIN
EXDW22	123+62 RT	EXISTING DRYWELL, CLEAN OUT ACCUMULATED SEDIMENT AND RETAIN

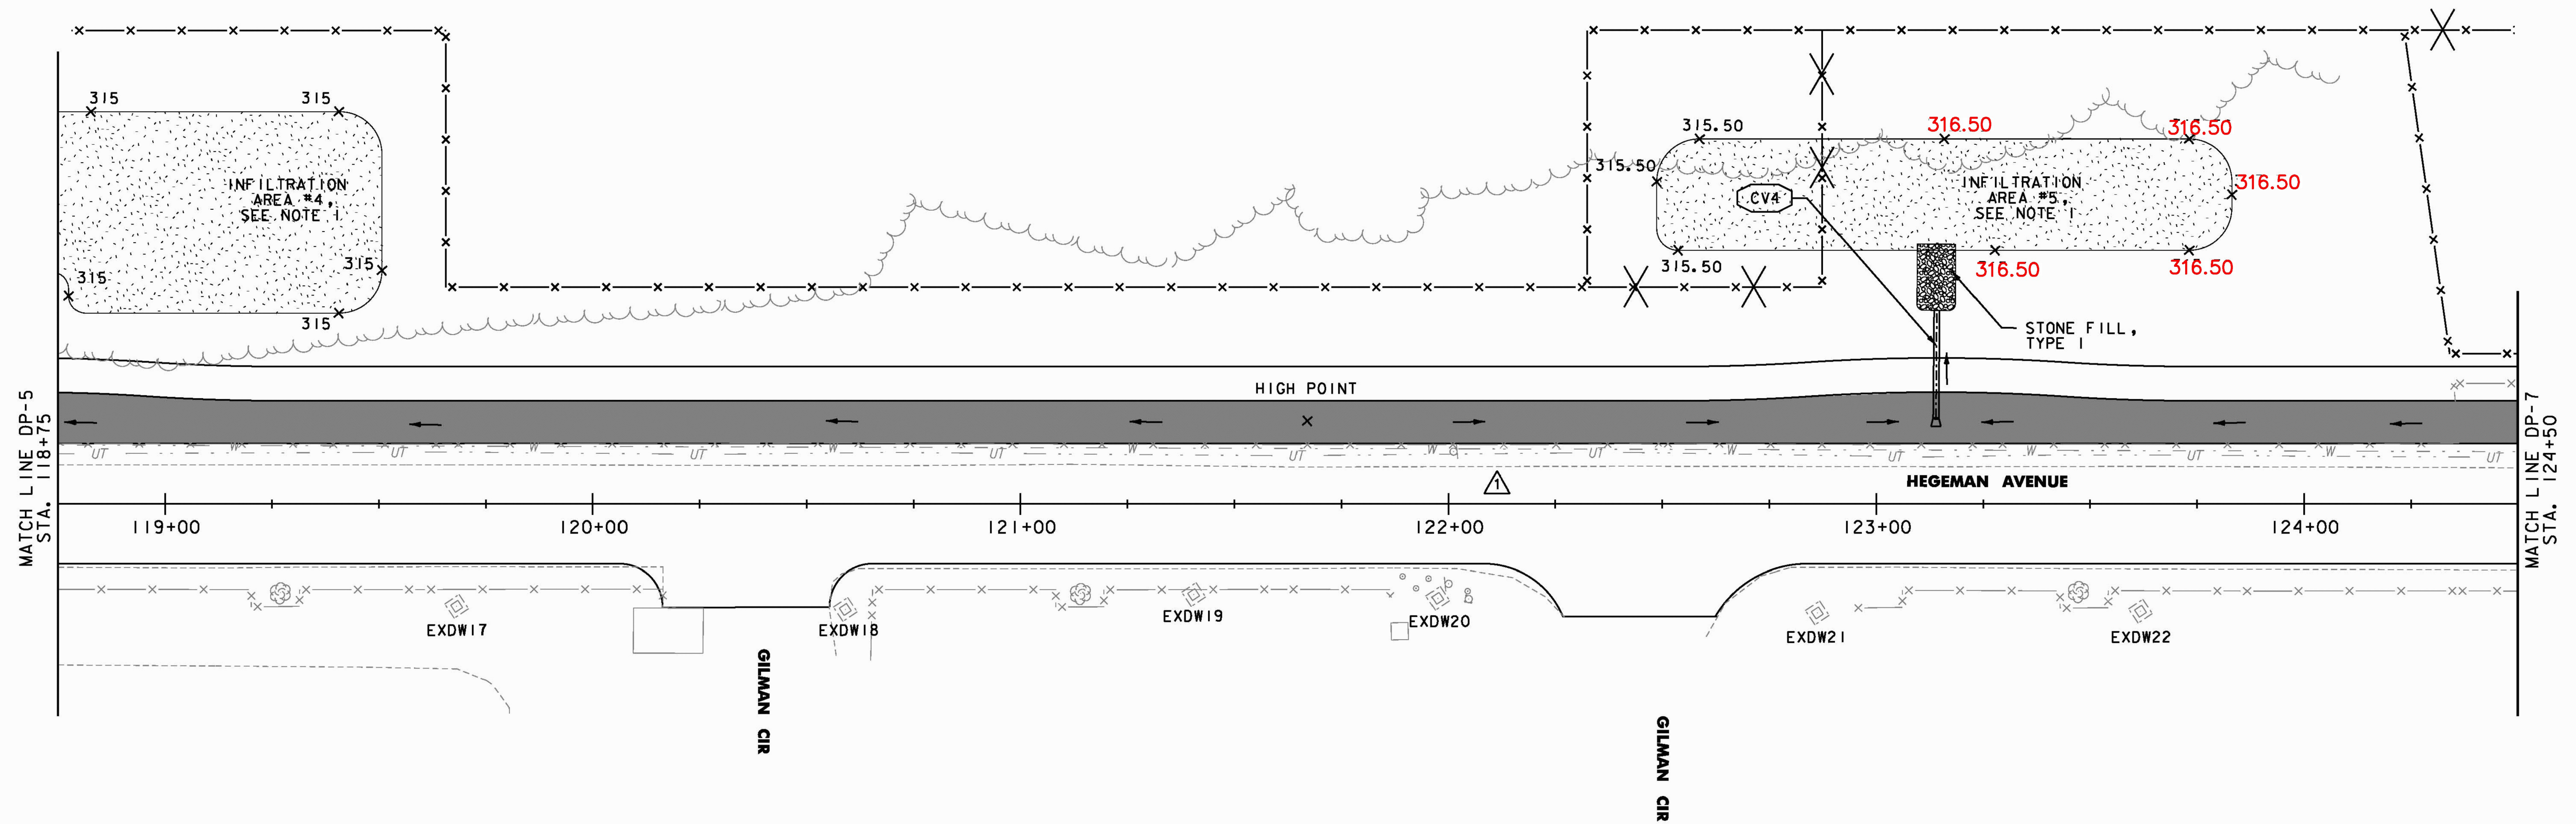

LEGEND	
	STORM DRAIN (SHOWING DIRECTION OF FLOW)
	DROP INLET (EXISTING & PROPOSED)
	GRASS CHANNEL (SHOWING DIRECTION OF FLOW)
	INFILTRATION AREA

REVISION	BY	DATE
ADDENDUM - 1	JBL	01/24/11

RECORD DRAWING
DATE: DECEMBER 21, 2012

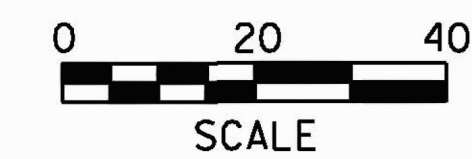

FIELD CHANGE #3 - SEPTEMBER 2, 2011
MOVED NATIONAL GUARD FENCE, INFILTRATION BASIN AND REVISED CULVERT INVERT

PROJECT NAME: COLCHESTER CAMPUS CONNECTOR
PROJECT NUMBER: TCSP TCSE (007)

FILE NAME: ...075-082_Drn.pff
PROJECT LEADER: JBL
DESIGNED BY: TFD
DRAWN BY: PZA
CHECKED BY: GGG
PLOT DATE: 9/7/2011
SHEET 76 OF 155

DRAINAGE PLAN DP-6