


NO DRAINAGE CONSTRUCTION ON THIS SHEET

RECORD DRAWING
DATE: DECEMBER 21, 2012

LEGEND	
	STORM DRAIN (SHOWING DIRECTION OF FLOW)
	DROP INLET (EXISTING & PROPOSED)
	GRASS CHANNEL (SHOWING DIRECTION OF FLOW)
	INFILTRATION AREA

REVISION	BY	DATE
ADDENDUM - I	JBL	01/24/11

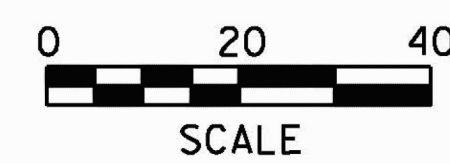

PROJECT NAME:	COLCHESTER CAMPUS CONNECTOR
PROJECT NUMBER:	TCSP TCSE (007)
FILE NAME: ... \plotfiles\075-082_Drn.ptf	PLOT DATE: 4/22/2011
PROJECT LEADER: JBL	DRAWN BY: PZA
DESIGNED BY: TFD	CHECKED BY: GGG
DRAINAGE PLAN DP-8	SHEET 78 OF 153