



INFILTRATION AREA #4		
LAYOUT POINT	STATION	OFFSET
IAP31	118+15	54 LT
IAP32	118+15	82 LT
IAP33	118+25	44 LT
IAP34	118+25	92 LT
IAP35	118+52	44 LT
IAP36	118+81	44 LT
IAP37	119+41	44 LT
IAP38	119+41	92 LT
IAP39	119+51	54 LT
IAP40	119+51	82 LT

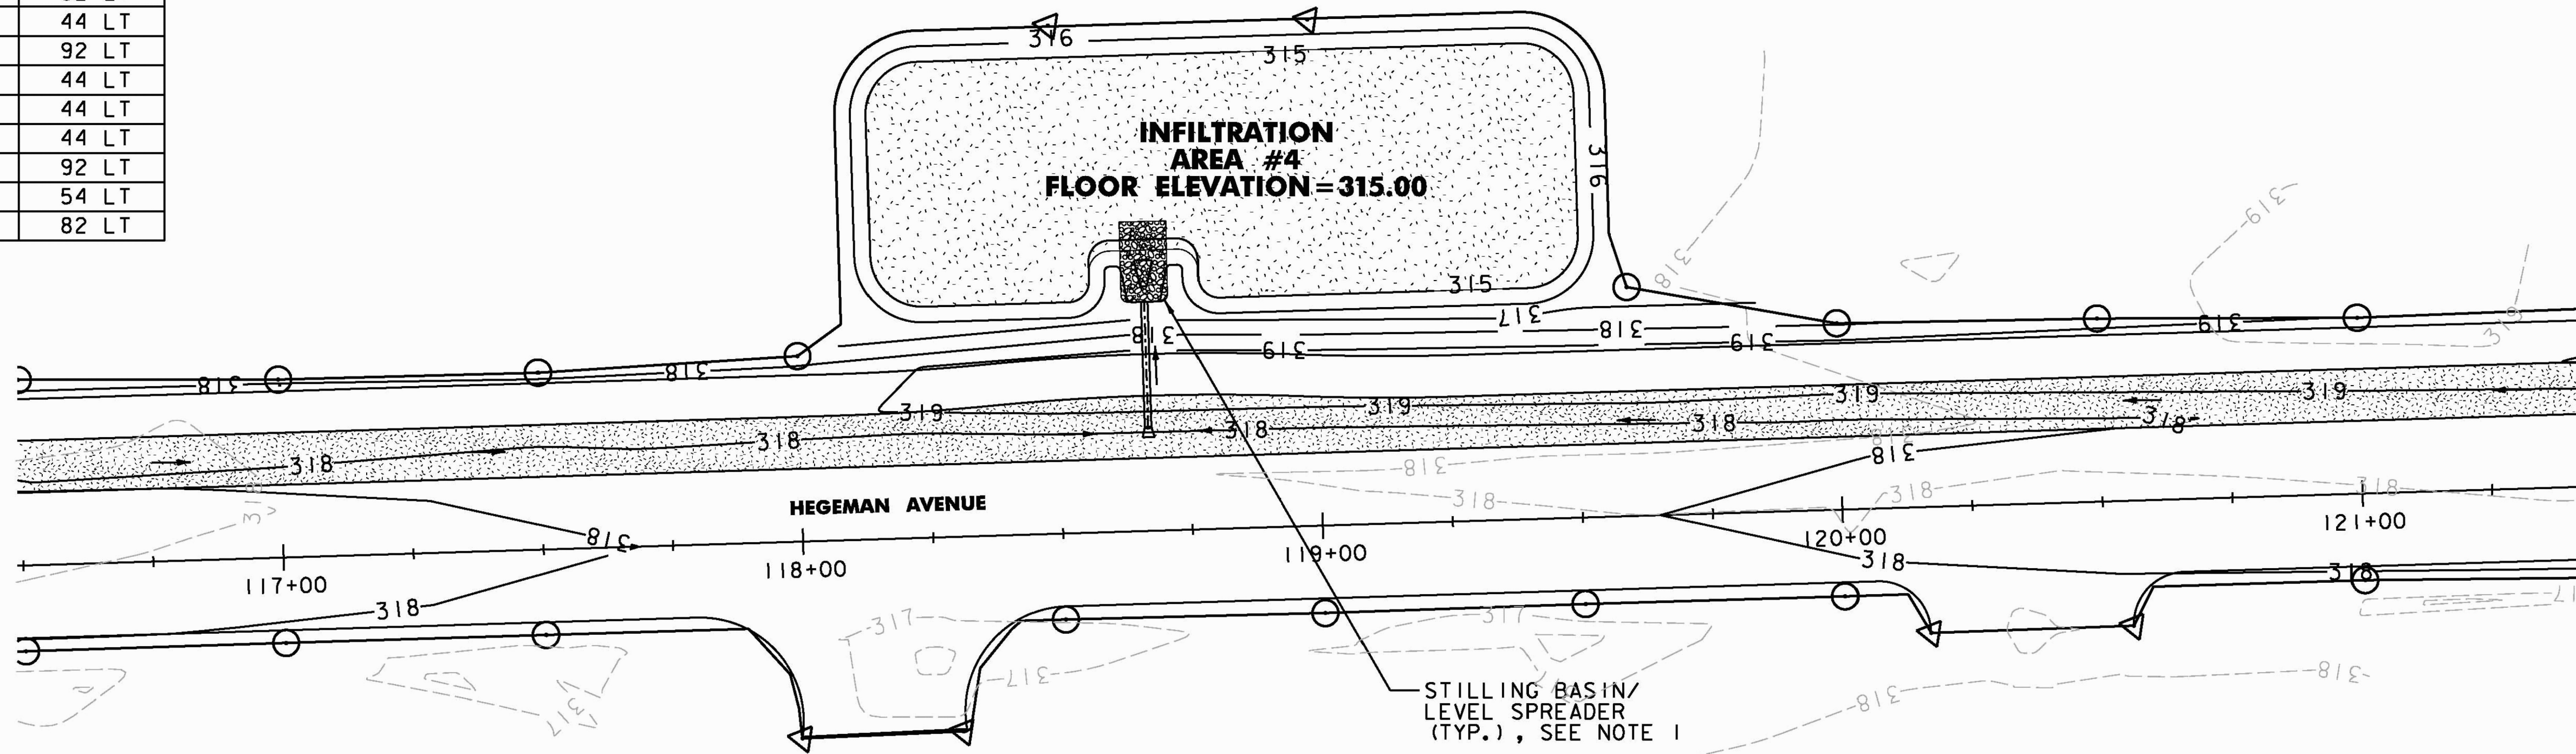

INFILTRATION AREA #5		
LAYOUT POINT	STATION	OFFSET
IAP41	122+49	64 LT
IAP42	122+49	75 LT
IAP43	122+54	85 LT
IAP44	122+60	59 LT
IAP45	123+23	59 LT
IAP46	123+23	85 LT
IAP47	123+29	69 LT
IAP48	123+29	75 LT

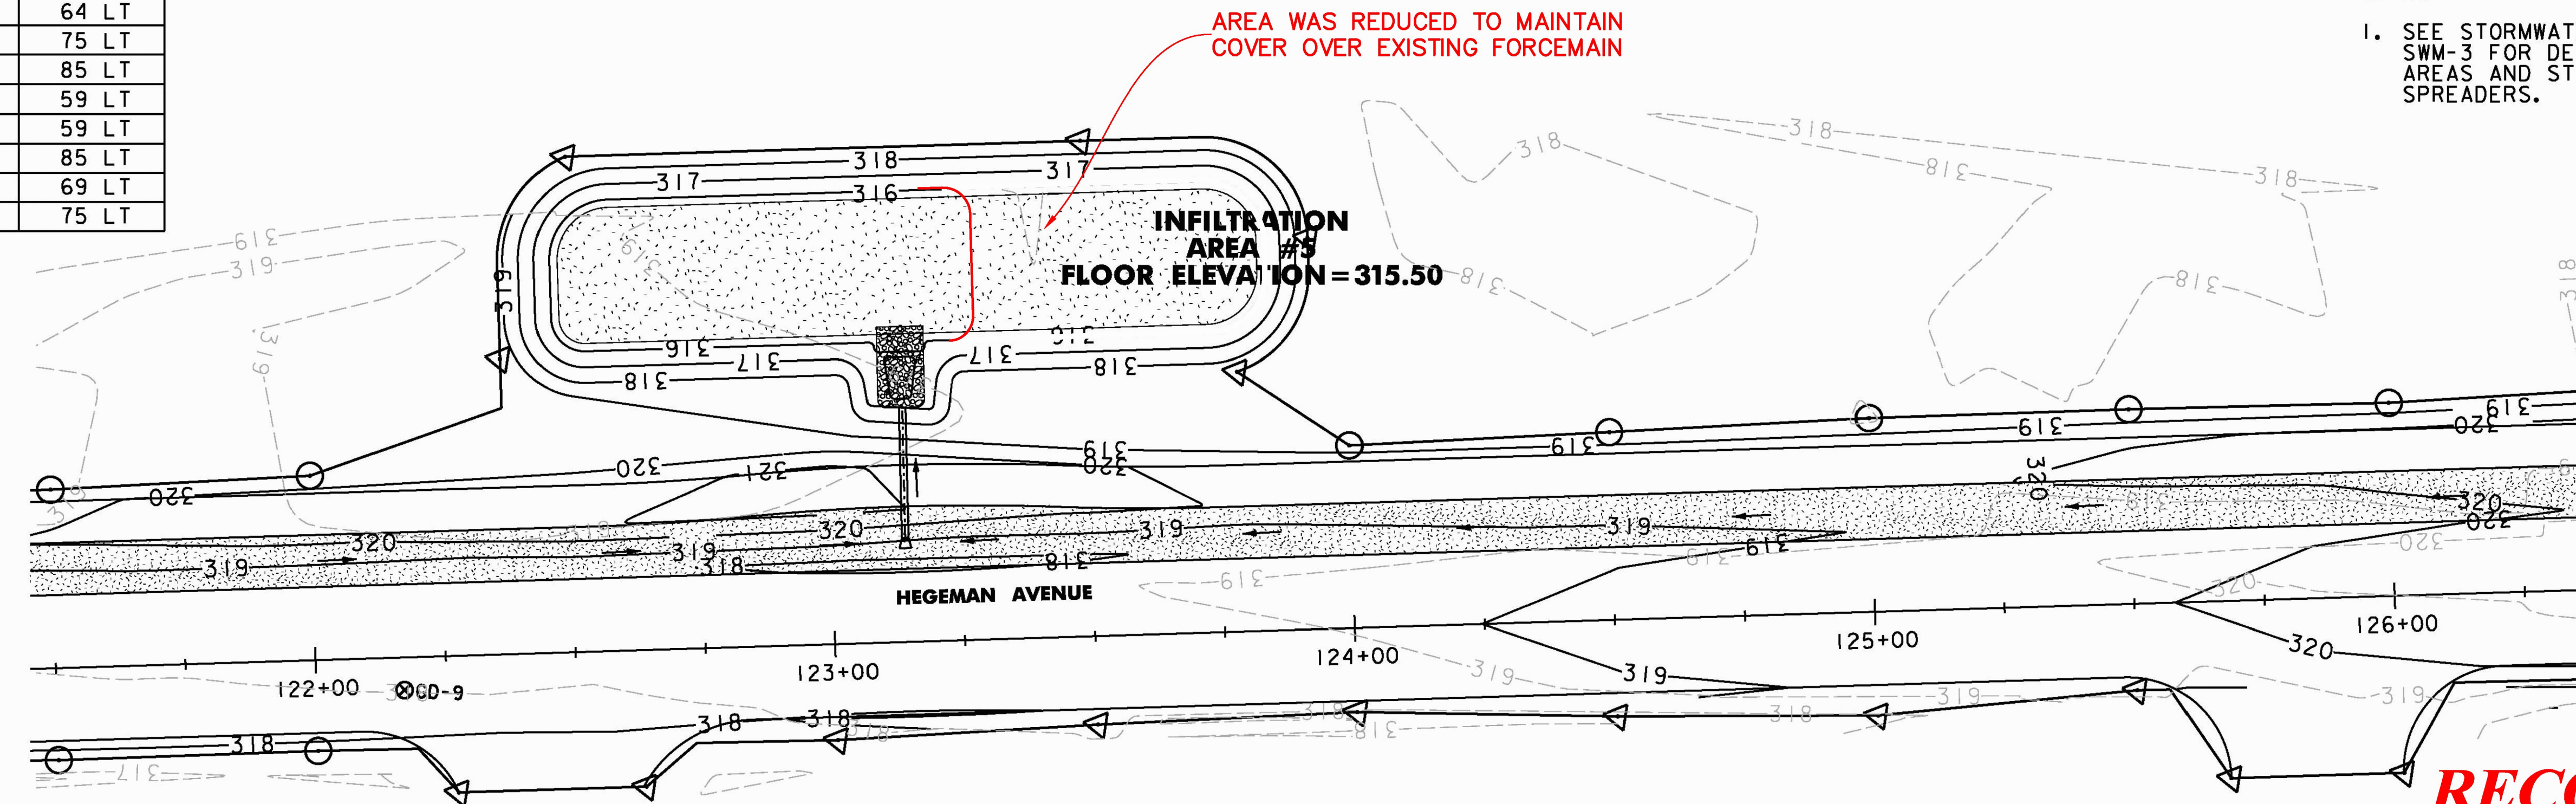

- NOTES:
- SEE STORMWATER MANAGEMENT DETAIL SWM-3 FOR DETAILS OF INFILTRATION AREAS AND STILLING BASINS/ LEVEL SPREADERS.

RECORD DRAWING
DATE: DECEMBER 21, 2012

PROJECT NAME:	COLCHESTER CAMPUS CONNECTOR
PROJECT NUMBER:	TCSP TCSE (007)
FILE NAME:	... \083-086_Swmdet.pxf
DESIGNED BY:	TFD
STORMWATER MGT. DET. SWM-2	
PLOT DATE:	9/7/2011
DRAWN BY:	AHC
CHECKED BY:	GGG
SHEET	80 OF 155

