

**DURABLE 4" WHITE LINE (SEE NOTE 3)**  
 STA. 1+00, RT. - STA. 7+00, RT. (RT EDGE)  
 STA. 1+00, RT. - STA. 7+00, RT. (CENTER DASH 10'-30')  
 STA. 1+04, LT. - STA. 5+57, LT. (RT EDGE)  
 STA. 1+04, LT. - STA. 7+00, LT. (CENTER DASH 10'-30')  
 STA. 4+04, CL. - STA. 5+04, CL. (TURN LANE DOTTED 2'-4')  
 STA. 5+04, CL. - STA. 6+28, LT. (TURN LANE)  
 STA. 6+50, RT. - STA. 7+00, RT. (TURN LANE DOTTED 2'-4')  
 STA. 6+71, LT. - STA. 7+00, LT. (RT EDGE)  
 STA. 100+56, LT. - STA. 101+23, LT. (STRAIGHT TURN LANE)  
 STA. 100+56, LT. - STA. 101+23, LT. (CURVED TURN LANE)  
 STA. 100+56, LT. - STA. 101+05, LT. (DIAGONAL HATCHING)

**DURABLE 24" STOP BAR**  
 STA. 100+55 - STA. 100+59, LT.  
 STA. 101+61 - STA. 101+68, LT.  
 STA. 101+90 - STA. 101+93, LT.

**PAINTED CURB**  
 STA. 3+97, CL. - STA. 4+34, LT.  
 STA. 4+74, LT. - STA. 5+34, LT.  
 STA. 5+75, LT. - STA. 5+75, LT. (NOSE)

**DURABLE 6" WHITE LINE**  
 STA. 100+49, RT. - STA. 102+25, RT. (BIKE LANE)  
 STA. 101+59, LT. - STA. 101+58, LT. (BIKE LANE)  
 STA. 101+63, LT. - STA. 101+70, LT. (BIKE LANE)  
 STA. 101+93, LT. - STA. 102+25, LT. (BIKE LANE)


**DURABLE 4" YELLOW LINE (SEE NOTE 3)**  
 STA. 1+00, LT. - STA. 6+04, LT. (LEFT EDGE)  
 STA. 1+04, LT. - STA. 6+04, LT. (LEFT EDGE)  
 STA. 6+04, LT. (RADIUS)  
 STA. 6+70, LT. - STA. 7+00, LT. (LEFT EDGE)  
 STA. 6+70, LT. - STA. 7+00, RT. (LEFT EDGE)  
 STA. 100+55, LT. - STA. 101+24, LT. (DOUBLE SOL ID)  
 STA. 101+68, LT. - STA. 101+74, LT. (DOUBLE SOL ID)  
 STA. 101+90, CL. - STA. 101+25, CL. (DOUBLE SOL ID)

**DURABLE CROSSWALK MARKING**  
 STA. 100+47, LT. - STA. 100+47, RT.  
 STA. 101+56, LT. - STA. 101+91, LT.

**DETECTABLE WARNING SURFACES**  
 STA. 5+57, 44.1' LT  
 STA. 6+68, 45.2' LT  
 STA. 101+57, 46.0' LT  
 STA. 101+91, 16.8' LT

**DURABLE LETTER OR SYMBOL (SEE NOTE 3)**  
 STA. 101+25, LT. -   
 STA. 101+25, LT. -   
 STA. 100+65, LT. -   
 STA. 100+67, LT. -   
 STA. 100+94, RT. -

**DURABLE LETTER OR SYMBOL (SEE NOTE 3)**  
 STA. 101+06, RT. -   
 STA. 5+08, LT. -   
 STA. 5+48, LT. - ONLY  
 STA. 5+88, LT. -

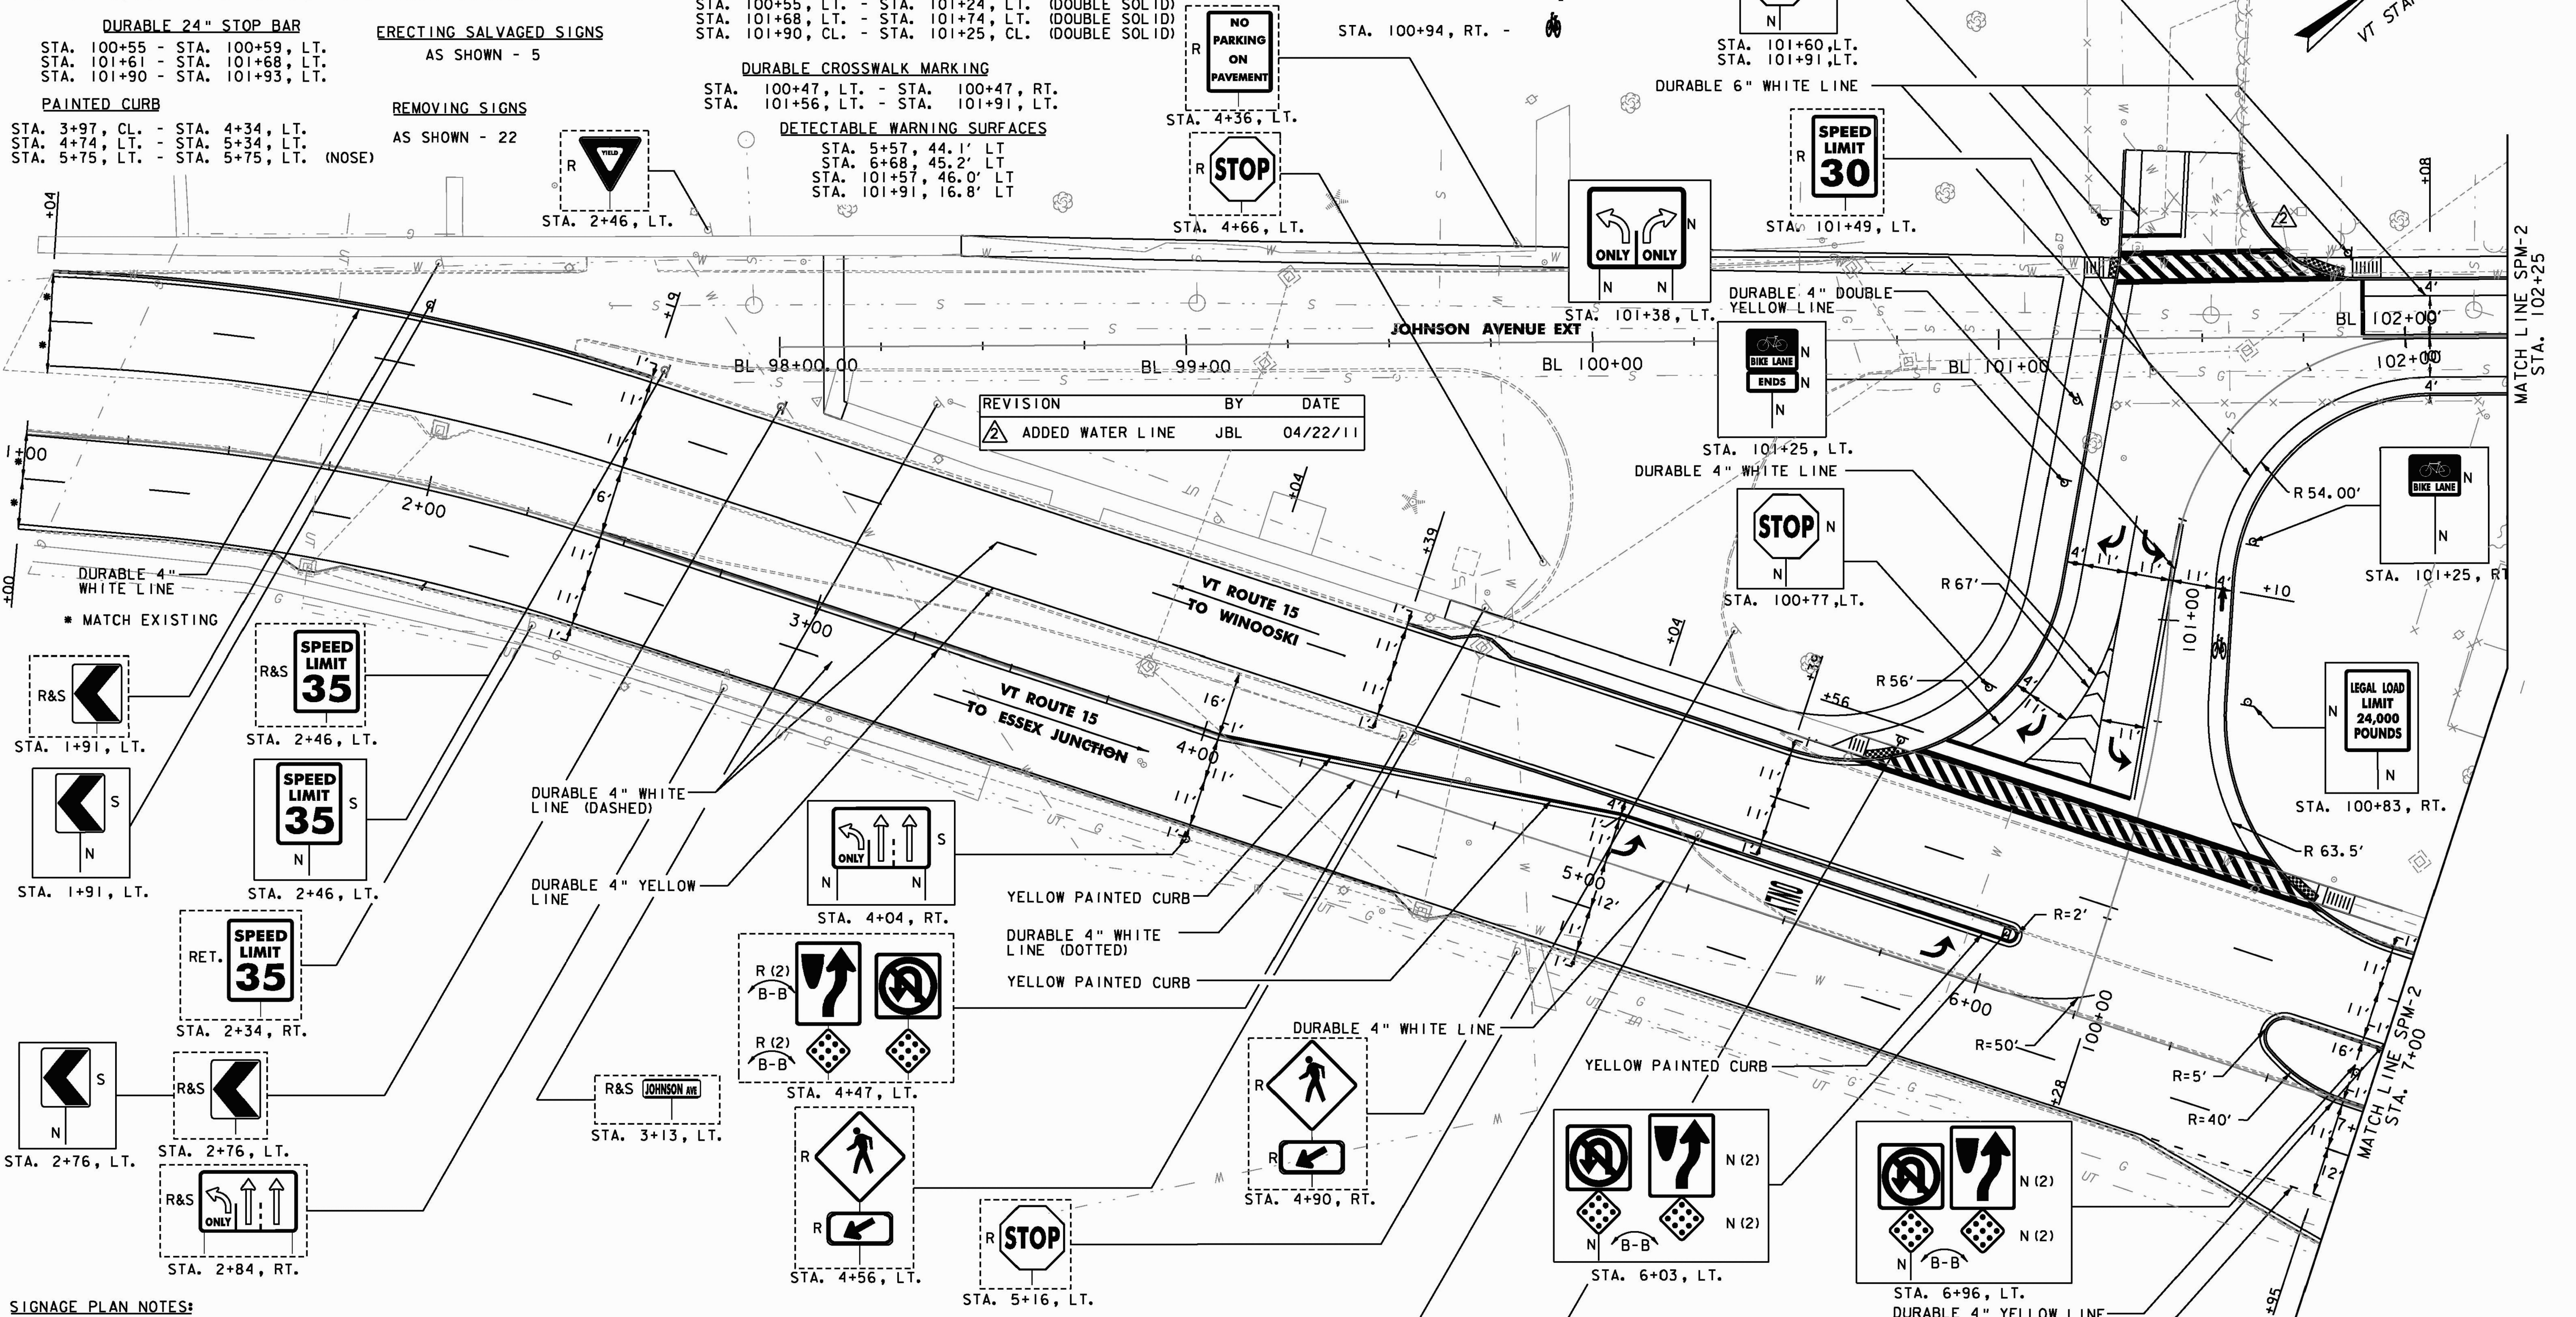


REVISION	BY	DATE
2	JBL	04/22/11

- SIGNAGE PLAN NOTES:**
- ALL EXISTING SIGNS NOT SHOWN SHALL BE RETAINED UNLESS DIRECTED OTHERWISE BY THE RESIDENT ENGINEER.
  - SEE VTrans STANDARD E-121 FOR STANDARD SIGN PLACEMENT.
  - ALL DURABLE PAVEMENT MARKINGS BEING PLACED ON VT ROUTE 15 SHALL BE THERMOPLASTIC.
  - ALL TEMPORARY PAVEMENT MARKINGS SHALL BE TEMPORARY 4" LINE. TEMPORARY LETTER OR SYMBOL REQUIRED FOR TURN ARROWS ONLY.

**SIGN & DELINEATOR LEGEND**

N	= NEW	R (2)		
R	= REMOVE	R (2)		
R&S	= REMOVE & SALVAGE	R (2)		
S	= SALVAGE SIGN	R (2)		
RET	= RETAIN	R (2)		
B-B	= BACK TO BACK	R (2)		
-	= EXISTING	R (2)		
-	= PROPOSED	R (2)		

**RECORD DRAWING**  
**DATE: DECEMBER 21, 2012**

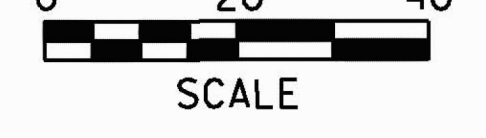

PROJECT NAME: COLCHESTER CAMPUS CONNECTOR  
 PROJECT NUMBER: TCSP TCSE (007)  
 FILE NAME: ...\\plotfiles\087-094\_sign.pxf PLOT DATE: 4/22/2011  
 PROJECT LEADER: JBL DRAWN BY: PZA  
 DESIGNED BY: TFD CHECKED BY: GGG  
**SIGNING/PVT MARKING PLAN SPM-1 SHEET 83 OF 153**