

REMOVING SIGNS
AS SHOWN - 3

DURABLE LETTER OR SYMBOL (SEE NOTE 3)


DURABLE 4" WHITE LINE (SEE NOTE 3)

DURABLE 4" YELLOW LINE (SEE NOTE 3)

DURABLE CROSSWALK MARKING

DURABLE 6" WHITE LINE

DURABLE 24" STOP BAR

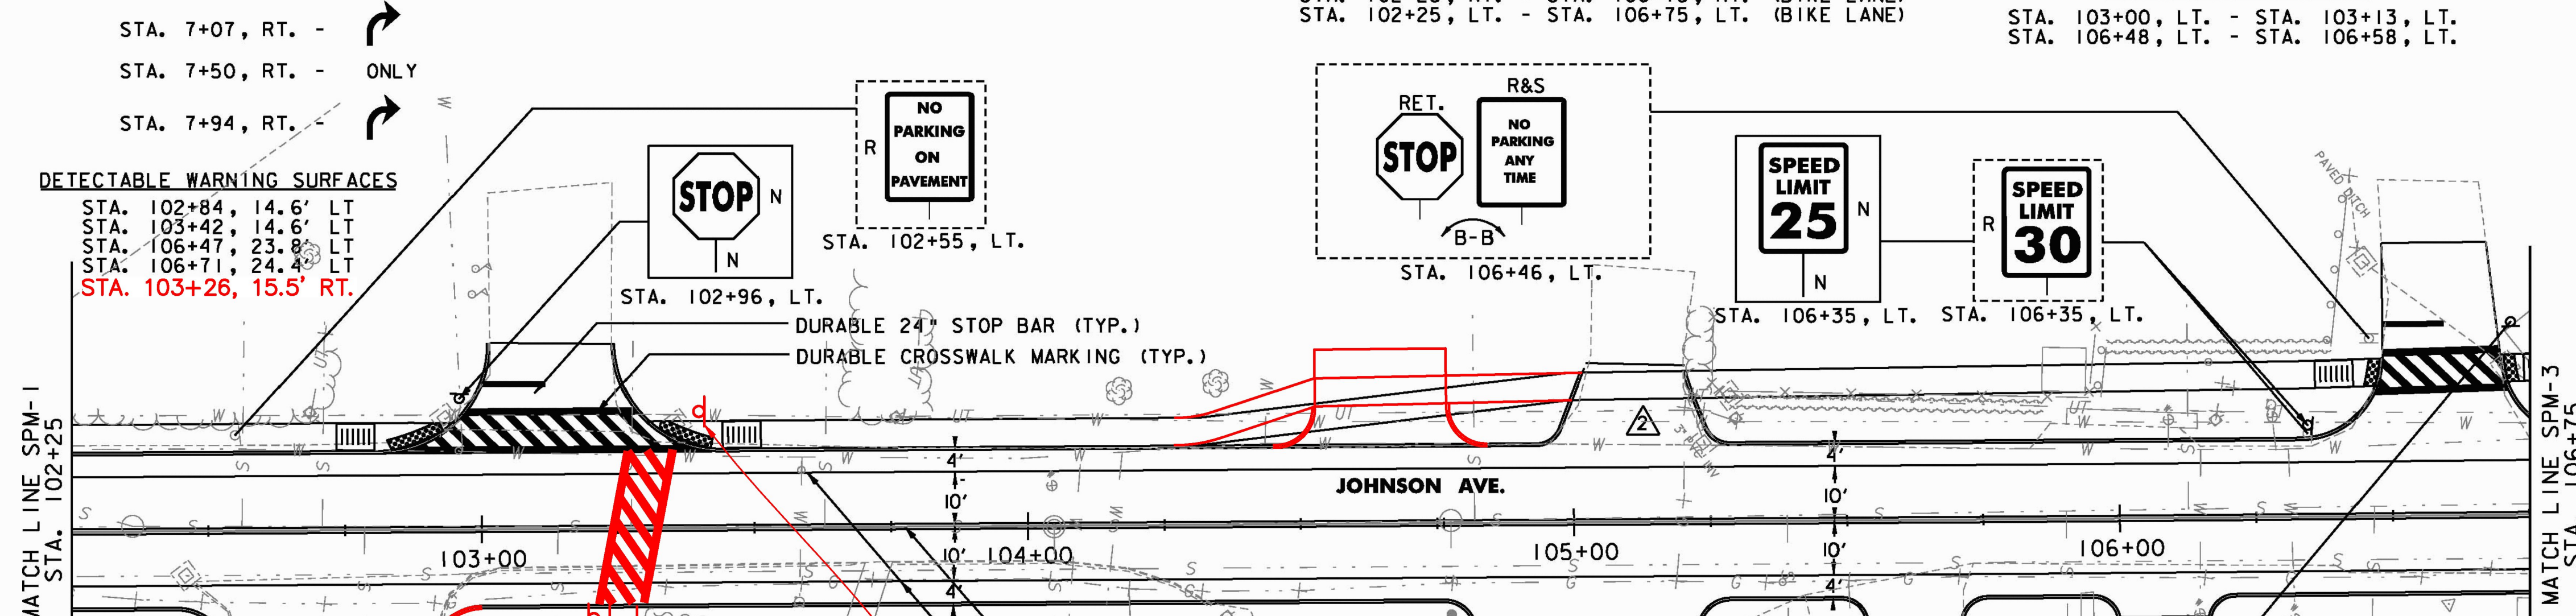

DETECTABLE WARNING SURFACES

STA. 102+84, 14.6' LT
 STA. 103+42, 14.6' LT
 STA. 106+47, 23.8' LT
 STA. 106+71, 24.8' LT
 STA. 103+26, 15.5' RT.

MATCH LINE SPM-1
STA. 102+25

MATCH LINE SPM-3
STA. 106+75

SPEED LIMIT 25 N
STA. 102+40, RT.

NO PARKING ANY TIME N
STA. 106+72, LT.

NO PARKING ANY TIME S
STA. 106+72, LT.

DURABLE 4" WHITE LINE (EDGE)
 DURABLE 4" YELLOW LINE
 DURABLE 4" WHITE LINE (DASHED)

REVISION	BY	DATE
ADDED WATER LINE	JBL	04/22/11


SIGN & DELINEATOR LEGEND

N = NEW
 R = REMOVE
 R&S = REMOVE & SALVAGE
 S = SALVAGE SIGN
 RET = RETAIN
 B-B = BACK TO BACK

* = MATCH EXISTING CONDITIONS
 --- = EXISTING
 - - - = PROPOSED

- SIGNAGE PLAN NOTES:**
- ALL EXISTING SIGNS NOT SHOWN SHALL BE RETAINED UNLESS DIRECTED OTHERWISE BY THE RESIDENT ENGINEER.
 - SEE VTrans STANDARD E-121 FOR STANDARD SIGN PLACEMENT.
 - ALL DURABLE PAVEMENT MARKINGS BEING PLACED ON VT ROUTE 15 SHALL BE THERMOPLASTIC.
 - ALL TEMPORARY PAVEMENT MARKINGS SHALL BE TEMPORARY 4" LINE. TEMPORARY LETTER OR SYMBOL REQUIRED FOR TURN ARROWS ONLY.

RECORD DRAWING
DATE: DECEMBER 21, 2012

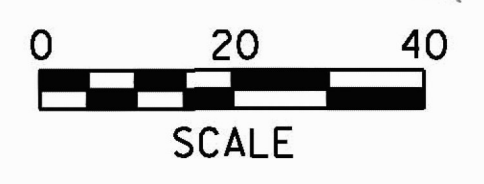

PROJECT NAME: COLCHESTER CAMPUS CONNECTOR
 PROJECT NUMBER: TCSP TCSE (007)

FILE NAME: ... \plotfiles\087-094.sign.ptf PLOT DATE: 4/22/2011
 PROJECT LEADER: JBL DRAWN BY: PZA
 DESIGNED BY: TFD CHECKED BY: GGG
SIGNING/PVT MARKING PLAN SPM-2 SHEET 84 OF 153