

DURABLE LETTER OR SYMBOL

STA. 31+17, LT.	-	↖	AND	↗
STA. 31+68, LT.	-	↖	ONLY	↗
STA. 32+18, LT.	-	↖	AND	↗
STA. 32+67, LT.	-	↖	ONLY	↗
STA. 31+66, RT.	-	↖	AND	↗
STA. 31+78, RT.	-	↖	ONLY	↗
STA. 30+14, LT.	-	↖	AND	↗
STA. 30+13, RT.	-	↖	ONLY	↗
STA. 29+74, LT.	-	↖	AND	↗

DURABLE 4" YELLOW LINE
 STA. 31+11, CL. - STA. 33+00, CL. (DOUBLE SOLID)

DURABLE CROSSWALK MARKING
 STA. 30+91, LT. - STA. 31+08, RT.

DURABLE 4" WHITE LINE
 STA. 29+74, LT. - STA. 30+25, RT. (TURN LANE)
 STA. 31+11, LT. - STA. 33+00, LT. (TURN LANE)

DURABLE 6" WHITE LINE
 STA. 31+06, LT. - STA. 33+00, LT. (BIKE LANE)
 STA. 31+15, RT. - STA. 33+00, RT. (BIKE LANE)

DURABLE 24" STOP BAR
 STA. 30+25, RT. & LT.
 STA. 31+11, LT.

REMOVING SIGNS
 AS SHOWN - 4

ERECTING SALVAGED SIGN
 AS SHOWN - 3

DETECTABLE WARNING SURFACES
 STA. 14+46, 46.4' LT
 STA. 15+58, 46.7' LT

SIGN & DELINEATOR LEGEND


N	=	NEW
R	=	REMOVE
R&S	=	REMOVE & SALVAGE
S	=	SALVAGE SIGN
RET	=	RETAIN
B-B	=	BACK TO BACK
*	=	MATCH EXISTING CONDITIONS
---	=	EXISTING
- - - -	=	PROPOSED

SIGNAGE PLAN NOTES:

1. ALL EXISTING SIGNS NOT SHOWN SHALL BE RETAINED UNLESS DIRECTED OTHERWISE BY THE RESIDENT ENGINEER.
2. SEE VTRANS STANDARD E-121 FOR STANDARD SIGN PLACEMENT.
3. ALL TEMPORARY PAVEMENT MARKINGS SHALL BE TEMPORARY 4" LINE. TEMPORARY LETTER OR SYMBOL REQUIRED FOR TURN ARROWS ONLY.

REVISION	BY	DATE
ADDENDUM - I	JBL	01/24/11

RECORD DRAWING
DATE: DECEMBER 21, 2012

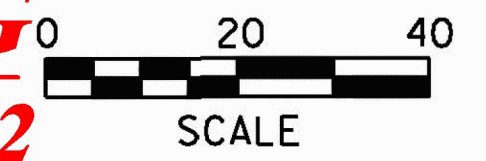

PROJECT NAME:	COLCHESTER CAMPUS CONNECTOR
PROJECT NUMBER:	TCSP TCSE (007)
FILE NAME:	...plotfiles\087-094_sign.pxf
PLOT DATE:	4/22/2011
PROJECT LEADER:	JBL
DRAWN BY:	PZA
DESIGNED BY:	TFD
CHECKED BY:	GGG
SIGNING/PVT MARKING PLAN	SPM-4 SHEET 86 OF 153