


DURABLE 6" WHITE LINE
 STA. 118+75, LT. - STA. 124+50, LT. (BIKE LANE)
 STA. 118+75, RT. - STA. 124+50, RT. (BIKE LANE)

DURABLE 4" YELLOW LINE
 STA. 118+75, CL. - STA. 124+50, CL. (DOUBLE SOLID)
 STA. 122+46, RT.

DURABLE 24" STOP BAR
 STA. 122+47, RT. - STA. 122+70, RT.

REMOVING SIGNS
 AS SHOWN - 2

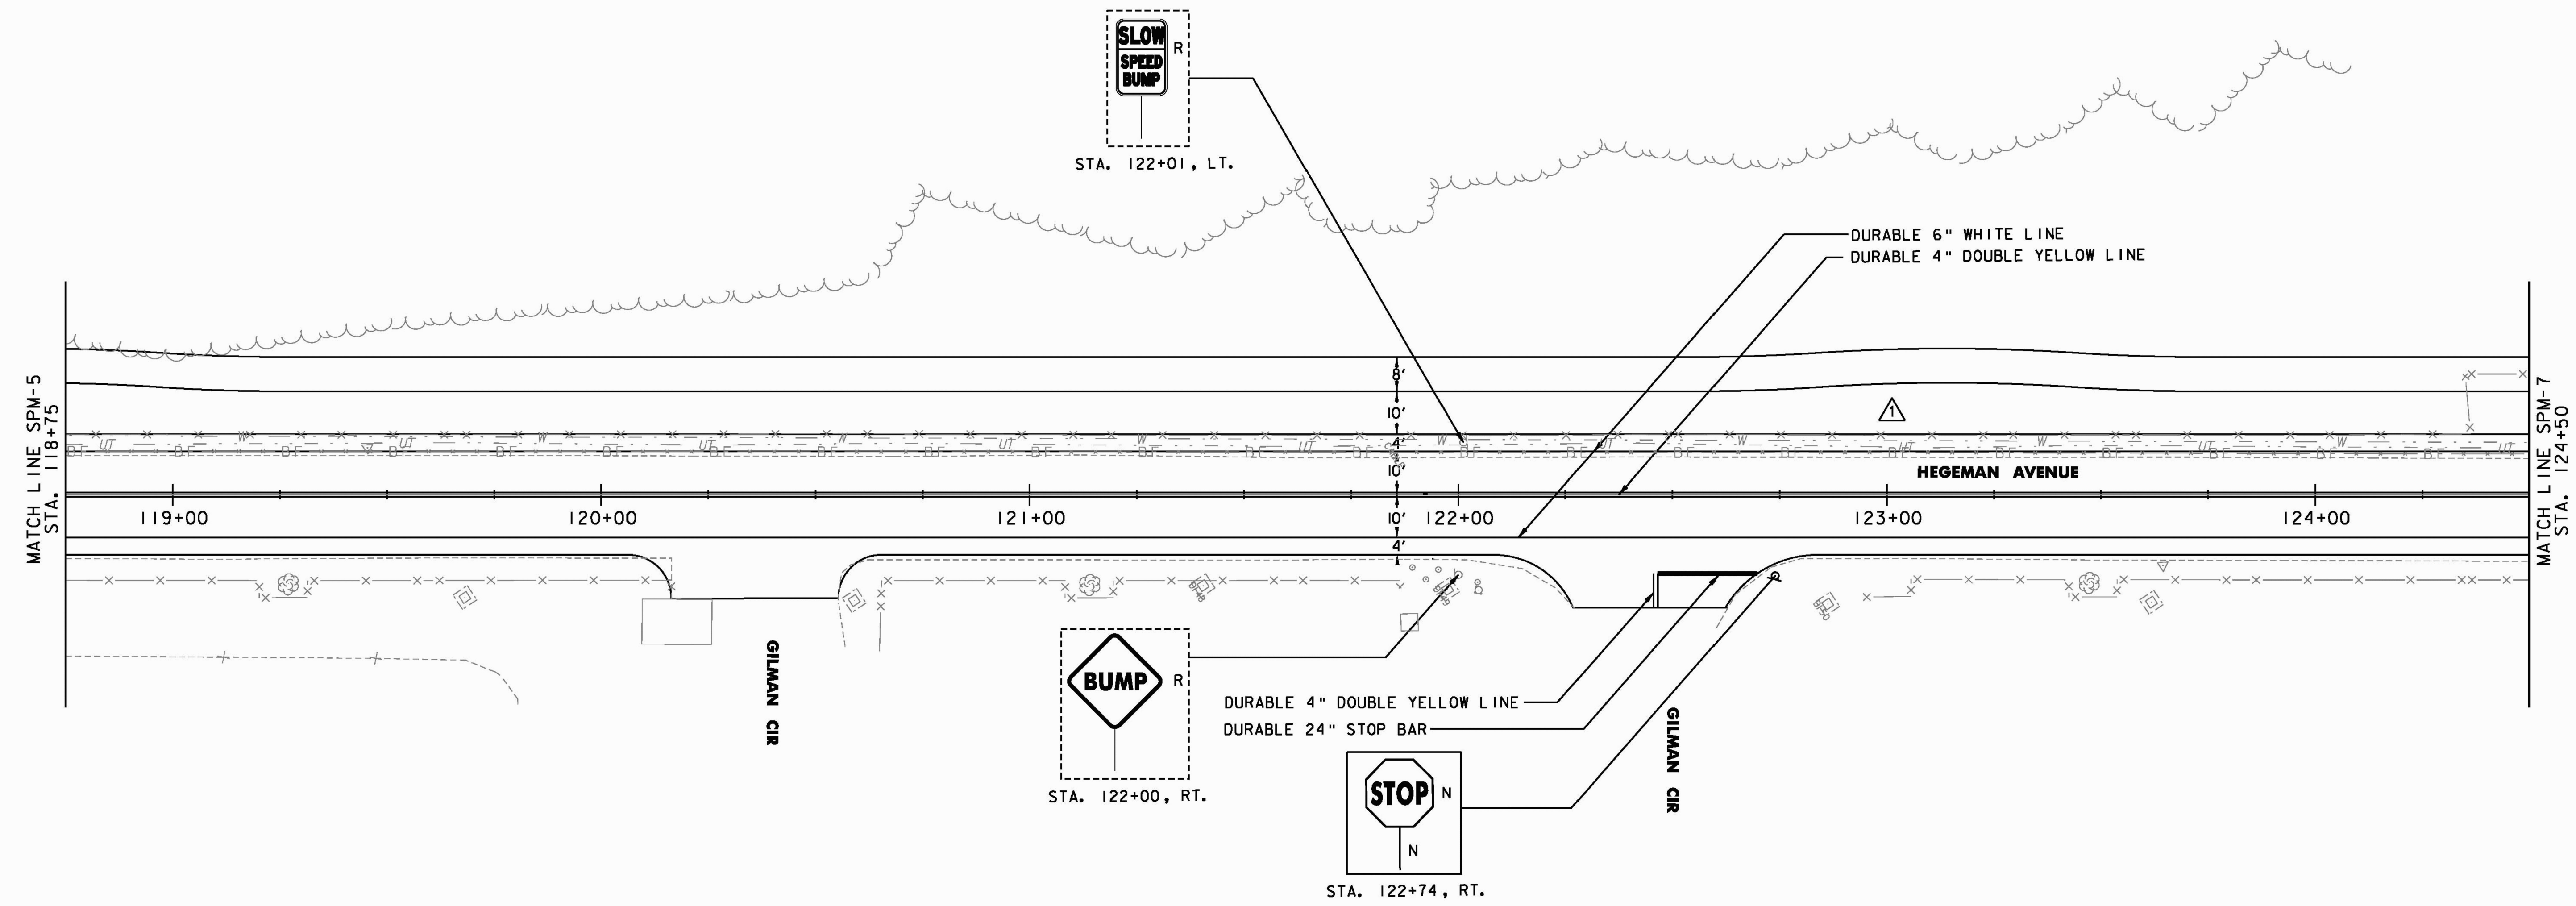

SIGN & DELINEATOR LEGEND


- N = NEW
- R = REMOVE
- R&S = REMOVE & SALVAGE
- S = SALVAGE SIGN
- RET = RETAIN
- = BACK TO BACK
- (B-B) = MATCH EXISTING CONDITIONS
- = EXISTING
- = PROPOSED

SIGNAGE PLAN NOTES:

1. ALL EXISTING SIGNS NOT SHOWN SHALL BE RETAINED UNLESS DIRECTED OTHERWISE BY THE RESIDENT ENGINEER.
2. SEE VTrans STANDARD E-121 FOR STANDARD SIGN PLACEMENT.
3. ALL TEMPORARY PAVEMENT MARKINGS SHALL BE TEMPORARY 4" LINE. TEMPORARY LETTER OR SYMBOL REQUIRED FOR TURN ARROWS ONLY.

RECORD DRAWING
DATE: DECEMBER 21, 2012

REVISION	BY	DATE
ADDENDUM - 1	JBL	01/24/11

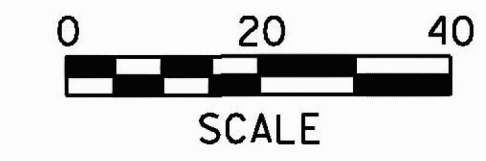

PROJECT NAME:	COLCHESTER CAMPUS CONNECTOR
PROJECT NUMBER:	TCSP TCSE (007)
FILE NAME: ... \plot\files\087-094_sign.prf	PLOT DATE: 4/22/2011
PROJECT LEADER: JBL	DRAWN BY: PZA
DESIGNED BY: TFD	CHECKED BY: GGG
SIGNING/PVT MARKING PLAN SPM-6 SHEET 88 OF 153	