


YIELD LINE LAYOUT
NOT TO SCALE

YIELD LINE NOTES:

1. DIMENSIONS ARE TYPICAL. TRIANGLES PATTERN SHOULD COVER ENTIRE PAVEMENT WIDTH AT LOCATION SHOWN ON PLANS.
2. THE YIELD LINE SHALL BE PAID AS ITEM 646.490 - DURABLE LETTER OR SYMBOL. EACH TRIANGLE SHALL BE CONSIDERED ONE SYMBOL.

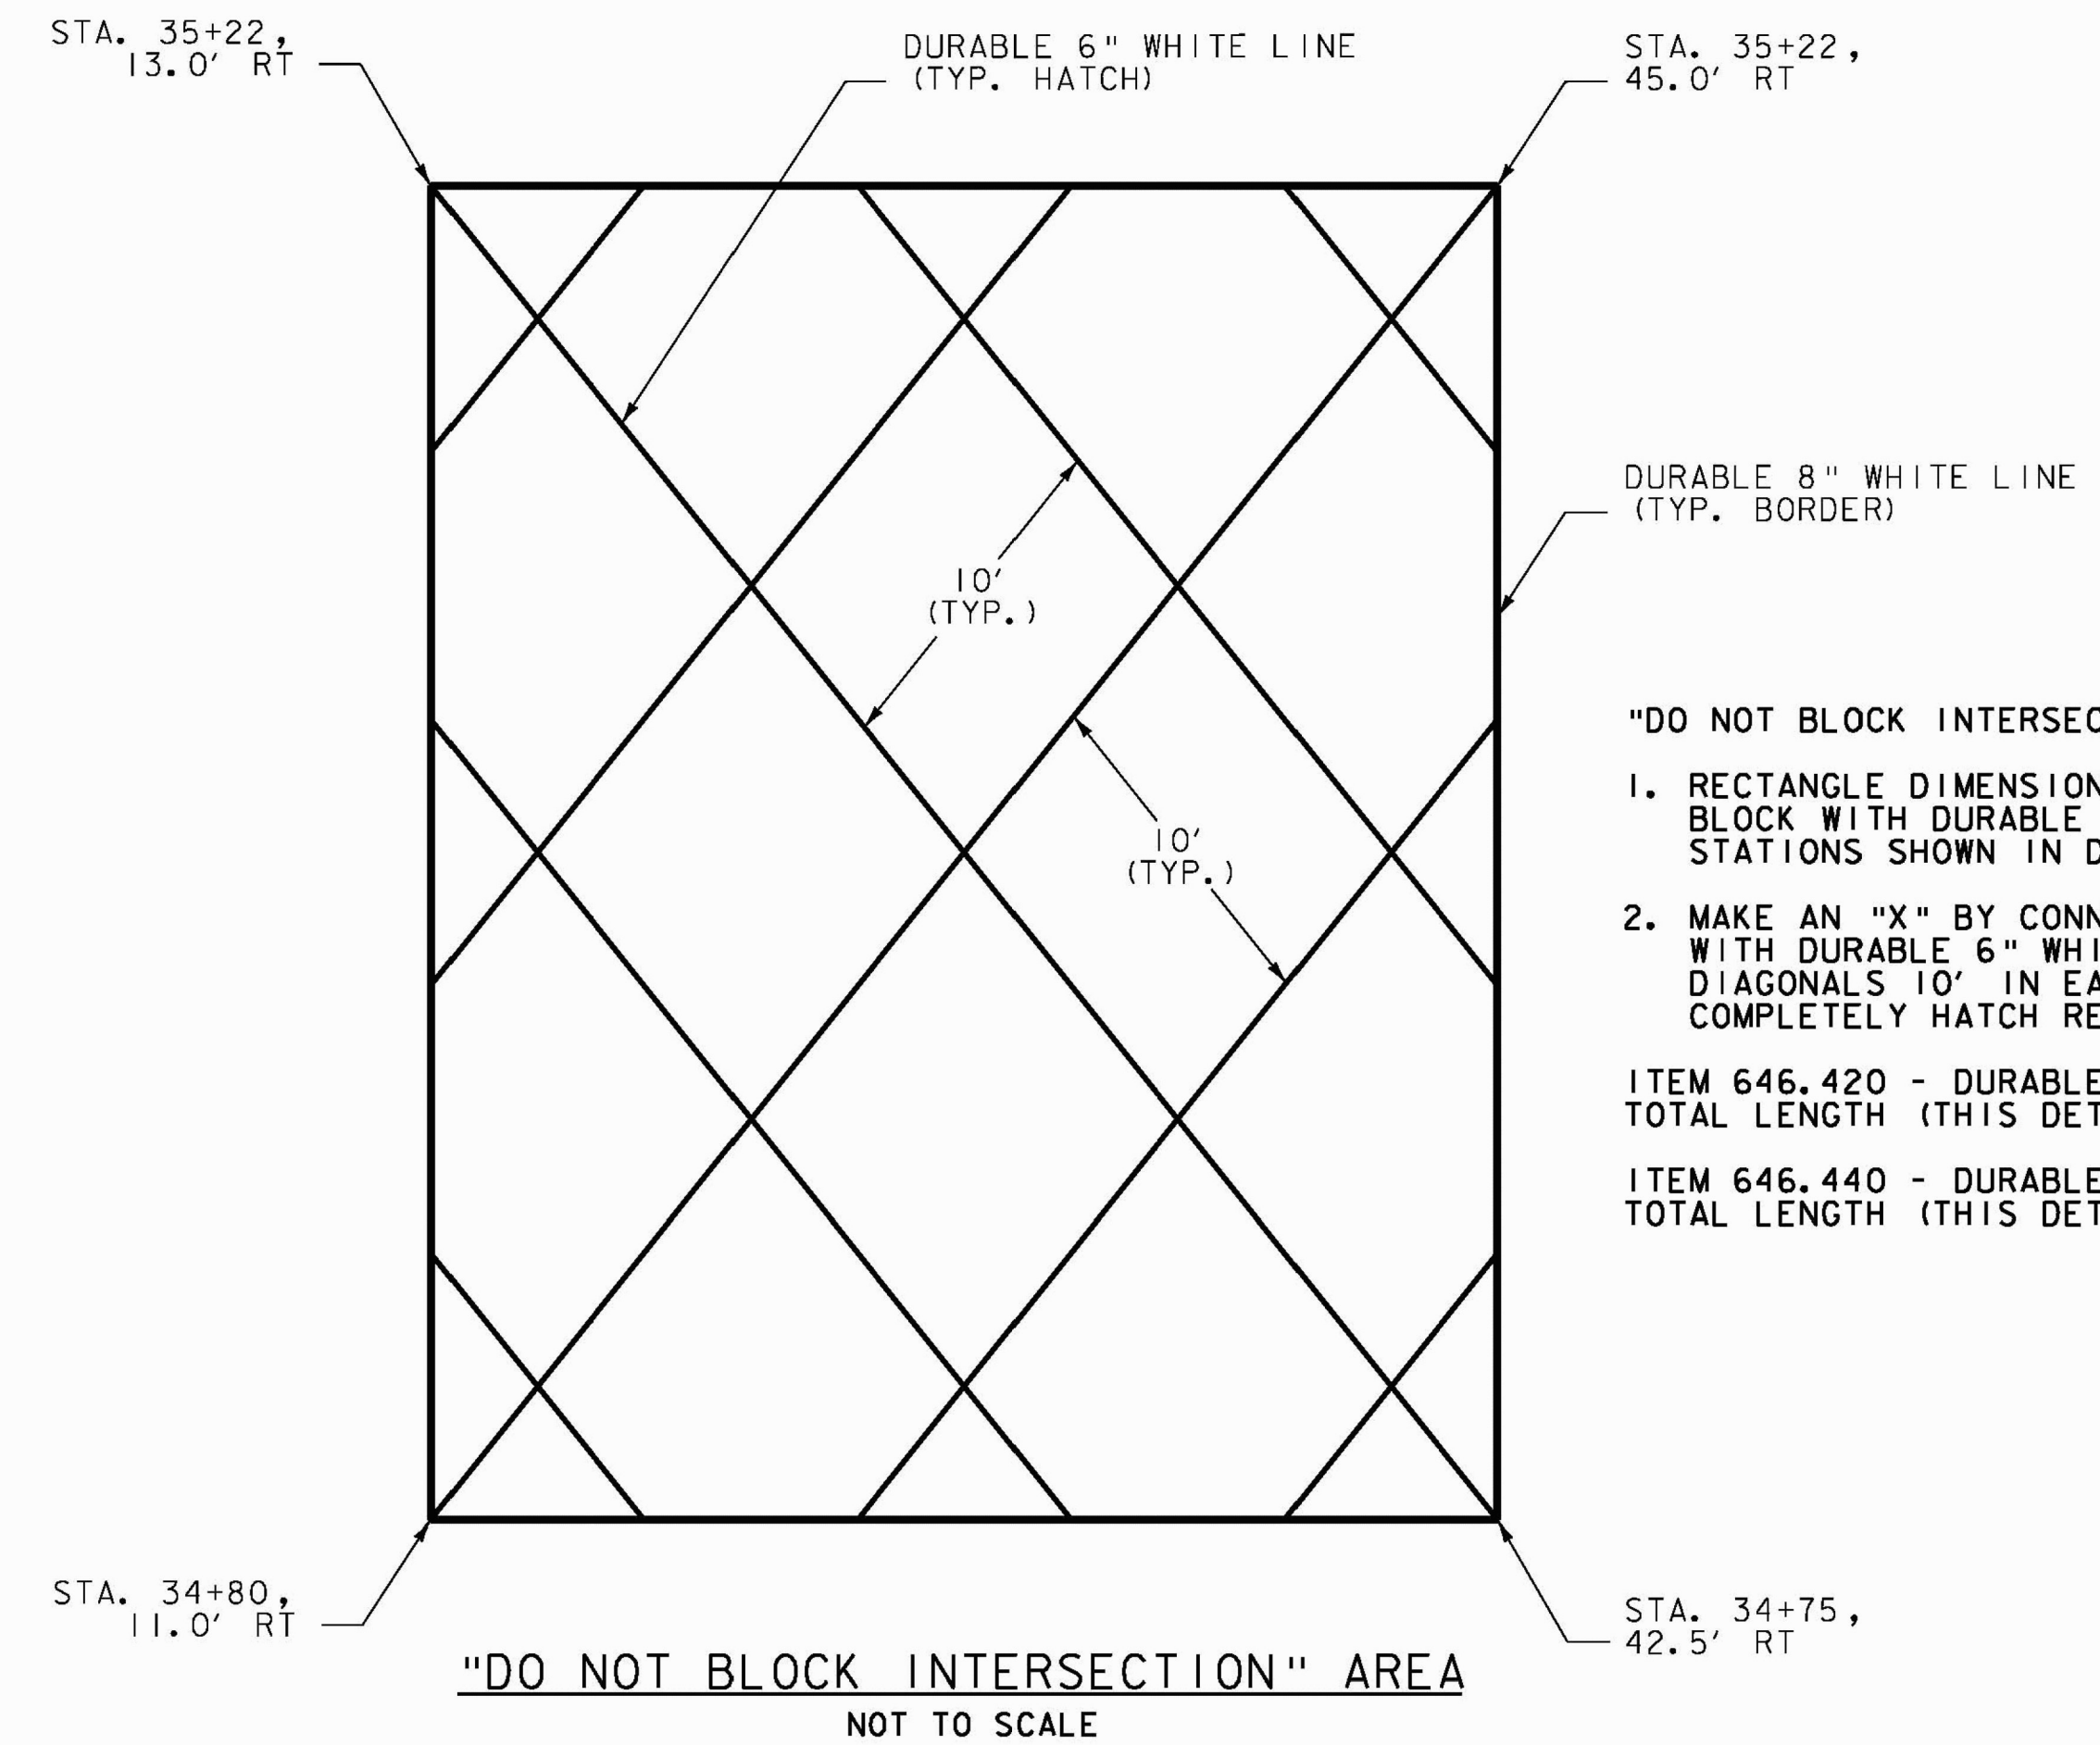


"DO NOT BLOCK INTERSECTION" NOTES:

1. RECTANGLE DIMENSION IS 32' X 40'. STRIPE BLOCK WITH DURABLE 8" WHITE LINE BETWEEN STATIONS SHOWN IN DETAIL.
2. MAKE AN "X" BY CONNECT RECTANGLE CORNERS WITH DURABLE 6" WHITE LINE. OFFSET THE DIAGONALS 10' IN EACH DIRECTION TO COMPLETELY HATCH RECTANGLE, AS SHOWN.

ITEM 646.420 - DURABLE 6" WHITE LINE
TOTAL LENGTH (THIS DETAIL ONLY) = 267 LF

ITEM 646.440 - DURABLE 8" WHITE LINE
TOTAL LENGTH (THIS DETAIL ONLY) = 144 LF

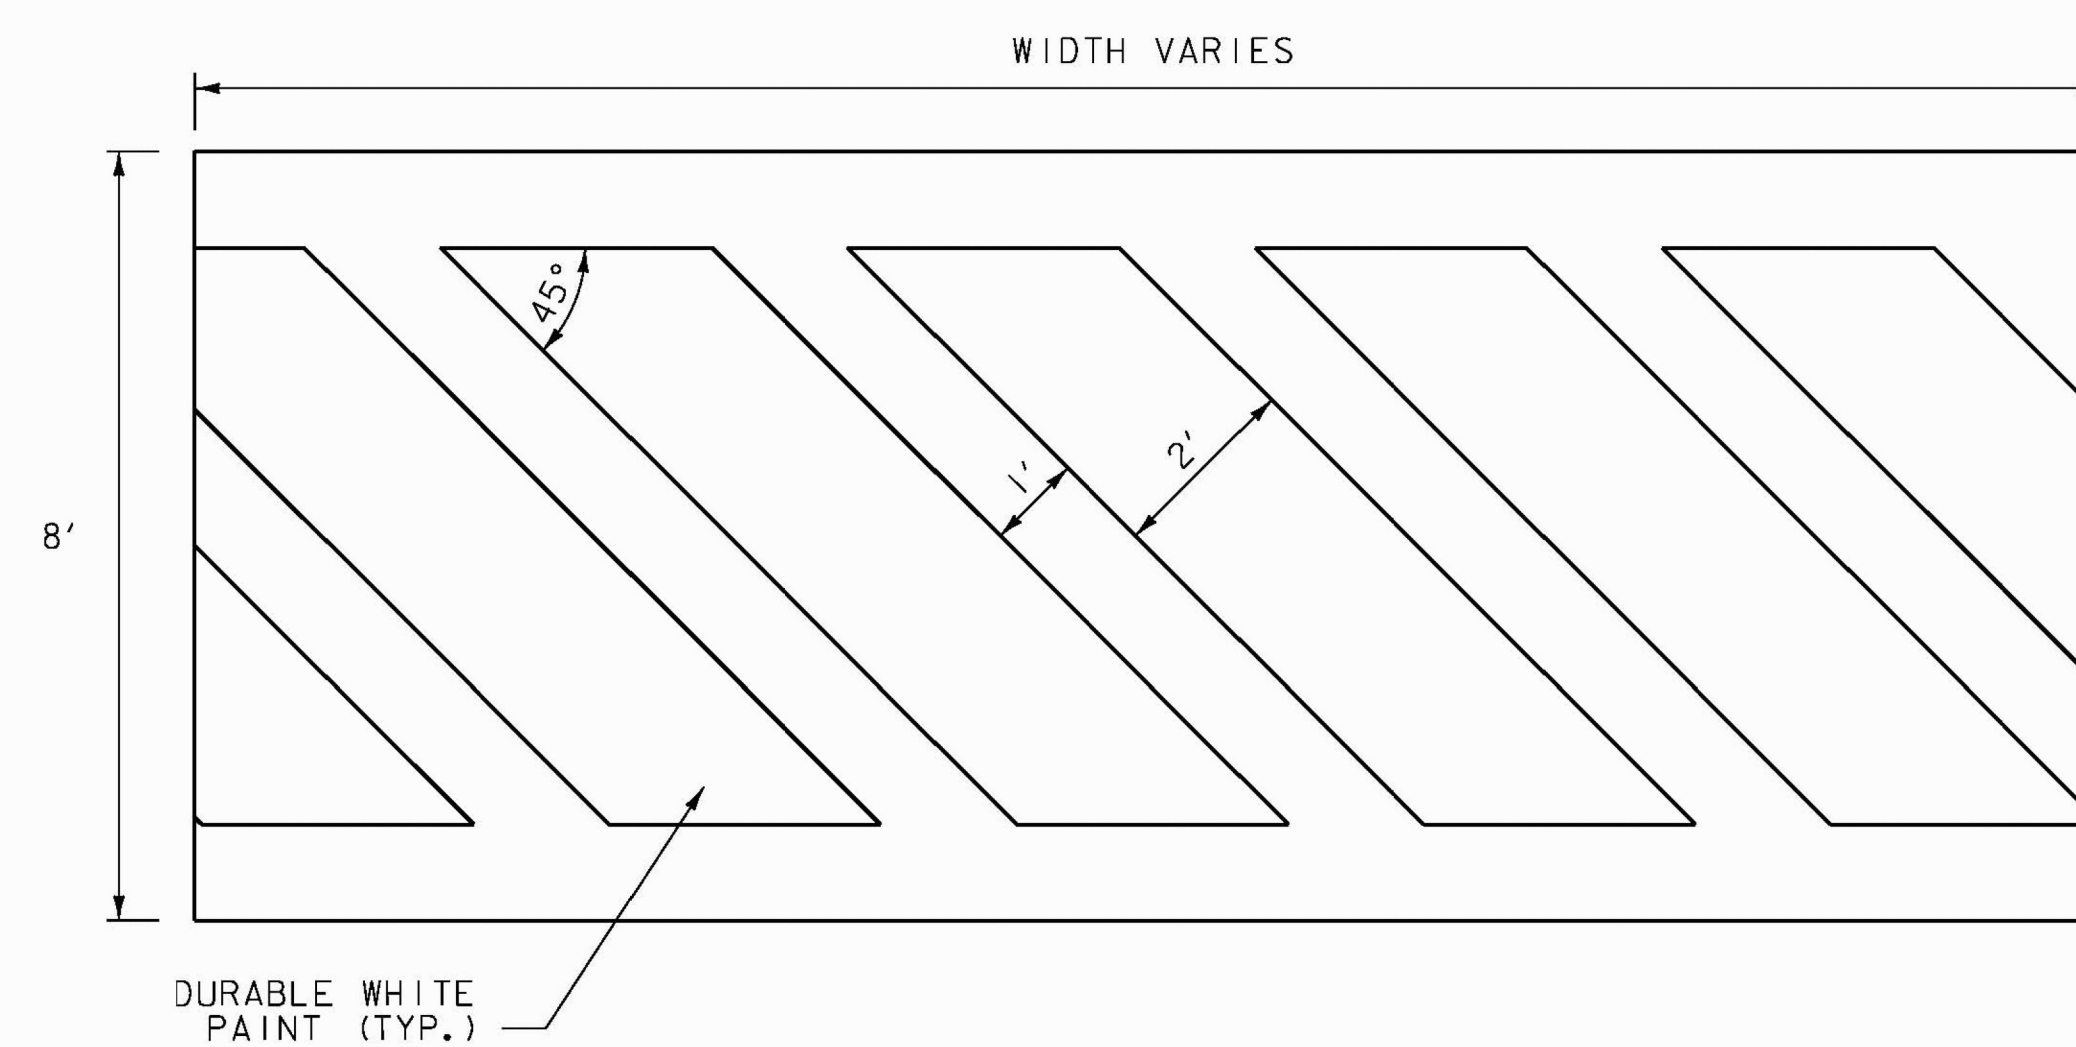

DURABLE CROSSWALK MARKING
NOT TO SCALE

CROSSWALK NOTES:

1. CROSSWALK WIDTHS VARY. SEE SIGNING/PVT MARKING PLANS FOR LOCATIONS AND LENGTHS.
2. FOR MORE DETAIL ON CROSSWALK CONSTRUCTION SEE VTRANS STANDARD DETAIL E-191.
3. DURABLE CROSSWALK MARKINGS SHALL BE PAID AS ITEM 646.500 DURABLE CROSSWALK MARKING.

RECORD DRAWING
DATE: DECEMBER 21, 2012

PROJECT NAME: COLCHESTER CAMPUS CONNECTOR
PROJECT NUMBER: TCSP TCSE (007)

FILE NAME: ... \Plot Files\095_spm det.ptf PLOT DATE: 12/2/2010
PROJECT LEADER: JBL DRAWN BY: TFD
DESIGNED BY: TFD CHECKED BY: GGG
SIGNING/PVT MARKING DETAIL SPD-1 SHEET 91 OF 153

