


JOHNSON AVENUE EXT STA. BL 102+05.85 =
 MAINLINE PT STA. 102+05.85

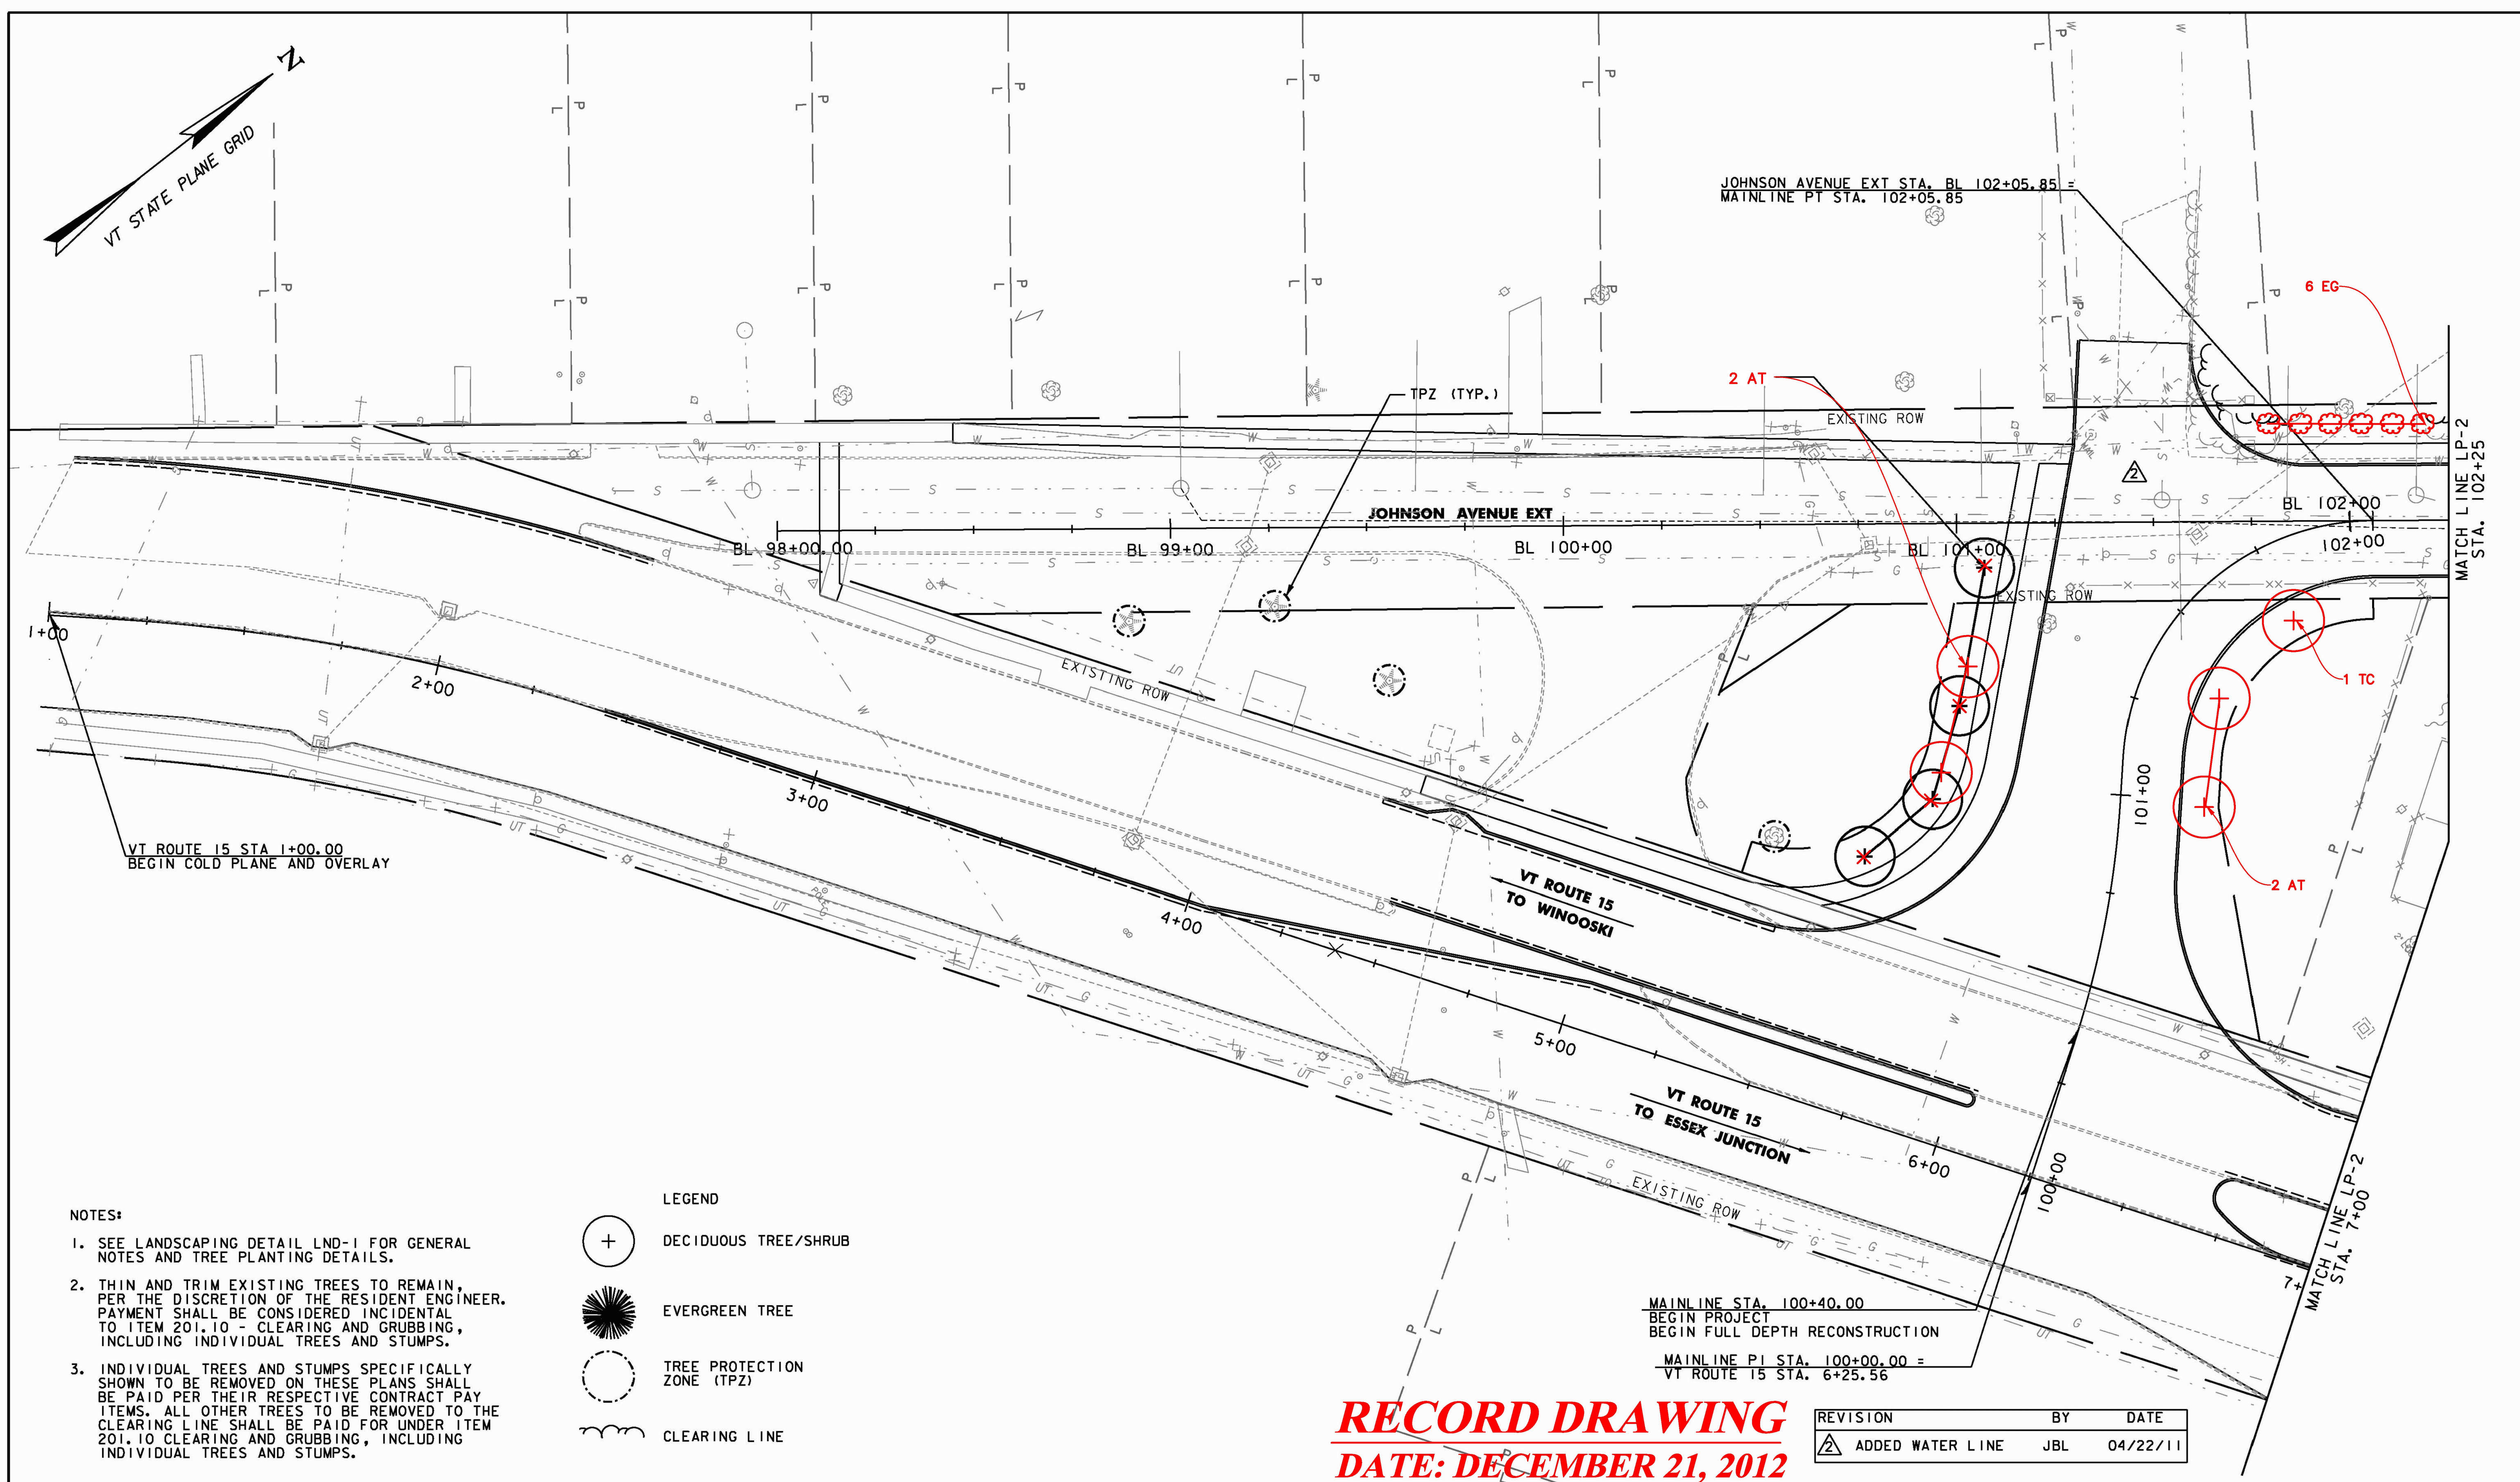

NOTES:

1. SEE LANDSCAPING DETAIL LND-1 FOR GENERAL NOTES AND TREE PLANTING DETAILS.
2. THIN AND TRIM EXISTING TREES TO REMAIN, PER THE DISCRETION OF THE RESIDENT ENGINEER. PAYMENT SHALL BE CONSIDERED INCIDENTAL TO ITEM 201.10 - CLEARING AND GRUBBING, INCLUDING INDIVIDUAL TREES AND STUMPS.
3. INDIVIDUAL TREES AND STUMPS SPECIFICALLY SHOWN TO BE REMOVED ON THESE PLANS SHALL BE PAID PER THEIR RESPECTIVE CONTRACT PAY ITEMS. ALL OTHER TREES TO BE REMOVED TO THE CLEARING LINE SHALL BE PAID FOR UNDER ITEM 201.10 CLEARING AND GRUBBING, INCLUDING INDIVIDUAL TREES AND STUMPS.

LEGEND


	DECIDUOUS TREE/SHRUB
	EVERGREEN TREE
	TREE PROTECTION ZONE (TPZ)
	CLEARING LINE

MAINLINE STA. 100+40.00
 BEGIN PROJECT
 BEGIN FULL DEPTH RECONSTRUCTION
 MAINLINE PI STA. 100+00.00 =
 VT ROUTE 15 STA. 6+25.56

RECORD DRAWING
DATE: DECEMBER 21, 2012

REVISION	BY	DATE
1	JBL	04/22/11

PLANTING SCHEDULE					
QTY.	SYMBOL	BOTANICAL NAME	COMMON NAME	SPECIFICATIONS	REMARKS
4	AT	ACER TATARICUM	TATARIAN MAPLE	2-1/2 TO 3" CALIPER	6' BRANCH HEIGHT 30' O.C.
1	TC	TILIA CORDATA 'GREEN SPIRE'	GREEN SPIRE LITTLE LEAF LINDEN	2-1/2 TO 3" CALIPER	6' BRANCH HEIGHT
6	EG	THUJA OCCIDENTALIS 'SMARAGD'	EMERALD GREEN ARBORVITAE	7' TO 8' HEIGHT	SPECIMEN QUALITY/BB

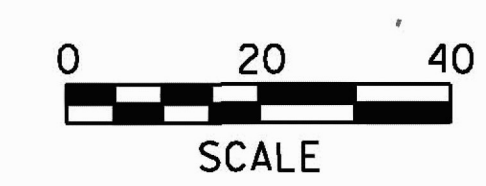

PROJECT NAME:	COLCHESTER CAMPUS CONNECTOR
PROJECT NUMBER:	TCSP TCSE (007)
FILE NAME:	... \plotfiles\101-108_Land.pptf
PROJECT LEADER:	JBL
DESIGNED BY:	TFD
CHECKED BY:	GGG
LANDSCAPING PLAN	LP-1
PLOT DATE:	4/22/2011
DRAWN BY:	PZA
CHECKED BY:	GGG
SHEET	97 OF 153