



PLANTING SCHEDULE					
QTY.	SYMBOL	BOTANICAL NAME	COMMON NAME	SPECIFICATIONS	REMARKS
8	EG	THUJA OCCIDENTALIS 'SMARAGD'	EMERALD GREEN ARBORVITAE	7' TO 8' HEIGHT	SPECIMEN QUALITY/BB
3	SR	SYRINGA RETICULATE 'IVORY SILK'	IVORY SILK JAPANESE TREE LILAC	2-1/2 TO 3" CALIPER	6' BRANCH HEIGHT 30' O.C./BB
4	JV	JUNIPURUS	EASTERN RED CEDAR	7' TO 8' HEIGHT	SPECIMEN QUALITY/BB
1	TC	TILIA CORDATA 'GREEN SPIRE'	GREEN SPIRE LITTLE LEAF LINDEN	2-1/2 TO 3" CALIPER	6' BRANCH HEIGHT

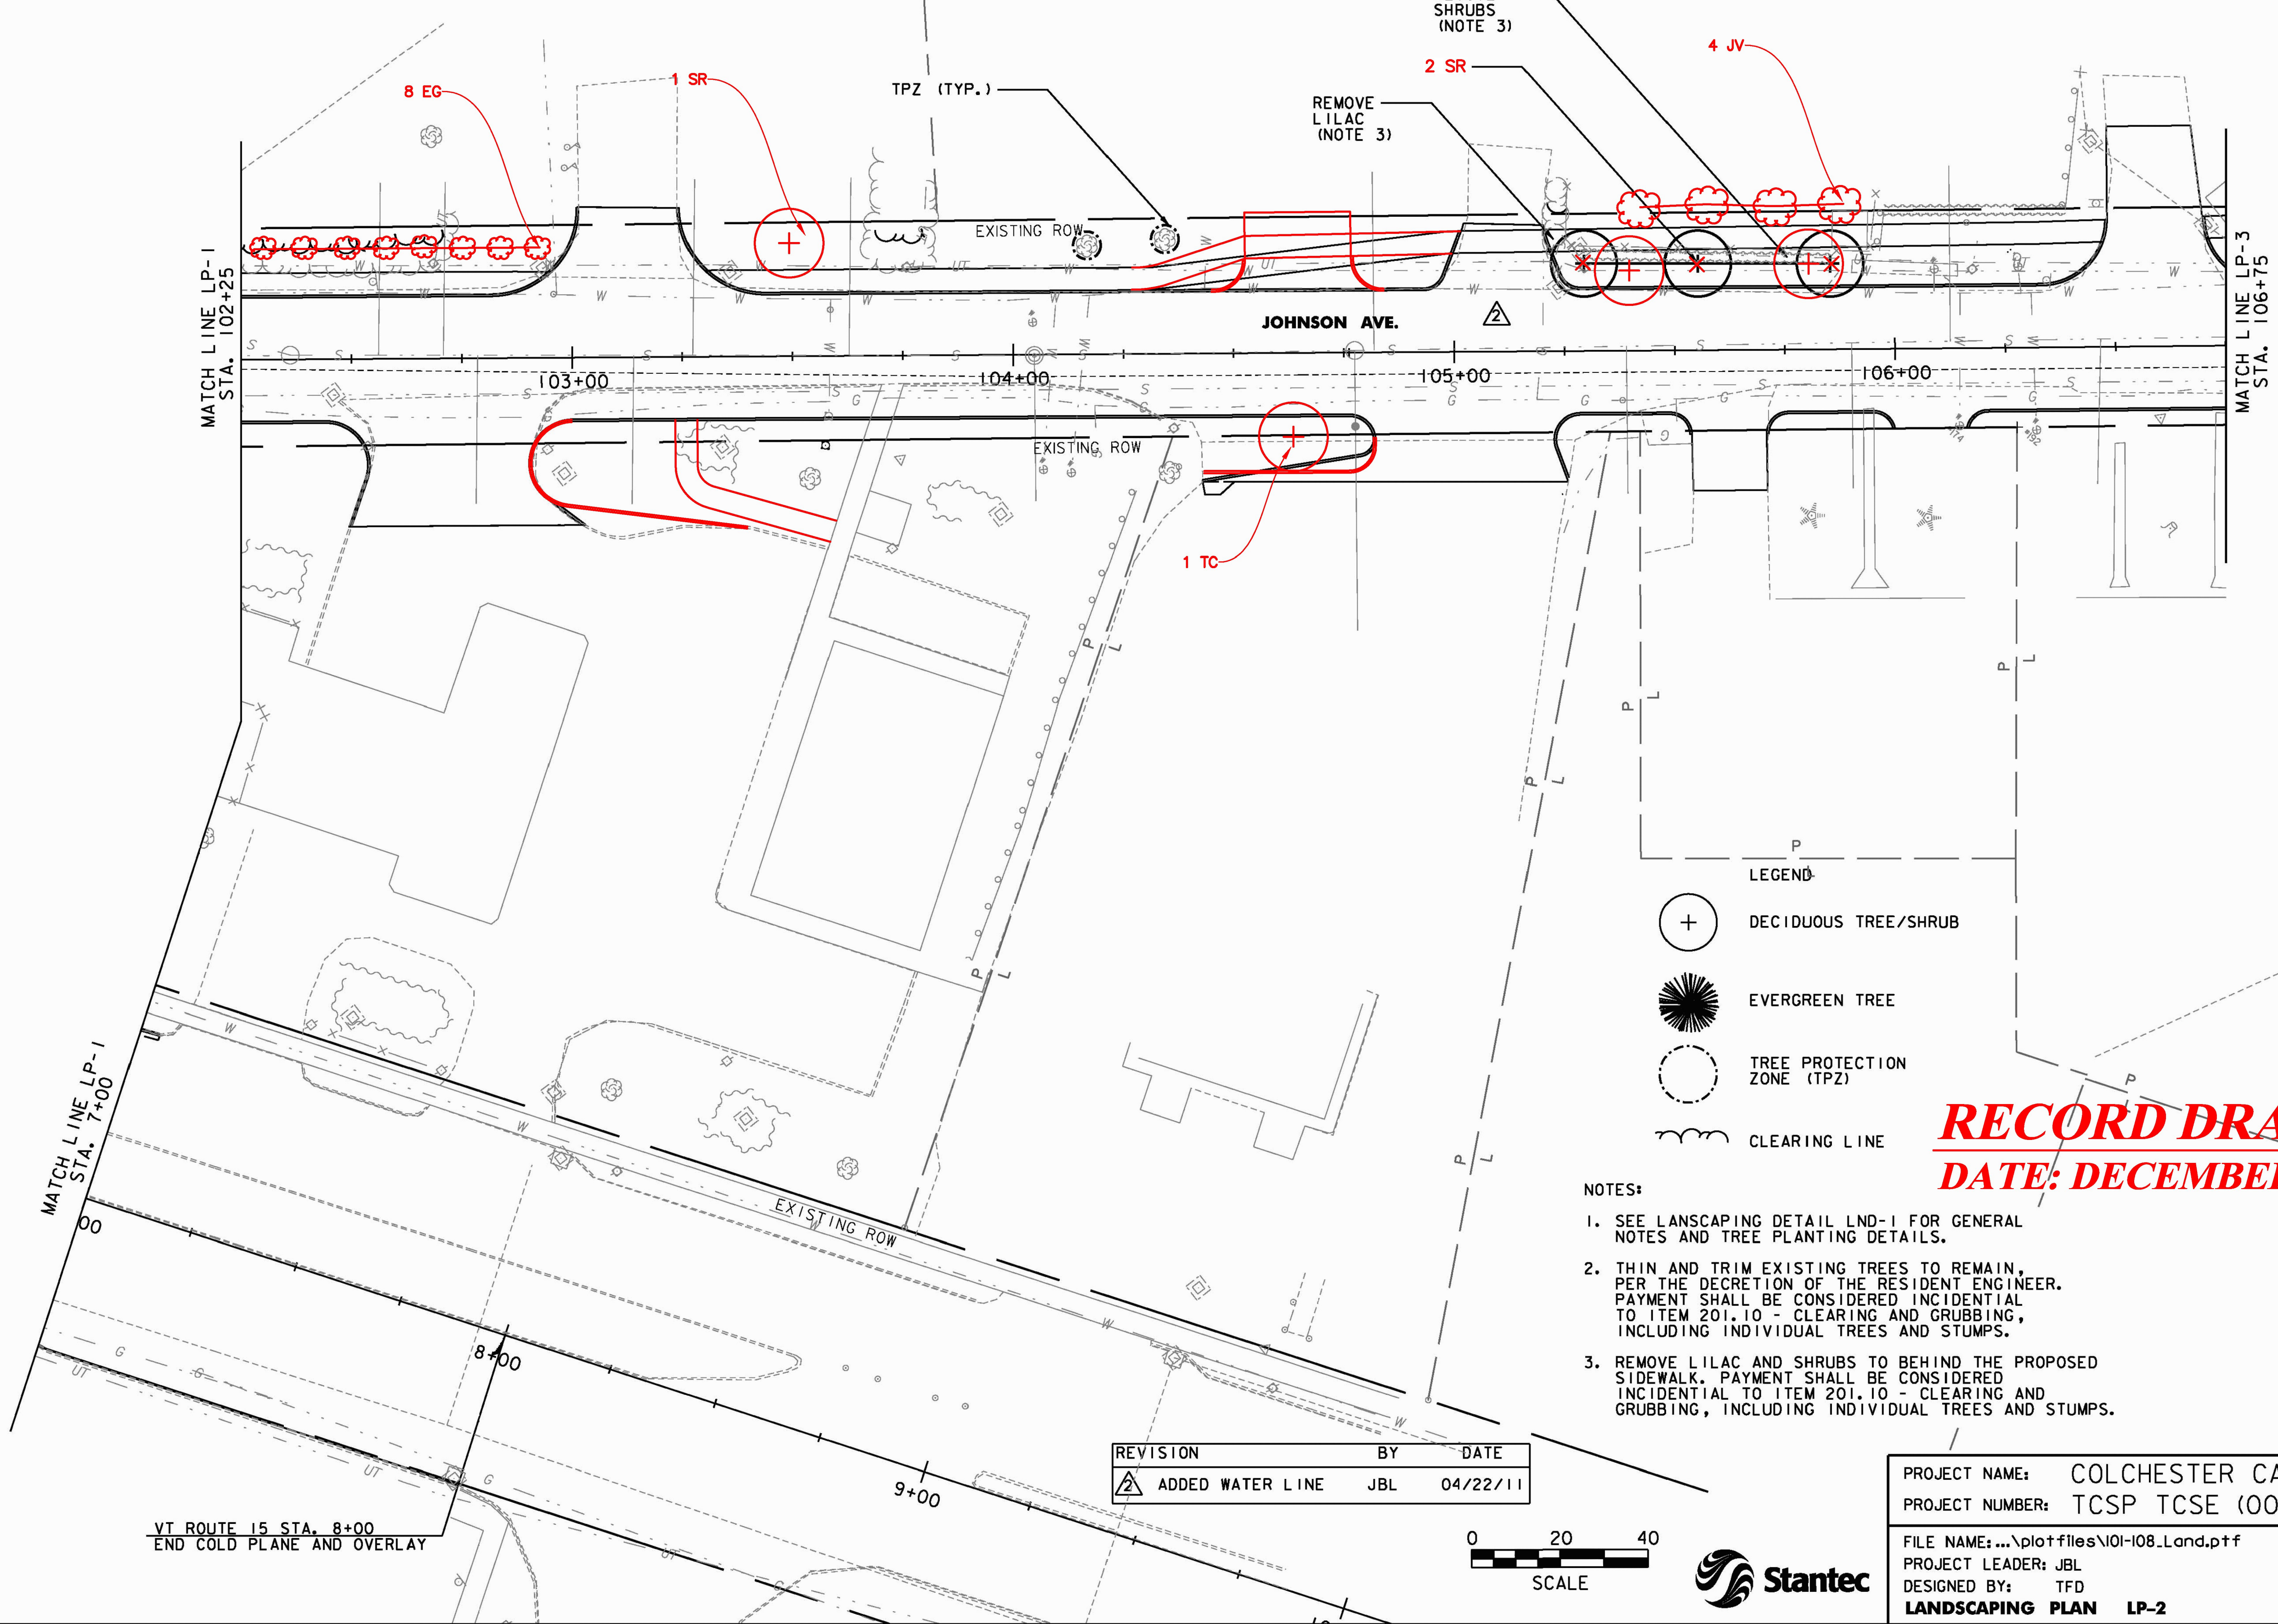

RECORD DRAWING
DATE: DECEMBER 21, 2012

- NOTES:
- SEE LANDSCAPING DETAIL LND-1 FOR GENERAL NOTES AND TREE PLANTING DETAILS.
 - THIN AND TRIM EXISTING TREES TO REMAIN, PER THE DECISION OF THE RESIDENT ENGINEER. PAYMENT SHALL BE CONSIDERED INCIDENTAL TO ITEM 201.10 - CLEARING AND GRUBBING, INCLUDING INDIVIDUAL TREES AND STUMPS.
 - REMOVE LILAC AND SHRUBS TO BEHIND THE PROPOSED SIDEWALK. PAYMENT SHALL BE CONSIDERED INCIDENTAL TO ITEM 201.10 - CLEARING AND GRUBBING, INCLUDING INDIVIDUAL TREES AND STUMPS.

REVISION	BY	DATE
1	JBL	04/22/11

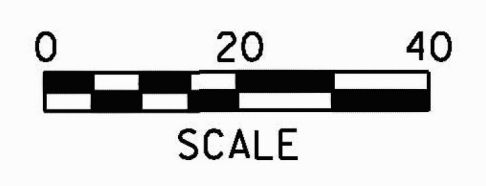

PROJECT NAME:	COLCHESTER CAMPUS CONNECTOR	FILE NAME:	...\\plotfiles\101-108.Land.ptf	PLOT DATE:	4/22/2011
PROJECT NUMBER:	TCSP TCSE (007)	PROJECT LEADER:	JBL	DRAWN BY:	PZA
		DESIGNED BY:	TFD	CHECKED BY:	GGG
		LANDSCAPING PLAN LP-2			SHEET 98 OF 153