

REMOVE MEDIUM STUMP  
STA. 108+21, LT

REMOVE MEDIUM TREE  
STA. 108+54, LT

REMOVE MEDIUM TREE


REMOVE MEDIUM STUMP

TPZ (TYP.)

JOHNSON AVE.

MATCH LINE LP-2  
STA. 106+75

107+00

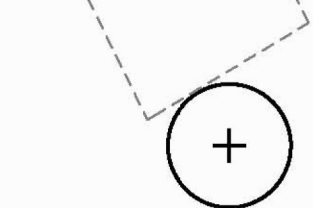

LEGEND  
DECIDUOUS TREE/SHRUB



EVERGREEN TREE



TREE PROTECTION ZONE (TPZ)



CLEARING LINE

NOTES:

- SEE LANDSCAPING DETAIL LND-1 FOR GENERAL NOTES AND TREE PLANTING DETAILS.
- THIN AND TRIM EXISTING TREES TO REMAIN, PER THE DECISION OF THE RESIDENT ENGINEER. PAYMENT SHALL BE CONSIDERED INCIDENTAL TO ITEM 201.10 - CLEARING AND GRUBBING, INCLUDING INDIVIDUAL TREES AND STUMPS.

PLANTING SCHEDULE					
QTY.	SYMBOL	BOTANICAL NAME	COMMON NAME	SPECIFICATIONS	REMARKS
5	FP	FRAXINUS PENNSYLVANICA 'PATMORE'	PATMORE GREEN ASH	2-1/2 TO 3" CALIPER	6' BRANCH HEIGHT 50' O.C./BB
6	MSDW	MALUS SPP. 'DONALD WYMAN'	DONALD WYMAN CRABAPPLE	2-1/2 TO 3" CALIPER	6' BRANCH HEIGHT 30' O.C./BB
8	MSST	MALUS SPP. 'SUGAR TYME'	SUGAR TYME CRABAPPLE	2-1/2 TO 3" CALIPER	6' BRANCH HEIGHT 30' O.C./BB
6	QR	QUERCUS RUBRA	RED OAK	2-1/2 TO 3" CALIPER	6' BRANCH HEIGHT 50' O.C./BB


VT NATIONAL GUARD DRIVE STA. 35+56.51 LT  
VT NATIONAL GUARD DRIVE STA. 35+59.64 RT  
END FULL DEPTH CONSTRUCTION  
MAINLINE STA. 109+66.45 =  
VT NATIONAL GUARD ROAD  
STA. 35+10.10

6 QR

5 FP

6 MSDW

8 MSST

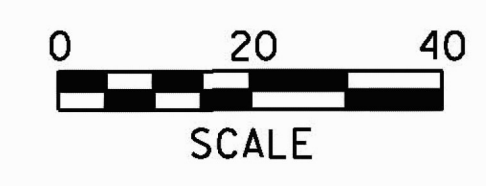

**RECORD DRAWING**  
**DATE: DECEMBER 21, 2012**

REVISION	BY	DATE
ADDENDUM - 1	JBL	01/24/11
ADDED WATER LINE UTILITY ACCESS METER VAULT	JBL	04/22/11

PROJECT NAME: COLCHESTER CAMPUS CONNECTOR  
PROJECT NUMBER: TCSP TCSE (007)

FILE NAME: ...plotfiles\101-108\_Land.ptf PLOT DATE: 4/22/2011  
PROJECT LEADER: JBL DRAWN BY: PZA  
DESIGNED BY: TFD CHECKED BY: GGG  
**LANDSCAPING PLAN LP-3** SHEET 99 OF 153

