


PLANTING SCHEDULE					
QTY.	SYMBOL	BOTANICAL NAME	COMMON NAME	SPECIFICATIONS	REMARKS
7	MSDW	MALUS SPP. 'DONALD WYMAN'	DONALD WYMAN CRABAPPLE	2-1/2 TO 3" CALIPER	6' BRANCH HEIGHT 30' O.C./BB
4	MSST	MALUS SPP. 'SUGAR TYME'	SUGAR TYME CRABAPPLE	2-1/2 TO 3" CALIPER	6' BRANCH HEIGHT 30' O.C./BB

REVISION	BY	DATE
ADDENDUM - 1	JBL	01/24/11

RECORD DRAWING
DATE: DECEMBER 21, 2012

- NOTES:
- SEE LANDSCAPING DETAIL LND-1 FOR GENERAL NOTES AND TREE PLANTING DETAILS.
 - THIN AND TRIM EXISTING TREES TO REMAIN, PER THE DECISION OF THE RESIDENT ENGINEER. PAYMENT SHALL BE CONSIDERED INCIDENTAL TO ITEM 201.10 - CLEARING AND GRUBBING, INCLUDING INDIVIDUAL TREES AND STUMPS.

- LEGEND
- DECIDUOUS TREE/SHRUB
 - EVERGREEN TREE
 - TREE PROTECTION ZONE (TPZ)
 - CLEARING LINE

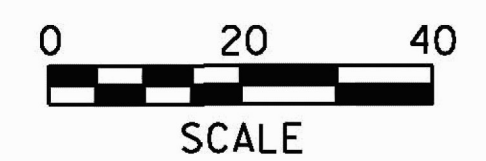

PROJECT NAME: COLCHESTER CAMPUS CONNECTOR	PLOT DATE: 4/22/2011
PROJECT NUMBER: TCSP TCSE (007)	DRAWN BY: PZA
FILE NAME: ...\\plotfiles\101-108_Land.pxf	CHECKED BY: GGG
PROJECT LEADER: JBL	SHEET 100 OF 153
DESIGNED BY: TFD	
LANDSCAPING PLAN LP-4	