


PLANTING SCHEDULE					
QTY.	SYMBOL	BOTANICAL NAME	COMMON NAME	SPECIFICATIONS	REMARKS
2	FP	FRAXINUS PENNSYLVANICA 'PATMORE'	PATMORE GREEN ASH	2-1/2 TO 3" CALIPER	6' BRANCH HEIGHT 50' O.C./BB
6	GD	GYMNOCLADUS DIOICUS	KENTUCKY COFFEE TREE	2-1/2 TO 3" CALIPER	6' BRANCH HEIGHT 50' O.C./BB
3	MSRJ	MALUS SPP. 'RED JEWEL'	RED JEWEL CRABAPPLE	2-1/2 TO 3" CALIPER	6' BRANCH HEIGHT 15' O.C./BB
2	QR	QUERCUS RUBRA	RED OAK	2-1/2 TO 3" CALIPER	6' BRANCH HEIGHT 50' O.C./BB


3 TC TILIA CORDATA 'GREEN SPIRE' GREEN SPIRE LITTLE LEAF LINDEN 2-1/2 TO 3" CALIPER 6' BRANCH HEIGHT

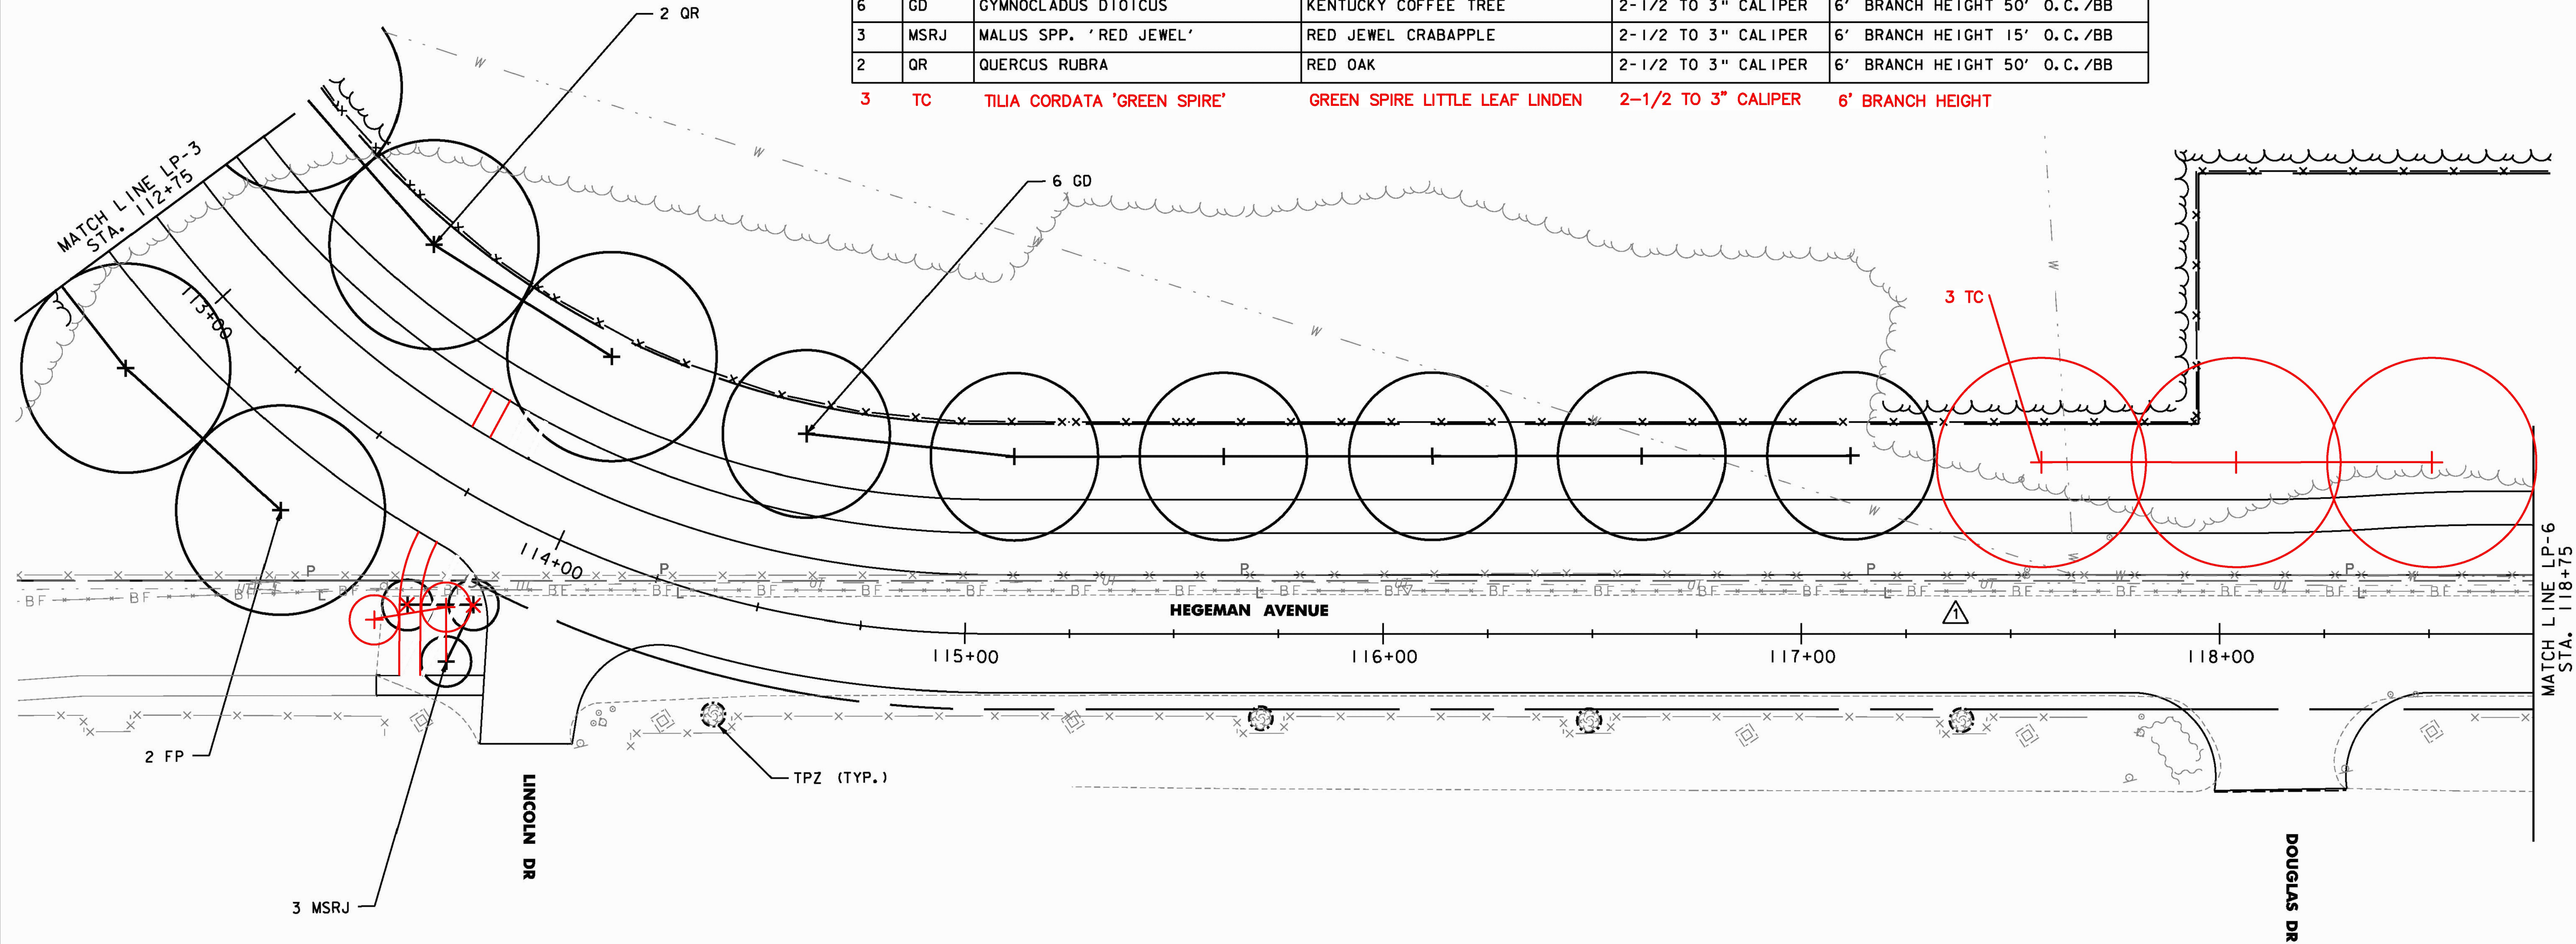

- NOTES:
- SEE LANDSCAPING DETAIL LND-1 FOR GENERAL NOTES AND TREE PLANTING DETAILS.
  - THIN AND TRIM EXISTING TREES TO REMAIN, PER THE DECISION OF THE RESIDENT ENGINEER. PAYMENT SHALL BE CONSIDERED INCIDENTAL TO ITEM 201.10 - CLEARING AND GRUBBING, INCLUDING INDIVIDUAL TREES AND STUMPS.

- LEGEND
- DECIDUOUS TREE/SHRUB
  - EVERGREEN TREE
  - TREE PROTECTION ZONE (TPZ)
  - CLEARING LINE

REVISION	BY	DATE
ADDENDUM - 1	JBL	01/24/11

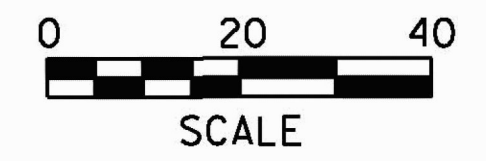

**RECORD DRAWING**  
**DATE: DECEMBER 21, 2012**

PROJECT NAME:	COLCHESTER CAMPUS CONNECTOR
PROJECT NUMBER:	TCSP TCSE (007)
FILE NAME: ... \plotfiles\101-108_Land.pxf	PLOT DATE: 4/22/2011
PROJECT LEADER: JBL	DRAWN BY: PZA
DESIGNED BY: TFD	CHECKED BY: GGG
<b>LANDSCAPING PLAN LP-5</b>	SHEET 101 OF 153