


PLANTING SCHEDULE					
QTY.	SYMBOL	BOTANICAL NAME	COMMON NAME	SPECIFICATIONS	REMARKS
7	TC	TILIA CORDATA 'GREEN SPIRE'	GREEN SPIRE LITTLELEAF LINDEN	2- 1/2 TO 3" CALIPER	6' BRANCH HEIGHT 50' O.C./BB
4	JV	JUNIPERUS VIRGINIANA	EASTERN RED CEDAR	7 TO 8' HEIGHT	SPECIMEN QUALITY/BB

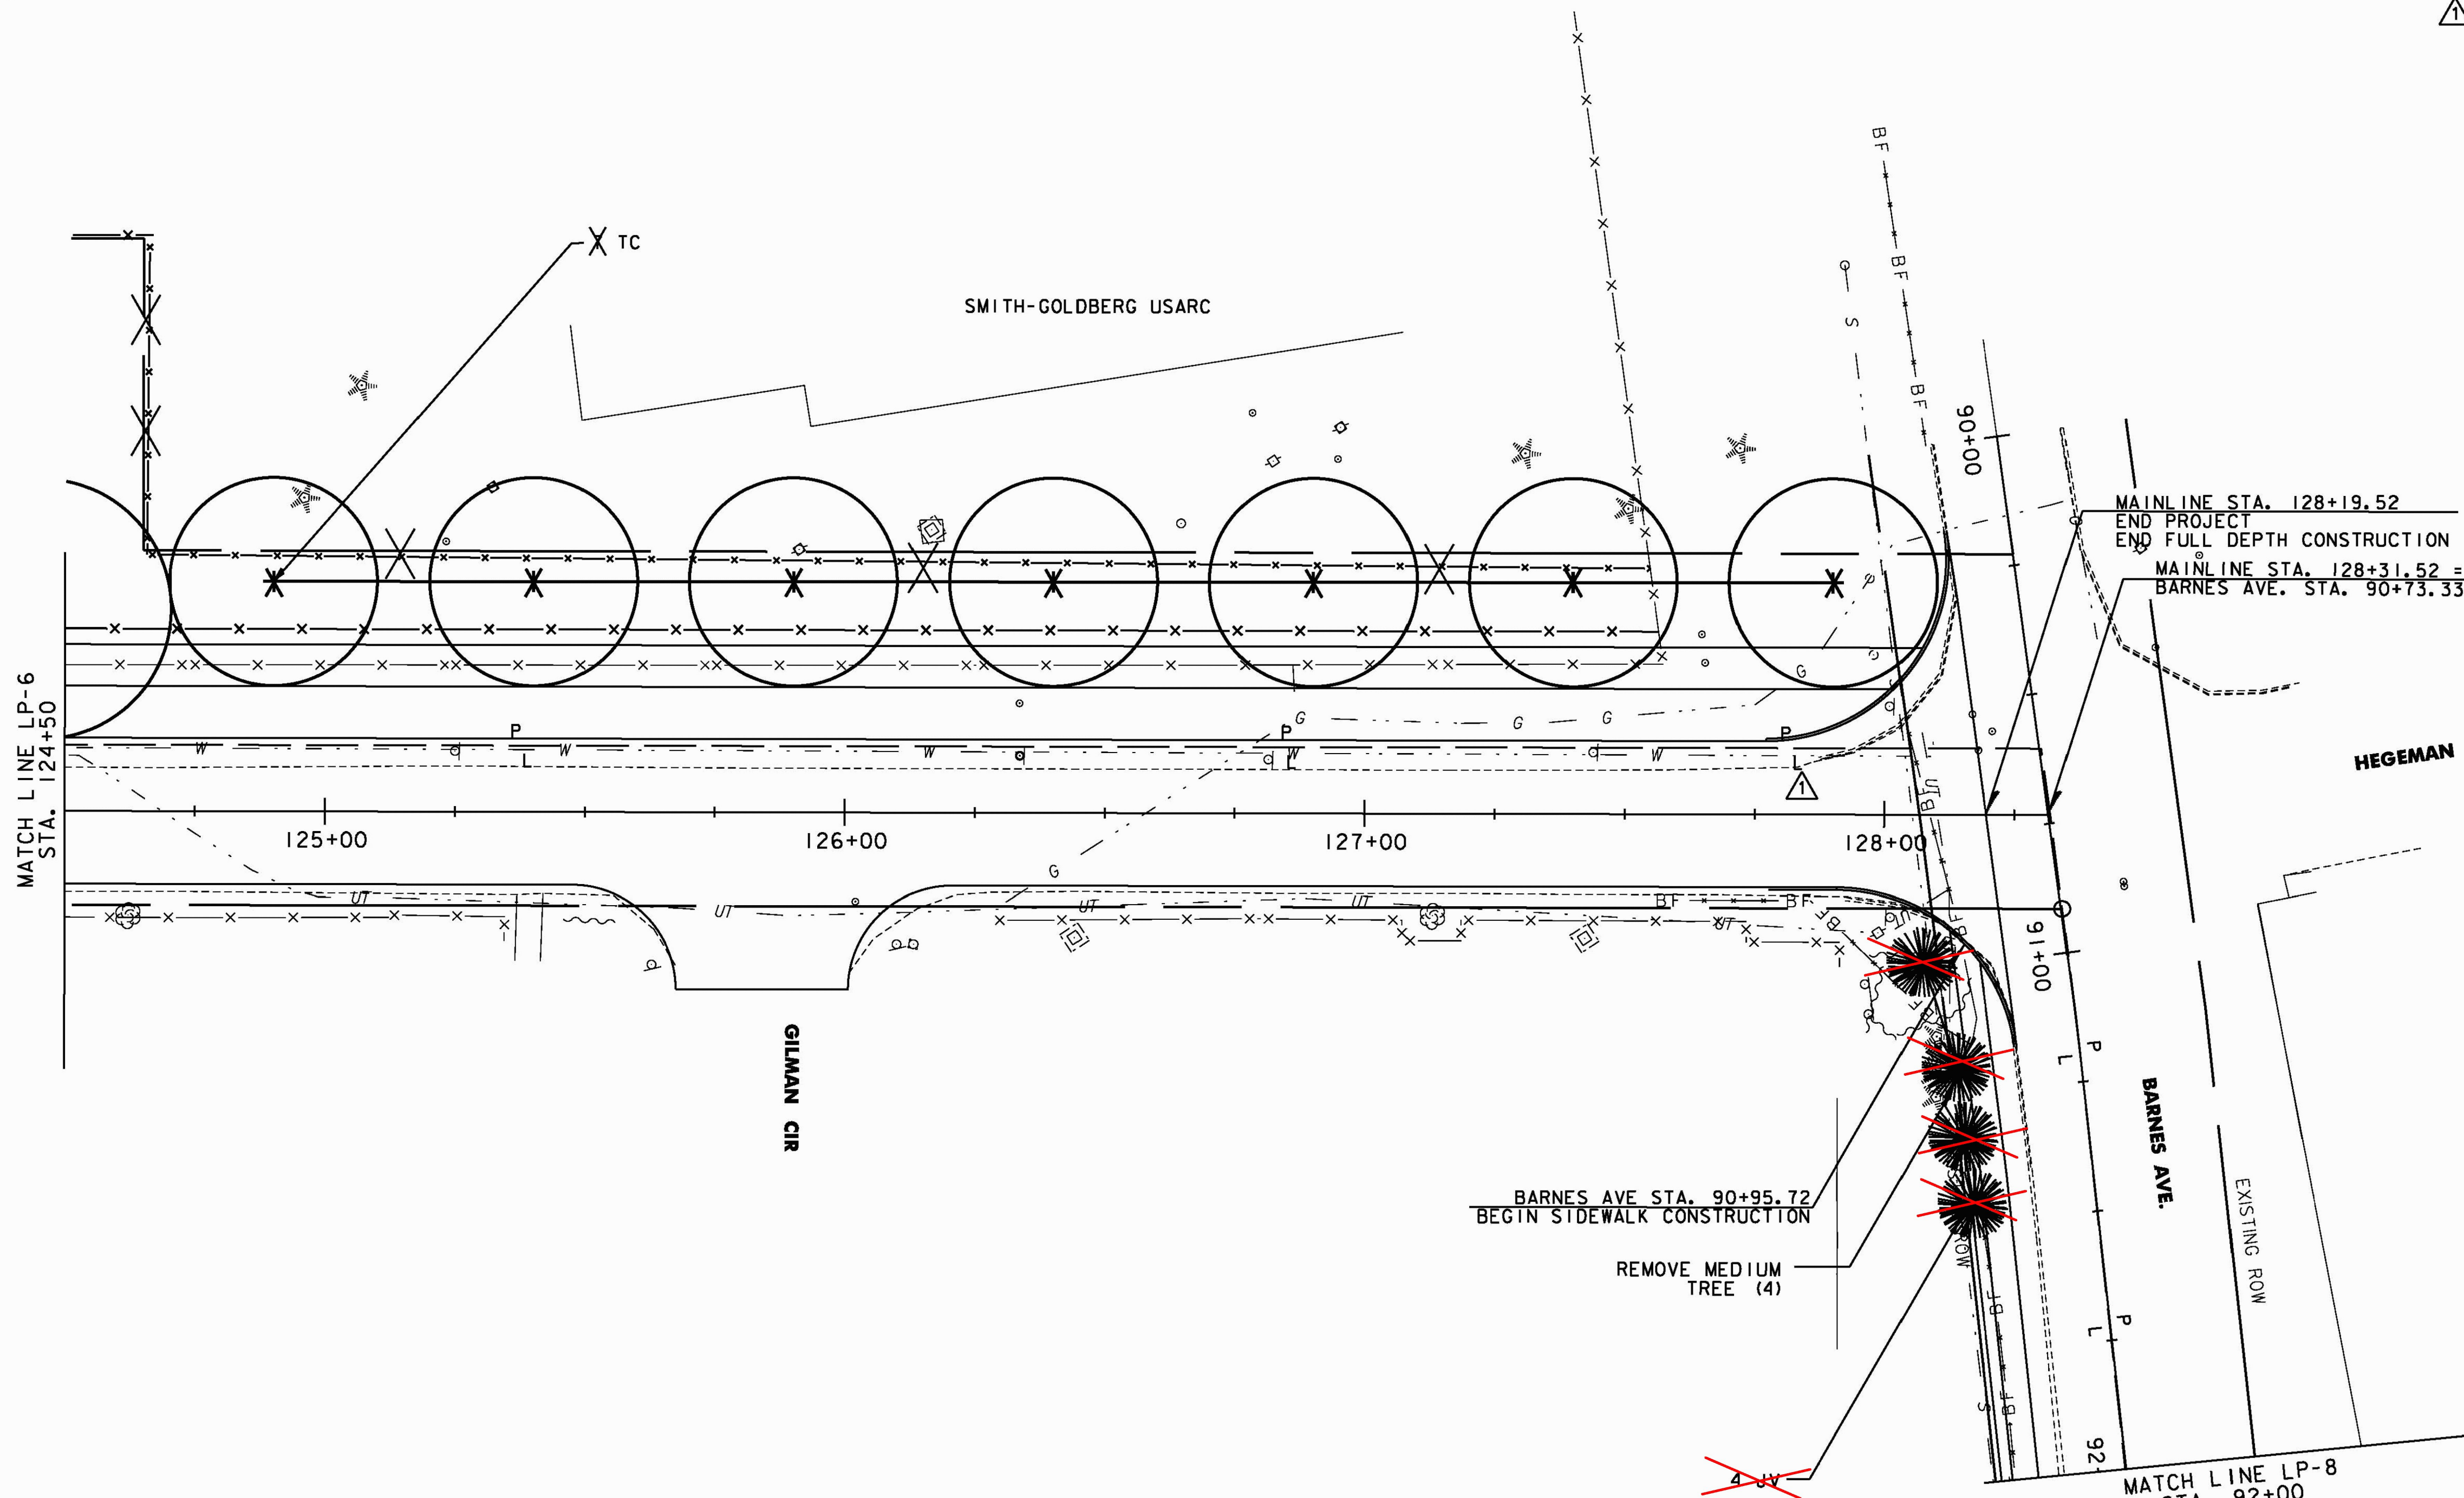


REMOVE MEDIUM TREE
 STA. 91+14, RT
 STA. 91+17, RT
 STA. 91+21, RT
 STA. 91+25, RT

- LEGEND
- DECIDUOUS TREE/SHRUB
 - EVERGREEN TREE
 - TREE PROTECTION ZONE (TPZ)
 - CLEARING LINE

- NOTES:
- SEE LANDSCAPING DETAIL LND-1 FOR GENERAL NOTES AND TREE PLANTING DETAILS.
 - THIN AND TRIM EXISTING TREES TO REMAIN, PER THE DECRETION OF THE RESIDENT ENGINEER. PAYMENT SHALL BE CONSIDERED INCIDENTAL TO ITEM 201.10 - CLEARING AND GRUBBING, INCLUDING INDIVIDUAL TREES AND STUMPS.

RECORD DRAWING
DATE: DECEMBER 21, 2012

REVISION	BY	DATE
ADDENDUM - 1	JBL	01/24/11

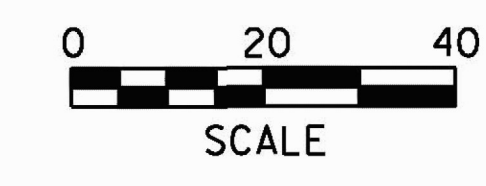

PROJECT NAME: COLCHESTER CAMPUS CONNECTOR	FILE NAME: ...101-108_Land.pxf	PLOT DATE: 9/7/2011
PROJECT NUMBER: TCSP TCSE (007)	PROJECT LEADER: JBL	DRAWN BY: PZA
	DESIGNED BY: TFD	CHECKED BY: GGG
	LANDSCAPING PLAN LP-7	SHEET 155 OF 155