


REMOVE MEDIUM TREE
STA. 93+56, RT

MATCH LINE LP-7
STA. 92+00

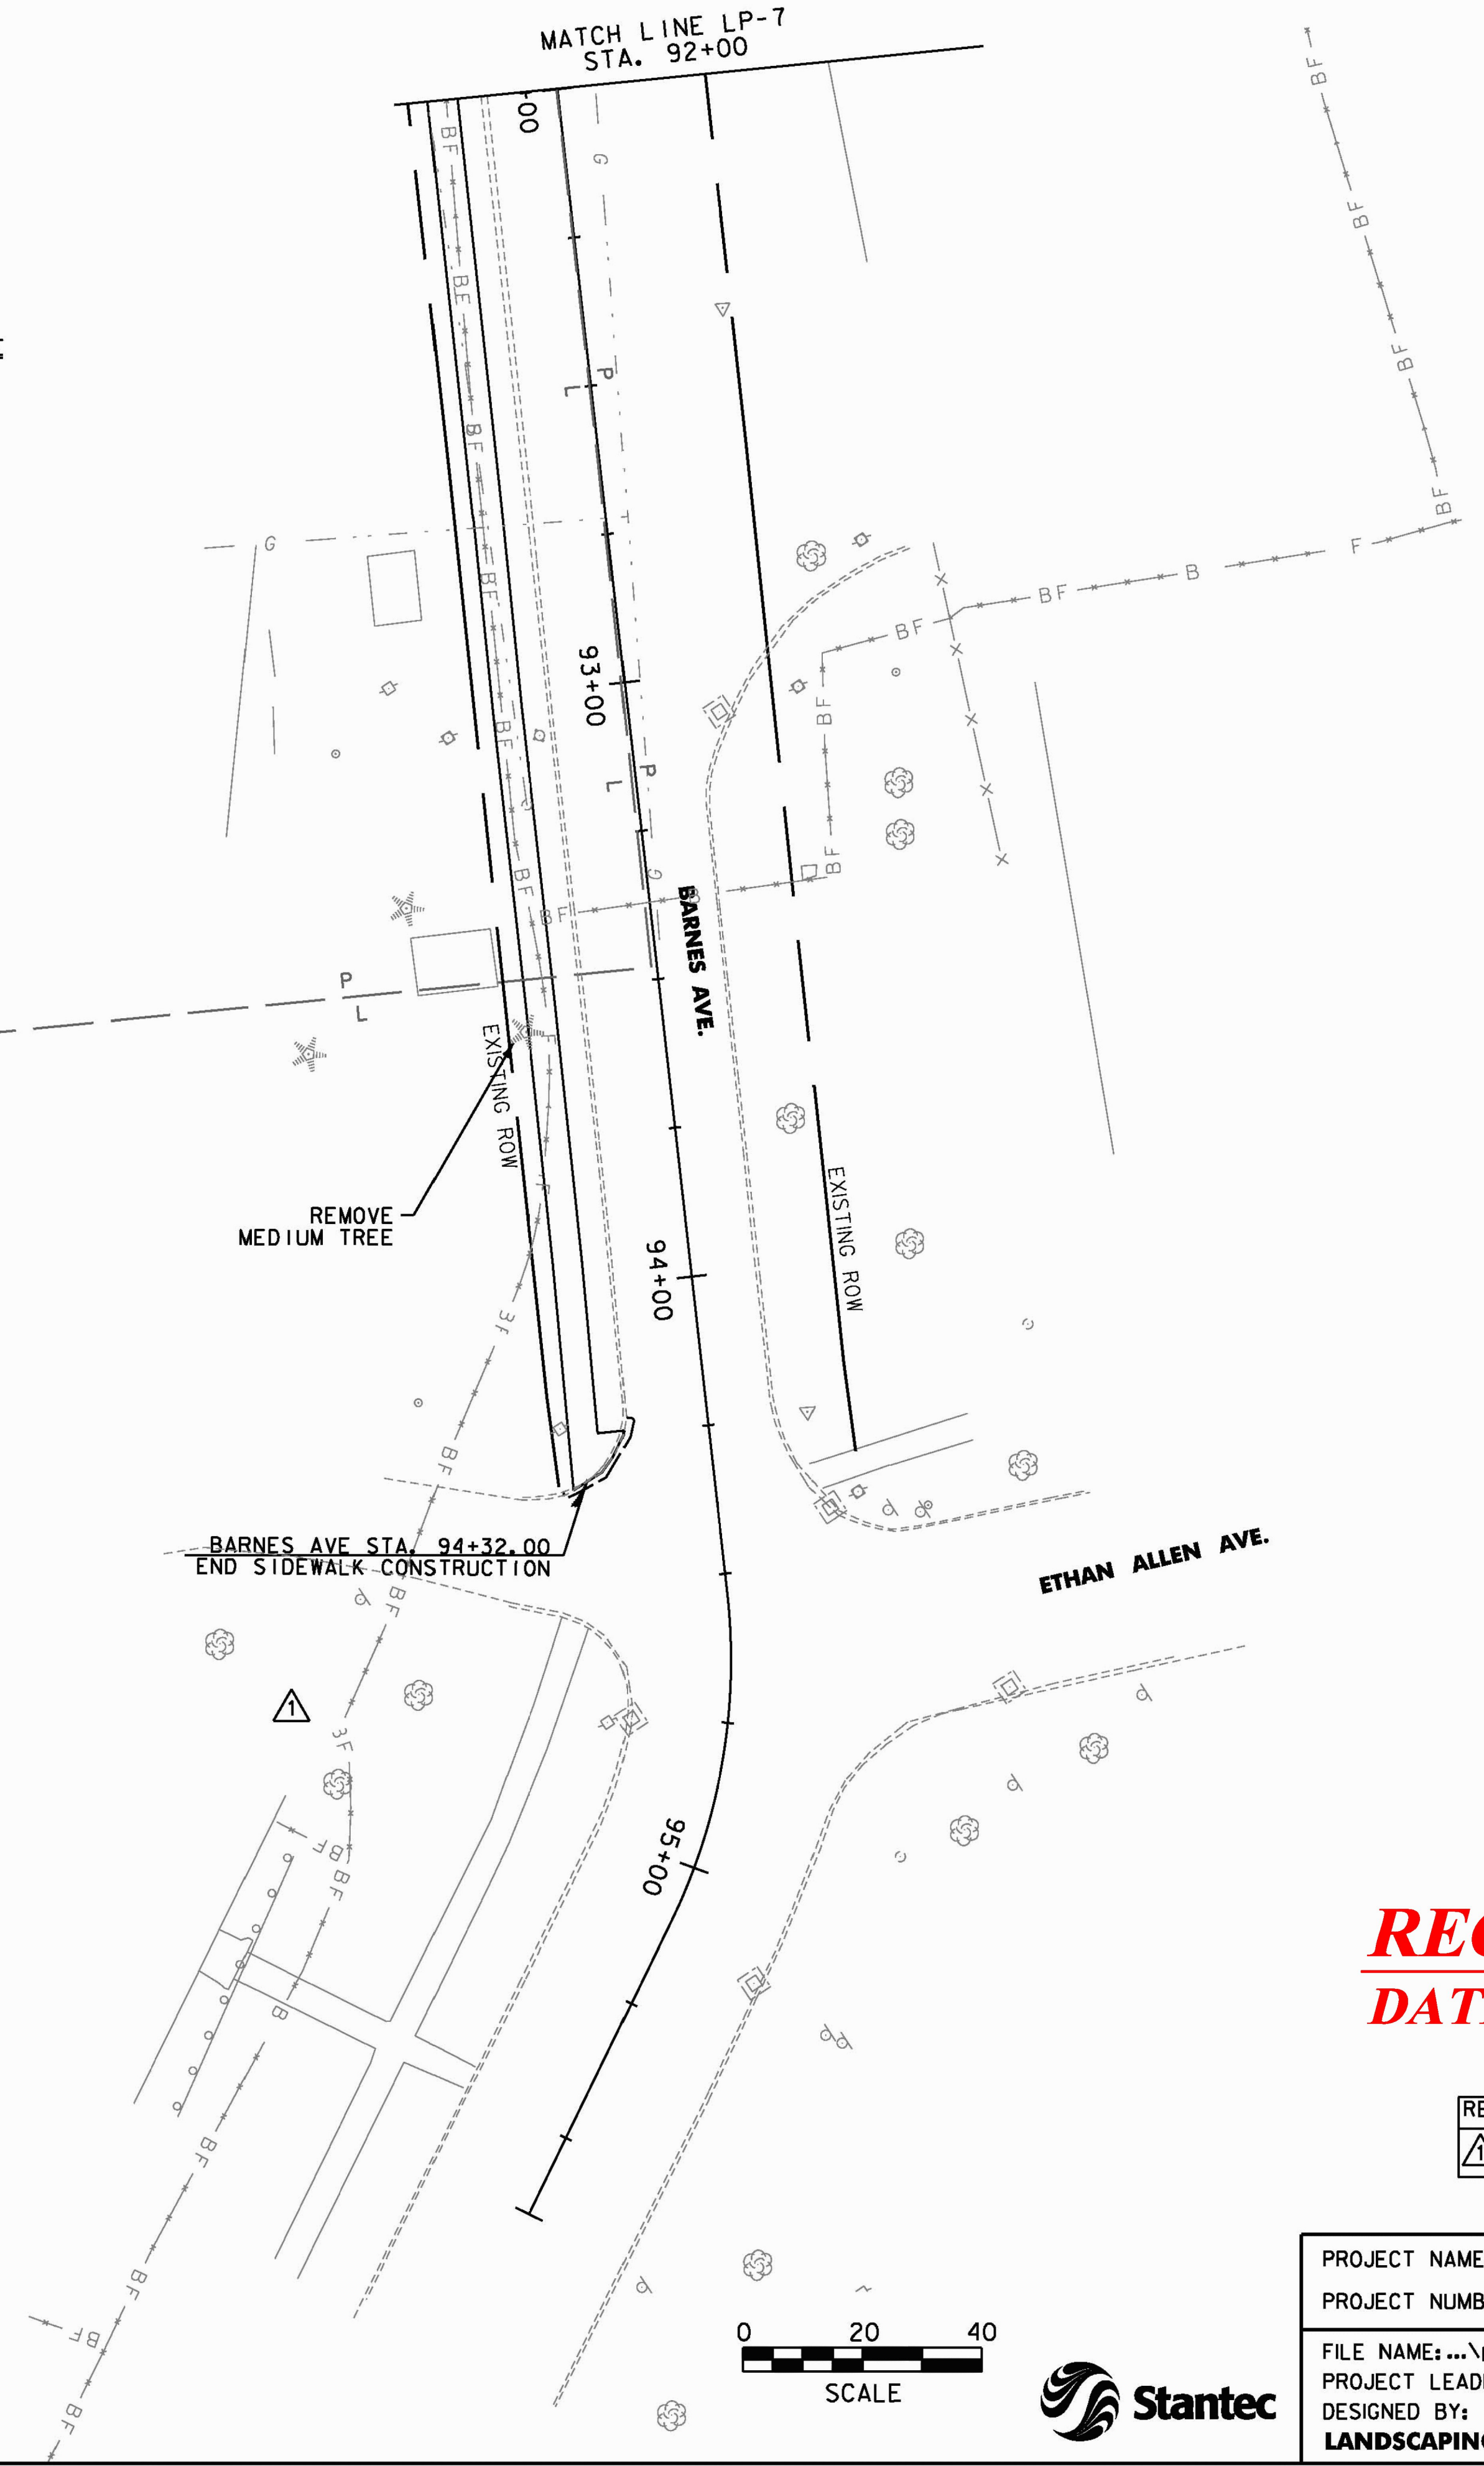


REMOVE MEDIUM TREE

BARNES AVE STA. 94+32.00
END SIDEWALK CONSTRUCTION

ETHAN ALLEN AVE.

RECORD DRAWING
DATE: DECEMBER 21, 2012

REVISION	BY	DATE
△ ADDENDUM - 1	JBL	01/24/11

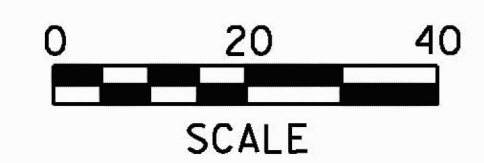

PROJECT NAME: COLCHESTER CAMPUS CONNECTOR	PLOT DATE: 4/22/2011
PROJECT NUMBER: TCSP TCSE (007)	DRAWN BY: PZA
FILE NAME: ...plotfiles\101-108_Land.ptf	CHECKED BY: GGG
DESIGNED BY: TFD	SHEET 104 OF 153
LANDSCAPING PLAN LP-8	